



CERTIFICATE OF AUTHENTICITY

THIS IS TO CERTIFY THAT THE FOLLOWING ELECTRONIC RECORDS ARE TRUE AND ACCURATE REPRODUCTIONS OF THE ORIGINAL RECORDS OF JAMES CITY COUNTY GENERAL SERVICES DEPARTMENT- STORMWATER DIVISION; WERE SCANNED IN THE REGULAR COURSE OF BUSINESS PURSUANT TO GUIDELINES ESTABLISHED BY THE LIBRARY OF VIRGINIA AND ARCHIVES; AND HAVE BEEN VERIFIED IN THE CUSTODY OF THE INDIVIDUAL LISTED BELOW.


BMP NUMBER: PC150

DATE VERIFIED: June 6, 2012

QUALITY ASSURANCE TECHNICIAN: Leah Hardenbergh

Leah Hardenbergh

LOCATION: WILLIAMSBURG, VIRGINIA

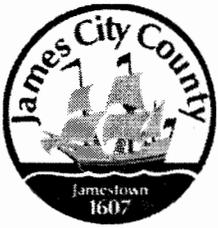

Stormwater Division

MEMORANDUM

DATE: February 24, 2010
TO: Michael J. Gillis, Virginia Correctional Enterprises Document Management Services
FROM: Jo Anna Ripley, Stormwater
PO: 270712
RE: Files Approved for Scanning

BMP ID or General File ID PC150

PIN: 3720200001B

Subdivision, Tract, Business or Owner

Name (if known):

Fords Colony

Property Description:

Blue Heron Course Holes 1-4 & 14-18

Site Address:

(For internal use only)

Box: FC001


Drawer: 1

Agreements: (in file as of scan date)

N Book or Doc#:

Page:

Comments:

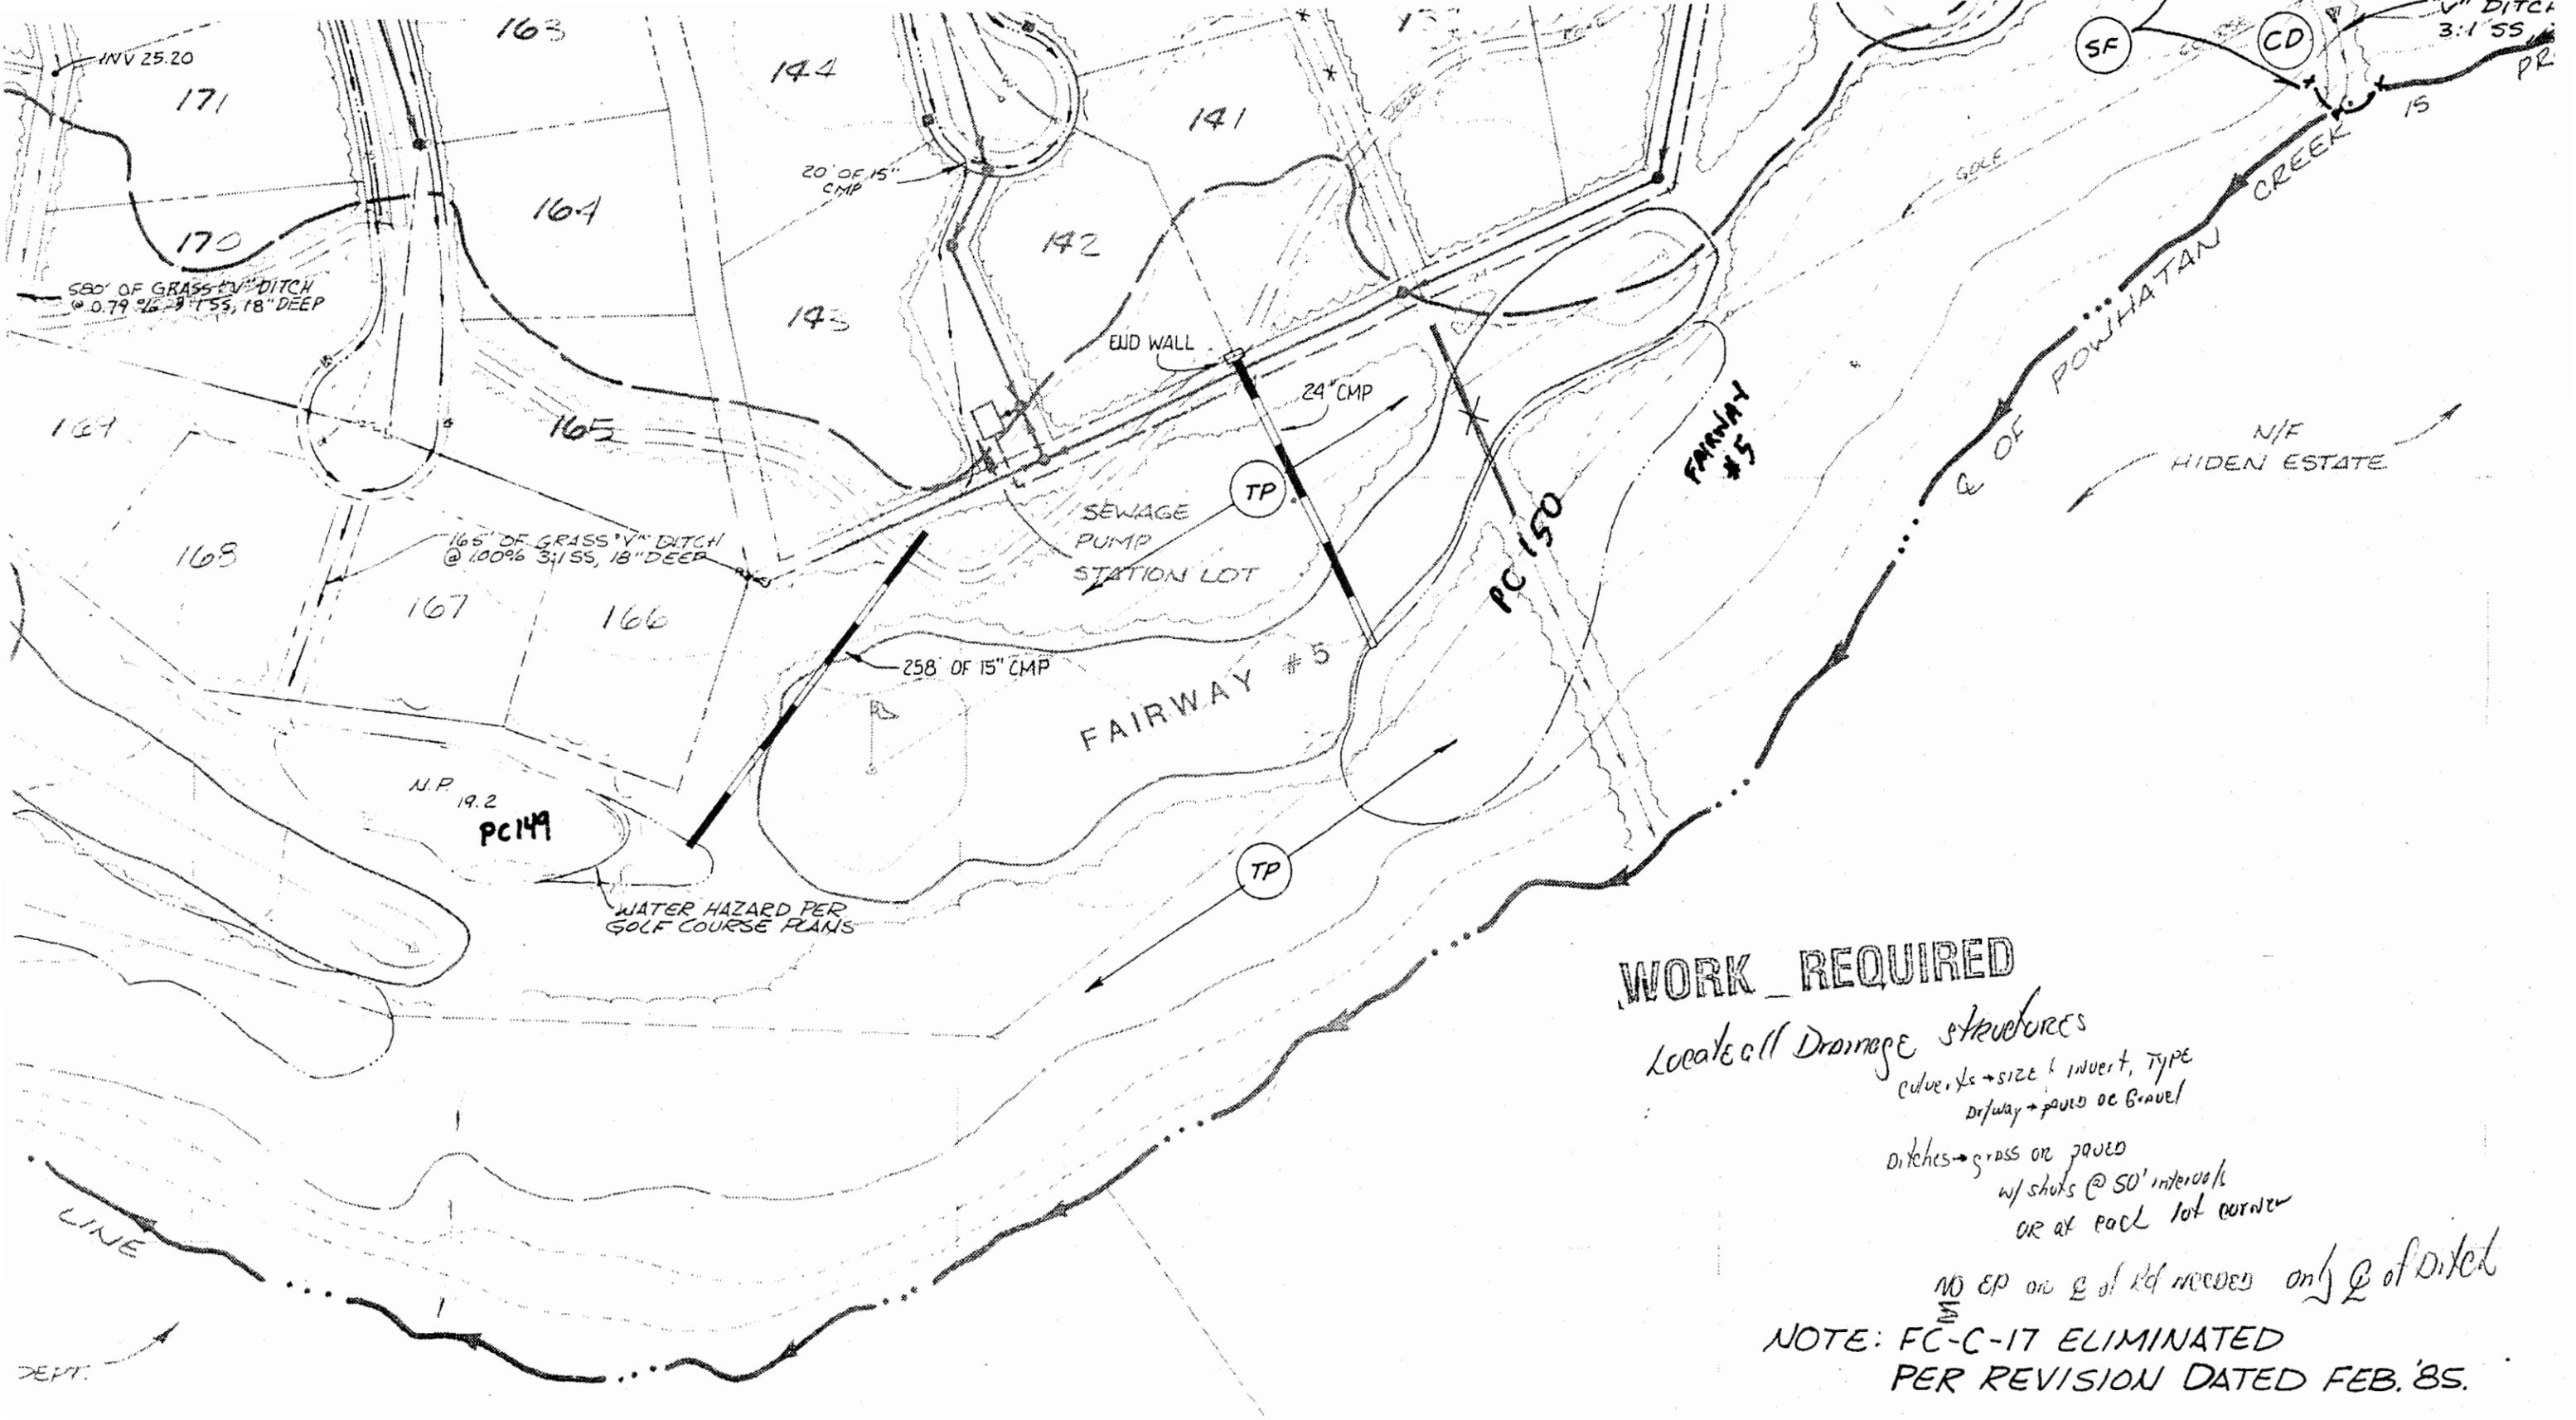

WORK REQUIRED

Locate all Drainage structures

Culverts → size & invert, type
 Drivway → paved or Gravel

Ditches → grass or paved
 w/ shots @ 50' intervals
 OR at each lot corner

NO EP on E of rd needed only E of Ditch

NOTE: FC-C-17 ELIMINATED
 PER REVISION DATED FEB. '85.



PC089

PC090

PC149

PC091

PC150

PC044

PC151