



CERTIFICATE OF AUTHENTICITY

THIS IS TO CERTIFY THAT THE FOLLOWING ELECTRONIC RECORDS ARE TRUE AND ACCURATE REPRODUCTIONS OF THE ORIGINAL RECORDS OF JAMES CITY COUNTY GENERAL SERVICES DEPARTMENT- STORMWATER DIVISION; WERE SCANNED IN THE REGULAR COURSE OF BUSINESS PURSUANT TO GUIDELINES ESTABLISHED BY THE LIBRARY OF VIRGINIA AND ARCHIVES; AND HAVE BEEN VERIFIED IN THE CUSTODY OF THE INDIVIDUAL LISTED BELOW.


BMP NUMBER: WC077

DATE VERIFIED: October 15, 2012

QUALITY ASSURANCE TECHNICIAN: Leah Hardenbergh

Leah Hardenbergh

LOCATION: WILLIAMSBURG, VIRGINIA

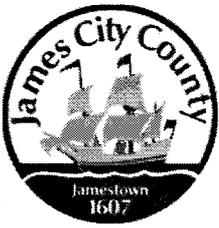

Stormwater Division

MEMORANDUM

DATE: March 12, 2010
TO: Michael J. Gillis, Virginia Correctional Enterprises Document Management Services
FROM: Jo Anna Ripley, Stormwater
PO: 270712
RE: Files Approved for Scanning

General File ID or BMP ID: WC077

PIN: 0520600001B

Subdivision, Tract, Business or Owner

Name (if known):

Stonehouse

Property Description:

Richardsons Mill Common Area Section 1

Site Address:

(For internal use only)

Box 22

Drawer: 9

Agreements: (in file as of scan date)

Y

Book or Doc#:

020031122

Page:

990026872

Comments

See as-built in WC078 BMP# 7.1

6. The COVENANTOR(S) shall indemnify and save the COUNTY harmless from any and all claims for damages to persons or property arising from the installation, construction, maintenance, repair, operation or use of the SYSTEM.


7. The COVENANTOR(s) shall promptly notify the COUNTY when the COVENANTOR(S) legally transfers any of the COVENANTOR(S)' responsibilities for the SYSTEM. The COVENANTOR(S)' shall supply the COUNTY with a copy of any document of transfer, executed by both parties.

8. The covenants contained herein shall run with the land and shall bind the COVENANTOR(S) and the COVENANTOR(S)' heirs, executors, administrators, successors and assignees, and shall bind all present and subsequent owners of property served by the SYSTEM.

9. This COVENANT shall be recorded in the County Land Records.

IN WITNESS WHEREOF, the COVENANTOR(S) have executed this DECLARATION OF COVENANTS as of the date first above written.


COVENANTOR(S)

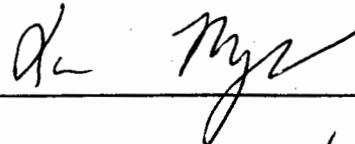

Print Name/Title

LAWRENCE MYERS / TREASURER

ATTEST:

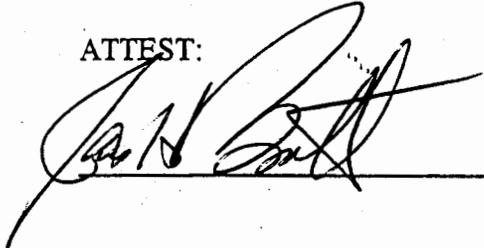

COVENANTOR(S)

Print Name/Title

ATTEST:

COMMONWEALTH OF VIRGINIA
CITY/COUNTY OF James City County

I hereby certify that on this 1 day of Oct., 2002, before the subscribed, a Notary Public of the State of Virginia, and for the City/County of James City Co., aforesaid personally appeared Lawrence O. Myers and did acknowledge the foregoing instrument to be their Act.

IN WITNESS WHEREOF, I have hereunto set my hand and official seal this 1 day of Oct, 2002.

Peggy B. Willis
Notary Public

My Commission expires: My Commission Expires September 30, 2006

Approved as to form:

J. Mumford
County Attorney

This Declaration of Covenants prepared by:

JAMES H. BENNETT
(Print Name)
V.P. DOMINION LAND
(Title)
9701 MILL POND RUN
(Address)
TOANO VA 23168
(City) (State) (Zip)

drainage.pre

 **COPY**

COUNTY OF JAMES CITY, VIRGINIA

DECLARATION OF COVENANTS

INSPECTION/MAINTENANCE OF DRAINAGE SYSTEM

THIS DECLARATION, made this ^{JHB} ~~6TH~~ ^{11TH} day of DECEMBER, 20 02,
between STONEHOUSE DEVELOPMENT COMPANY, LLC,
and all successors in interest, ("COVENANTOR(S),") owner(s) of the following property: STONEHOUSE DEVELOPMENT AREA ONE, PHASE I, SECTION VII-A, "RICHARDSON'S MILL" SECTION 2
project name, _____,
Document No. 990026872, Deed Book _____, Page No. _____; Instrument No. _____,
and the County of James City, Virginia ("COUNTY.")

WITNESSETH:

We, the COVENANTOR(S), with full authority to execute deeds, mortgages, other covenants, and all rights, titles and interests in the property described above, do hereby covenant with the COUNTY as follows:

1. The COVENANTOR(S) shall provide maintenance for the drainage system including any runoff control facilities, conveyance systems and associated easements, hereinafter referred to as the "SYSTEM," located on and serving the above-described property to ensure that the SYSTEM is and remains in proper working condition in accordance with approved design standards, and with the law and applicable executive regulations. The SYSTEM shall not include any elements located within any Virginia Department of Transportation rights-of-way.

2. If necessary, the COVENANTOR(S) shall levy regular or special assessments against all present or subsequent owners of property served by the SYSTEM to ensure that the SYSTEM is properly maintained.

3. The COVENANTOR(S) shall provide and maintain perpetual access from public right-of-ways to the SYSTEM for the COUNTY, its agent and its contractor.

4. The COVENANTOR(S) shall grant the COUNTY, its agent and its contractor a right of entry to the SYSTEM for the purpose of inspecting, operating, installing, constructing, reconstructing, maintaining or repairing the SYSTEM.

5. If, after reasonable notice by the COUNTY, the COVENANTOR(S) shall fail to maintain the SYSTEM in accordance with the approved design standards and with the law and applicable executive regulations, the COUNTY may perform all necessary repair or maintenance work, and the COUNTY may assess the COVENANTOR(S) and/or all property served by the SYSTEM for the cost of the work and any applicable penalties.

Instrument # 020031122

Page 1

Revised 01/02

Recorded Dec. 26, 2002

6. The COVENANTOR(S) shall indemnify and save the COUNTY harmless from any and all claims for damages to persons or property arising from the installation, construction, maintenance, repair, operation or use of the SYSTEM.

7. The COVENANTOR(s) shall promptly notify the COUNTY when the COVENANTOR(S) legally transfers any of the COVENANTOR(S)' responsibilities for the SYSTEM. The COVENANTOR(S)' shall supply the COUNTY with a copy of any document of transfer, executed by both parties.

8. The covenants contained herein shall run with the land and shall bind the COVENANTOR(S) and the COVENANTOR(S)' heirs, executors, administrators, successors and assignees, and shall bind all present and subsequent owners of property served by the SYSTEM.

9. This COVENANT shall be recorded in the County Land Records.


IN WITNESS WHEREOF, the COVENANTOR(S) have executed this DECLARATION OF COVENANTS as of the date first above written.

COVENANTOR(S)

Print Name/Title

ATTEST:


COVENANTOR(S)

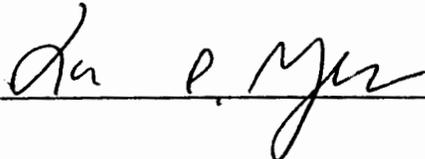

Print Name/Title

LAWRENCE O. MYERS

ATTEST:

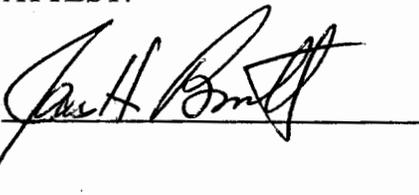

TREASURER

COMMONWEALTH OF VIRGINIA
CITY/COUNTY OF JAMES CITY

I hereby certify that on this 11th day of DECEMBER, 2002, before the subscribed, a Notary Public of the State of Virginia, and for the City/County of JAMES CITY, aforesaid personally appeared LAWRENCE O. ~~MEY~~ MERS and did acknowledge the foregoing instrument to be their Act.

IN WITNESS WHEREOF, I have hereunto set my hand and official seal this 11th day of DECEMBER, 2002.

Moona Janger
Notary Public

My Commission expires: MARCH 31, 2006

Approved as to form:

Lee P. Logan
County Attorney

This Declaration of Covenants prepared by:


JAMES H. BENNETT
(Print Name)

VICE PRESIDENT, DLAC
(Title)

120 TRADEGAR STREET
(Address)

RICHMOND VA 23219
(City) (State) (Zip)

drainage.pre

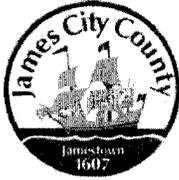


**James City County Environmental Division
Stormwater Management/BMP Record Drawing &
Construction Certification Review
Tracking Form**

Project Name: Stonehouse PA1 Sec 7-A Richardson Mill Pond Sec 1
 County Plan No.: S-99-01 / S-100-02
 Stormwater Management Facility: BMP # 7.2 Timber Wall
 BMP Phase #: I II III
 Information Package Received. Date/By: June 13 2006 AES
 Completeness Check:
 Record Drawing Date/By: 6/13/06 AES
 Construction Certification Date/By: 4/22/06 GET
 RD/CC Standard Forms (Required for all BMPs after Feb 1st 2001 Only)
 Insp/Maint Agreement # / Date: 020022966, Oct 7 2002
 BMP Maintenance Plan Location: _____
 Other: _____
 Standard E&SC Note on Approved Plan Requiring RD/CC or County comment in plan review
 Yes No Location: Note to sheet 16
 Assign County BMP ID Code #: Code: WC077
 Preliminary Input/Log into Division's "As-Built Tracking Log"
 Add Location to GIS Map. Obtain basic site information (GPIN, Owner, Address, etc.)
 Preliminary Log into Access Database (BMP ID #, Plan No., GPIN, Project Name, etc.)
 Active Project File Review (correspondence, H&H, design computations, etc.)
 Initial As-Built File setup (File label, folder, copy plan/details/design information, etc.)
 Inspector Check of RD/CC (forward to Inspector using transmittal for cursory review).
 Pre-Inspection Drawing Review of Approved Plan (Quick look prior to Field Inspection).
 Final Inspection (FI) Performed Date: 02/13/07 5/30/06 Reinspect
 Record Drawing (RD) Review Date: 02/13/07
 Construction Certification (CC) Review Date: 02/13/07
 Actions:
 No comments.
 Comments. Letter Forwarded. Date: _____
 Record Drawing (RD)
 Construction Certification (CC)
 Construction-Related (CR)
 Site Issues (SI)
 Other: Perm Req WAIVER
 Second Submission: _____
 Reinspection (if necessary): _____
 Acceptable for SWM Purposes (RD/CC/CR/Other). Ok to proceed with bond release.
 Complete "Surety Request Form".
 Check/Clean active file of any remaining material and finish "As-Built" file.
 Add to County BMP Inventory/Inspection schedule (Phase I, II or III).
 Copy Final Inspection Report into County BMP Inspection Program file.
 Obtain Digital Photographs of BMP and save into County BMP Inventory.
 Request mylar/reproducible from As-Built plan preparer.
 Complete "As-built Tracking Log".
 Last check of BMP Access Database (County BMP Inventory).
 Add BMP to JCC Hydrology & Hydraulic database (optional).
 Add BMP to Municipal BMP list (if a County-owned facility)
 Add BMP to PRIDE BMP ratings database.

Final Sign-Off

Plan Reviewer: _____ Date: _____

*** See separate checklist, if needed.

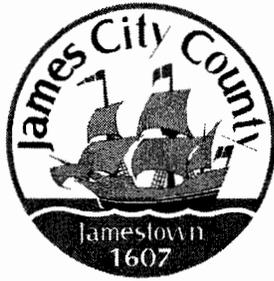

#7.2
WC077
5-99-01


James City County, Virginia
Environmental Division

**Stormwater Management / BMP Facilities
Record Drawing and Construction Certification**

Standard Forms & Instructions

<u>Contents</u>	Page
Record Drawing and Construction Certification Forms	
Section 1 – Site Information	1
Section 2 – Construction Information	2
Section 3 – Owner / Designer / Contractor Information	2
Section 4 – Professional Certifications	3
Section 5 – Certification Requirements and Instructions	4
Record Drawing Checklist	
I. Methods and Presentation (Required for All Facilities)	6
II. Minimum Standards (Required for All Facilities)	6
III. Group A – Wet Ponds	8
IV. Group B – Wetlands	9
V. Group C – Infiltration Practices	10
VI. Group D – Filtering Systems	11
VII. Group E – Open Channel Systems	12
VIII. Group F – Extended Dry Detention	13
IX. Group G – Open Spaces	14
X. Storm Drainage Systems (Associated with BMP's Only)	15
XII. Other Systems	15
XIII. References	16

*Issue Date
February 1, 2001*

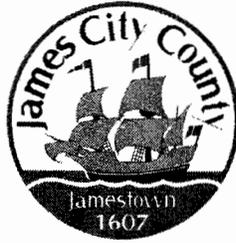

James City County, Virginia
Environmental Division

Stormwater Management / BMP Facilities
Record Drawing and Construction Certification Forms

(Note: In accordance with the requirements of the Chesapeake Bay Preservation Ordinance, Chapter 23, Section 23-10(4), BMP's shall be designed and constructed in accordance with the manual entitled James City County Guidelines for Design and Construction of Stormwater Management BMP's. Erosion and sediment control policy and approved plans generally require that at the completion of the project and prior to release of surety, an "as-built" plan prepared by a registered Professional Engineer or Certified Land Surveyor must be provided for the drainage system for the project, including any Best Management Practice (BMP) facilities. In addition, for BMP facilities involving the construction of an impounding structure or dam embankment, certification is required by a Professional Engineer who has inspected the structure during its construction. Currently there are over 20 water quality type BMP's accepted by the County.)

Section 1 – Site Information:

Project Name: Stonehouse - Section VII-A (Richardson's Mill Section 1)
Structure/BMP Name: BMP #7.2
Project Location: Stonehouse - Richardson's Mill
BMP Location: CA-45D (Behind lot 31 on Mill Pond Run)
County Plan No.: JCC Case No. S - 99 - 01

Project Type: Residential Business Tax Map/Parcel No.: (6-4) (1-1)
 Commercial Office BMP ID Code (if known): WC077
 Institutional Industrial Zoning District: PUD-R
 Public Roadway Land Use: Residential
 Other Site Area (sf or acres): 45.63

Brief Description of Stormwater Management/BMP Facility: Timber Structure

Nearest Visible Landmark to SWM/BMP Facility: Private drive at end of Mill Pond Run

Nearest Vertical Ground Control (if known):
 JCC Geodetic Ground Control USGS Temporary Arbitrary Other
Station Number or Name: 303
Datum or Reference Elevation: NGVD 1929
Control Description: NAD 27
Control Location from Subject Facility: 3.5 miles south

Section 2 – Stormwater Management / BMP Facility Construction Information:

PreConstruction Meeting Held for Construction of SWM/BMP Facility: Yes No Unknown
Approx. Construction Start Date for SWM/BMP Facility: November 2002
Facility Monitored by County Representative during Construction: Yes No Unknown
Name of Site Work Contractor Who Constructed Facility: George Nice & Sons, Inc.
Name of Professional Firm Who Routinely Monitored Construction: _____
Date of Completion for SWM/BMP Facility: _____
Date of Record Drawing/Construction Certification Submittal: 08/16/04

(Note: Record Drawing and Construction Certifications are required within thirty (30) days of the completion of Stormwater Management and/or BMP facility construction. Record Drawings and Construction Certifications must be reviewed and approved by the James City County Environmental Division prior to final inspection, acceptance and bond or surety release.)

Section 3 – Owner / Designer / Contractor Information:

Owner/Developer: *(Note: Site Owner or Applicant responsible for development of the project.)*

Name: Stonehouse Development Company
Mailing Address: 9701 Mill Pond Run
Toano, VA 23168
Business Phone: 757-234-5000 Fax: 757-234-5091
Contact Person: Jerry Moore Title: President

Design Professional: *(Note: Professional Engineer or Certified Land Surveyor responsible for the design and preparation of plans and specifications for the Stormwater Management / BMP facility.)*

Firm Name: AES Consulting Engineers
Mailing Address: 5248 Olde Towne Road, Suite 1
Williamsburg, VA 23188
Business Phone: 757-253-0040
Fax: 757-220.8994
Responsible Plan Preparer: Marc Bennett
Title: Senior Project Manager
Stonehouse - Development Area One, Phase 1- Section VII-A, "Richardson's Mill" -
Plan Name: Section 1
Firm's Project No. 9028-08
Plan Date: October 26, 2001
Sheet No.'s Applicable to SWM/BMP Facility: 9 / 14 / / /

BMP Contractor: *(Note: Site Work Contractor directly responsible for construction of the Stormwater Management / BMP facility.)*

Name: George Nice & Sons, Inc.
Mailing Address: 143 Skimino Road
Williamsburg, VA 23188-2229
Business Phone: (757) 565-2885
Fax: (757) 565-1526
Contact Person: Ray Nice
Site Foreman/Supervisor: _____
Specialty Subcontractors & Purpose (for BMP Construction Only):

Section 4 – Professional Certifications:


Certifying Professionals: *(Note: A Registered Professional Engineer or Certified Land Surveyor is responsible for preparation of a Record Drawing, sometimes referred to as an As-Built plan, for the drainage system for the project including any Stormwater Management/BMP Facilities. A Registered Professional Engineer is responsible for the inspection, monitoring and certification of Stormwater Management / BMP facilities during its construction.)*

Record Drawing and Construction Certifications for Stormwater Management / BMP Facilities

Record Drawing Certification

Firm Name: AES Consulting Engineers
Mailing Address: 5248 Olde Towne Road, Suite 1
Williamsburg, VA 23188
Business Phone: 757-253-0040
Fax: 757-220-8994

Name: Marc Bennett
Title: Senior Project Manager

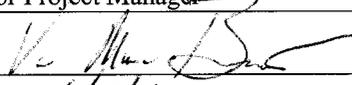Signature: 
Date: 6/13/06

I hereby certify to the best of my knowledge and belief that this record drawing represents the actual condition of the Stormwater Management / BMP facility. The facility appears to conform with the provisions of the approved design plan, specifications and stormwater management plan, except as specifically noted.

Construction Certification

Firm Name: _____
Mailing Address: _____
Business Phone: _____
Fax: _____

Name: _____
Title: _____

Signature: _____
Date: _____

I hereby certify to the best of my knowledge and belief that this Stormwater Management / BMP facility was monitored and constructed in accordance with the provisions of the approved design plan, specifications and stormwater management plan, except as specifically noted.



 (Seal)

Virginia Registered Professional Engineer
Or Certified Land Surveyor

_____ (Seal)

Virginia Registered
Professional Engineer

WC-077 - FINAL



James City County, Virginia
Environmental Division

**Stormwater Management / BMP Facilities
Record Drawing and Construction Certification**

Standard Forms & Instructions

<u>Contents</u>		Page
Record Drawing and Construction Certification Forms		
	Section 1 – Site Information	1
	Section 2 – Construction Information	2
	Section 3 – Owner / Designer / Contractor Information	2
	Section 4 – Professional Certifications	3
	Section 5 – Certification Requirements and Instructions	4
Record Drawing Checklist		
I.	Methods and Presentation (Required for All Facilities)	6
II.	Minimum Standards (Required for All Facilities)	6
III.	Group A – Wet Ponds	8
IV.	Group B – Wetlands	9
V.	Group C – Infiltration Practices	10
VI.	Group D – Filtering Systems	11
VII.	Group E – Open Channel Systems	12
VIII.	Group F – Extended Dry Detention	13
IX.	Group G – Open Spaces	14
X.	Storm Drainage Systems (Associated with BMP's Only)	15
XII.	Other Systems	15
XIII.	References	16

*Issue Date
February 1, 2001*



**James City County, Virginia
Environmental Division**

**Stormwater Management / BMP Facilities
Record Drawing and Construction Certification Forms**

(Note: In accordance with the requirements of the Chesapeake Bay Preservation Ordinance, Chapter 23, Section 23-10(4), BMP's shall be designed and constructed in accordance with the manual entitled James City County Guidelines for Design and Construction of Stormwater Management BMP's. Erosion and sediment control policy and approved plans generally require that at the completion of the project and prior to release of surety, an "as-built" plan prepared by a registered Professional Engineer or Certified Land Surveyor must be provided for the drainage system for the project, including any Best Management Practice (BMP) facilities. In addition, for BMP facilities involving the construction of an impounding structure or dam embankment, certification is required by a Professional Engineer who has inspected the structure during its construction. Currently there are over 20 water quality type BMP's accepted by the County.)

Section 1 – Site Information:

Project Name: Stonehouse - Section VII-A (Richardson's Mill Section 1)
 Structure/BMP Name: BMP #7.2
 Project Location: Stonehouse - Richardson's Mill
 BMP Location: CA-45D (Behind lot 31 on Mill Pond Run)
 County Plan No.: JCC Case No. S - 99 - 01

Project Type: Residential Business Tax Map/Parcel No.: (6-4) (1-1)
 Commercial Office BMP ID Code (if known): WC077
 Institutional Industrial Zoning District: PUD-R
 Public Roadway Land Use: Residential
 Other _____ Site Area (sf or acres): 45.63

Brief Description of Stormwater Management/BMP Facility: Timber Structure

Nearest Visible Landmark to SWM/BMP Facility: Private drive at end of Mill Pond Run

Nearest Vertical Ground Control (if known):
 JCC Geodetic Ground Control USGS Temporary Arbitrary Other
 Station Number or Name: 303
 Datum or Reference Elevation: NGVD 1929
 Control Description: NAD 27
 Control Location from Subject Facility: 3.5 miles south

Section 2 – Stormwater Management / BMP Facility Construction Information:

PreConstruction Meeting Held for Construction of SWM/BMP Facility: Yes No Unknown
Approx. Construction Start Date for SWM/BMP Facility: November 2002
Facility Monitored by County Representative during Construction: Yes No Unknown
Name of Site Work Contractor Who Constructed Facility: George Nice & Sons, Inc.
Name of Professional Firm Who Routinely Monitored Construction: _____
Date of Completion for SWM/BMP Facility: _____
Date of Record Drawing/Construction Certification Submittal: 08/16/04

(Note: Record Drawing and Construction Certifications are required within thirty (30) days of the completion of Stormwater Management and/or BMP facility construction. Record Drawings and Construction Certifications must be reviewed and approved by the James City County Environmental Division prior to final inspection, acceptance and bond or surety release.)

Section 3 – Owner / Designer / Contractor Information:

Owner/Developer: *(Note: Site Owner or Applicant responsible for development of the project.)*

Name: Stonehouse Development Company
Mailing Address: 9701 Mill Pond Run
Toano, VA 23168
Business Phone: 757-234-5000 Fax: 757-234-5091
Contact Person: Jerry Moore Title: President

Design Professional: *(Note: Professional Engineer or Certified Land Surveyor responsible for the design and preparation of plans and specifications for the Stormwater Management / BMP facility.)*

Firm Name: AES Consulting Engineers
Mailing Address: 5248 Olde Towne Road, Suite 1
Williamsburg, VA 23188
Business Phone: 757-253-0040
Fax: 757-220.8994
Responsible Plan Preparer: Marc Bennett
Title: Senior Project Manager
Stonehouse - Development Area One, Phase 1- Section VII-A, "Richardson's Mill" -
Plan Name: Section 1
Firm's Project No. 9028-08
Plan Date: October 26, 2001
Sheet No.'s Applicable to SWM/BMP Facility: 9 / 14 / _____ / _____ / _____

BMP Contractor: *(Note: Site Work Contractor directly responsible for construction of the Stormwater Management / BMP facility.)*

Name: George Nice & Sons, Inc.
Mailing Address: 143 Skimino Road
Williamsburg, VA 23188-2229
Business Phone: (757) 565-2885
Fax: (757) 565-1526
Contact Person: Ray Nice
Site Foreman/Supervisor: _____
Specialty Subcontractors & Purpose (for BMP Construction Only): _____


Section 4 – Professional Certifications:

Certifying Professionals: *(Note: A Registered Professional Engineer of Certified Land Surveyor is responsible for preparation of a Record Drawing, sometimes referred to as an As-Built plan, for the drainage system for the project including any Stormwater Management/BMP Facilities. A Registered Professional Engineer is responsible for the inspection, monitoring and certification of Stormwater Management / BMP facilities during its construction.)*

Record Drawing and Construction Certifications for Stormwater Management / BMP Facilities

Record Drawing Certification

Firm Name: AES Consulting Engineers
Mailing Address: 5248 Olde Towne Road, Suite 1
Williamsburg, VA 23188
Business Phone: 757-253-0040
Fax: 757-220-8994

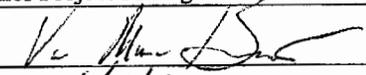Name: Marc Bennett
Title: Senior Project Manager
Signature: 
Date: 6/13/06

I hereby certify to the best of my knowledge and belief that this record drawing represents the actual condition of the Stormwater Management / BMP facility. The facility appears to conform with the provisions of the approved design plan, specifications and stormwater management plan, except as specifically noted.

Construction Certification

Firm Name: _____
Mailing Address: _____
Business Phone: _____
Fax: _____

Name: _____
Title: _____
Signature: _____
Date: _____

I hereby certify to the best of my knowledge and belief that this Stormwater Management / BMP facility was monitored and constructed in accordance with the provisions of the approved design plan, specifications and stormwater management plan, except as specifically noted.



 (Seal)

Virginia Registered Professional Engineer
Or Certified Land Surveyor

(Seal)

Virginia Registered
Professional Engineer

WC077

VOID



**James City County, Virginia
Environmental Division**

**Stormwater Management / BMP Facilities
Record Drawing and Construction Certification**

Standard Forms & Instructions

<u>Contents</u>		Page
Record Drawing and Construction Certification Forms		
	Section 1 – Site Information	1
	Section 2 – Construction Information	2
	Section 3 – Owner / Designer / Contractor Information	2
	Section 4 – Professional Certifications	3
	Section 5 – Certification Requirements and Instructions	4
Record Drawing Checklist		
I.	Methods and Presentation (Required for All Facilities)	6
II.	Minimum Standards (Required for All Facilities)	6
III.	Group A – Wet Ponds	8
IV.	Group B – Wetlands	9
V.	Group C – Infiltration Practices	10
VI.	Group D – Filtering Systems	11
VII.	Group E – Open Channel Systems	12
VIII.	Group F – Extended Dry Detention	13
IX.	Group G – Open Spaces	14
X.	Storm Drainage Systems (Associated with BMP's Only)	15
XII.	Other Systems	15
XIII.	References	16

*Issue Date
February 1, 2001*



James City County, Virginia
Environmental Division

**Stormwater Management / BMP Facilities
Record Drawing and Construction Certification Forms**

(Note: In accordance with the requirements of the Chesapeake Bay Preservation Ordinance, Chapter 23, Section 23-10(4), BMP's shall be designed and constructed in accordance with the manual entitled James City County Guidelines for Design and Construction of Stormwater Management BMP's. Erosion and sediment control policy and approved plans generally require that at the completion of the project and prior to release of surety, an "as-built" plan prepared by a registered Professional Engineer or Certified Land Surveyor must be provided for the drainage system for the project, including any Best Management Practice (BMP) facilities. In addition, for BMP facilities involving the construction of an impounding structure or dam embankment, certification is required by a Professional Engineer who has inspected the structure during its construction. Currently there are over 20 water quality type BMP's accepted by the County.)

Section 1 – Site Information:

Project Name: Stonehouse - Section VII-A (Richardson's Mill Section 1)
Structure/BMP Name: BMP #7.2
Project Location: Stonehouse - Richardson's Mill
BMP Location: CA-45D (Behind lot 31 on Mill Pond Run)
County Plan No.: JCC Case No. S - 99 - 01

Project Type:	<input checked="" type="checkbox"/> Residential	<input type="checkbox"/> Business	Tax Map/Parcel No.:	<u>(6-4) (1-1)</u>
	<input type="checkbox"/> Commercial	<input type="checkbox"/> Office	BMP ID Code (if known):	<u>WC077</u>
	<input type="checkbox"/> Institutional	<input type="checkbox"/> Industrial	Zoning District:	<u>PUD-R</u>
	<input type="checkbox"/> Public	<input type="checkbox"/> Roadway	Land Use:	<u>Residential</u>
	<input type="checkbox"/> Other _____		Site Area (sf or acres):	<u>45.63</u>

Brief Description of Stormwater Management/BMP Facility: Timber Structure

Nearest Visible Landmark to SWM/BMP Facility: Private drive at end of Mill Pond Run

Nearest Vertical Ground Control (if known):
 JCC Geodetic Ground Control USGS Temporary Arbitrary Other
Station Number or Name: 303
Datum or Reference Elevation: NGVD 1929
Control Description: NAD 27
Control Location from Subject Facility: 3.5 miles south

Section 2 – Stormwater Management / BMP Facility Construction Information:

PreConstruction Meeting Held for Construction of SWM/BMP Facility: Yes No Unknown
Approx. Construction Start Date for SWM/BMP Facility: November 2002
Facility Monitored by County Representative during Construction: Yes No Unknown
Name of Site Work Contractor Who Constructed Facility: George Nice & Sons, Inc.
Name of Professional Firm Who Routinely Monitored Construction: _____
Date of Completion for SWM/BMP Facility: _____
Date of Record Drawing/Construction Certification Submittal: 08/16/04

(Note: Record Drawing and Construction Certifications are required within thirty (30) days of the completion of Stormwater Management and/or BMP facility construction. Record Drawings and Construction Certifications must be reviewed and approved by the James City County Environmental Division prior to final inspection, acceptance and bond or surety release.)

Section 3 – Owner / Designer / Contractor Information:

Owner/Developer: *(Note: Site Owner or Applicant responsible for development of the project.)*

Name: Stonehouse Development Company
Mailing Address: 9701 Mill Pond Run
Toano, VA 23168
Business Phone: 757-234-5000 Fax: 757-234-5091
Contact Person: Jerry Moore Title: President

Design Professional: *(Note: Professional Engineer or Certified Land Surveyor responsible for the design and preparation of plans and specifications for the Stormwater Management / BMP facility.)*

Firm Name: AES Consulting Engineers
Mailing Address: 5248 Olde Towne Road, Suite 1
Williamsburg, VA 23188
Business Phone: 757-253-0040
Fax: 757-220.8994
Responsible Plan Preparer: Marc Bennett
Title: Senior Project Manager
Stonehouse - Development Area One, Phase 1- Section VII-A, "Richardson's Mill" -
Plan Name: Section 1
Firm's Project No. 9028-08
Plan Date: October 26, 2001
Sheet No.'s Applicable to SWM/BMP Facility: 9 / 14 / _____ / _____ / _____

BMP Contractor: *(Note: Site Work Contractor directly responsible for construction of the Stormwater Management / BMP facility.)*

Name: George Nice & Sons, Inc.
Mailing Address: 143 Skimino Road
Williamsburg, VA 23188-2229
Business Phone: (757) 565-2885
Fax: (757) 565-1526
Contact Person: Ray Nice
Site Foreman/Supervisor: _____
Specialty Subcontractors & Purpose (for BMP Construction Only):

Section 4 – Professional Certifications:


Certifying Professionals: *(Note: A Registered Professional Engineer of Certified Land Surveyor is responsible for preparation of a Record Drawing, sometimes referred to as an As-Built plan, for the drainage system for the project including any Stormwater Management/BMP Facilities. A Registered Professional Engineer is responsible for the inspection, monitoring and certification of Stormwater Management / BMP facilities during its construction.)*

Record Drawing and Construction Certifications for Stormwater Management / BMP Facilities

Record Drawing Certification

Firm Name: AES Consulting Engineers
Mailing Address: 5248 Olde Towne Road, Suite 1
Williamsburg, VA 23188
Business Phone: 757-253-0040
Fax: 757-220-8994

Name: Marc Bennett
Title: Senior Project Manager

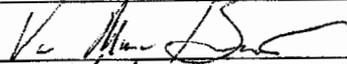Signature: 
Date: 6/13/06

I hereby certify to the best of my knowledge and belief that this record drawing represents the actual condition of the Stormwater Management / BMP facility. The facility appears to conform with the provisions of the approved design plan, specifications and stormwater management plan, except as specifically noted.

Construction Certification

Firm Name: _____
Mailing Address: _____
Business Phone: _____
Fax: _____

Name: _____
Title: _____

Signature: _____
Date: _____

I hereby certify to the best of my knowledge and belief that this Stormwater Management / BMP facility was monitored and constructed in accordance with the provisions of the approved design plan, specifications and stormwater management plan, except as specifically noted.



 (Seal)

Virginia Registered Professional Engineer
Or Certified Land Surveyor

(Seal)

Virginia Registered
Professional Engineer

NOTE:
UNLESS OTHERWISE
NOTED ALL RCP SHALL
BE CLASS III

STORM SYSTEM No. 5

SS#5-3
STA. 101+64, 37' LT.
VDOT STD DI-5
TYPE III GRATE
FLOWLINE INV=93.30
INV=87.05'
8" OF 15" RCP
(CL.II) @ 1.00%

SS#5-2
STA. 101+39, 24' RT.
VDOT STD DI-5
TYPE III GRATE
FLOWLINE INV=92.00
INV=86.39'

SS#5-1
STA. 104+47, 17' RT.
VDOT STD DI-5
TYPE III GRATE
FLOWLINE INV=86.00
INV=81.00'

SS#5-4
STA. 112+30
VDOT STD DI-5
TYPE III GRATE
FLOWLINE INV=48.32
INV=45.99'

SS#5-5
STA. 111+00
VDOT STD DI-5
TYPE III GRATE
FLOWLINE INV=50.50
INV=45.63'

SS#5-6
STA. 109+50
VDOT STD DI-5
TYPE III GRATE
FLOWLINE INV=55.36
INV=41.08'

SS#5-7
STA. 108+50
VDOT STD DI-5
TYPE III GRATE
FLOWLINE INV=55.36
INV=41.08'




SS#5-8
STA. 107+50
VDOT STD DI-5
TYPE III GRATE
FLOWLINE INV=55.36
INV=41.08'

SS#5-9
STA. 106+50
VDOT STD DI-5
TYPE III GRATE
FLOWLINE INV=55.36
INV=41.08'

SS#5-10
STA. 105+50
VDOT STD DI-5
TYPE III GRATE
FLOWLINE INV=55.36
INV=41.08'

SS#5-11
STA. 104+50
VDOT STD DI-5
TYPE III GRATE
FLOWLINE INV=55.36
INV=41.08'

SS#5-12
STA. 103+50
VDOT STD DI-5
TYPE III GRATE
FLOWLINE INV=55.36
INV=41.08'

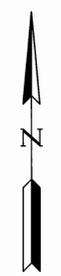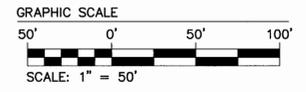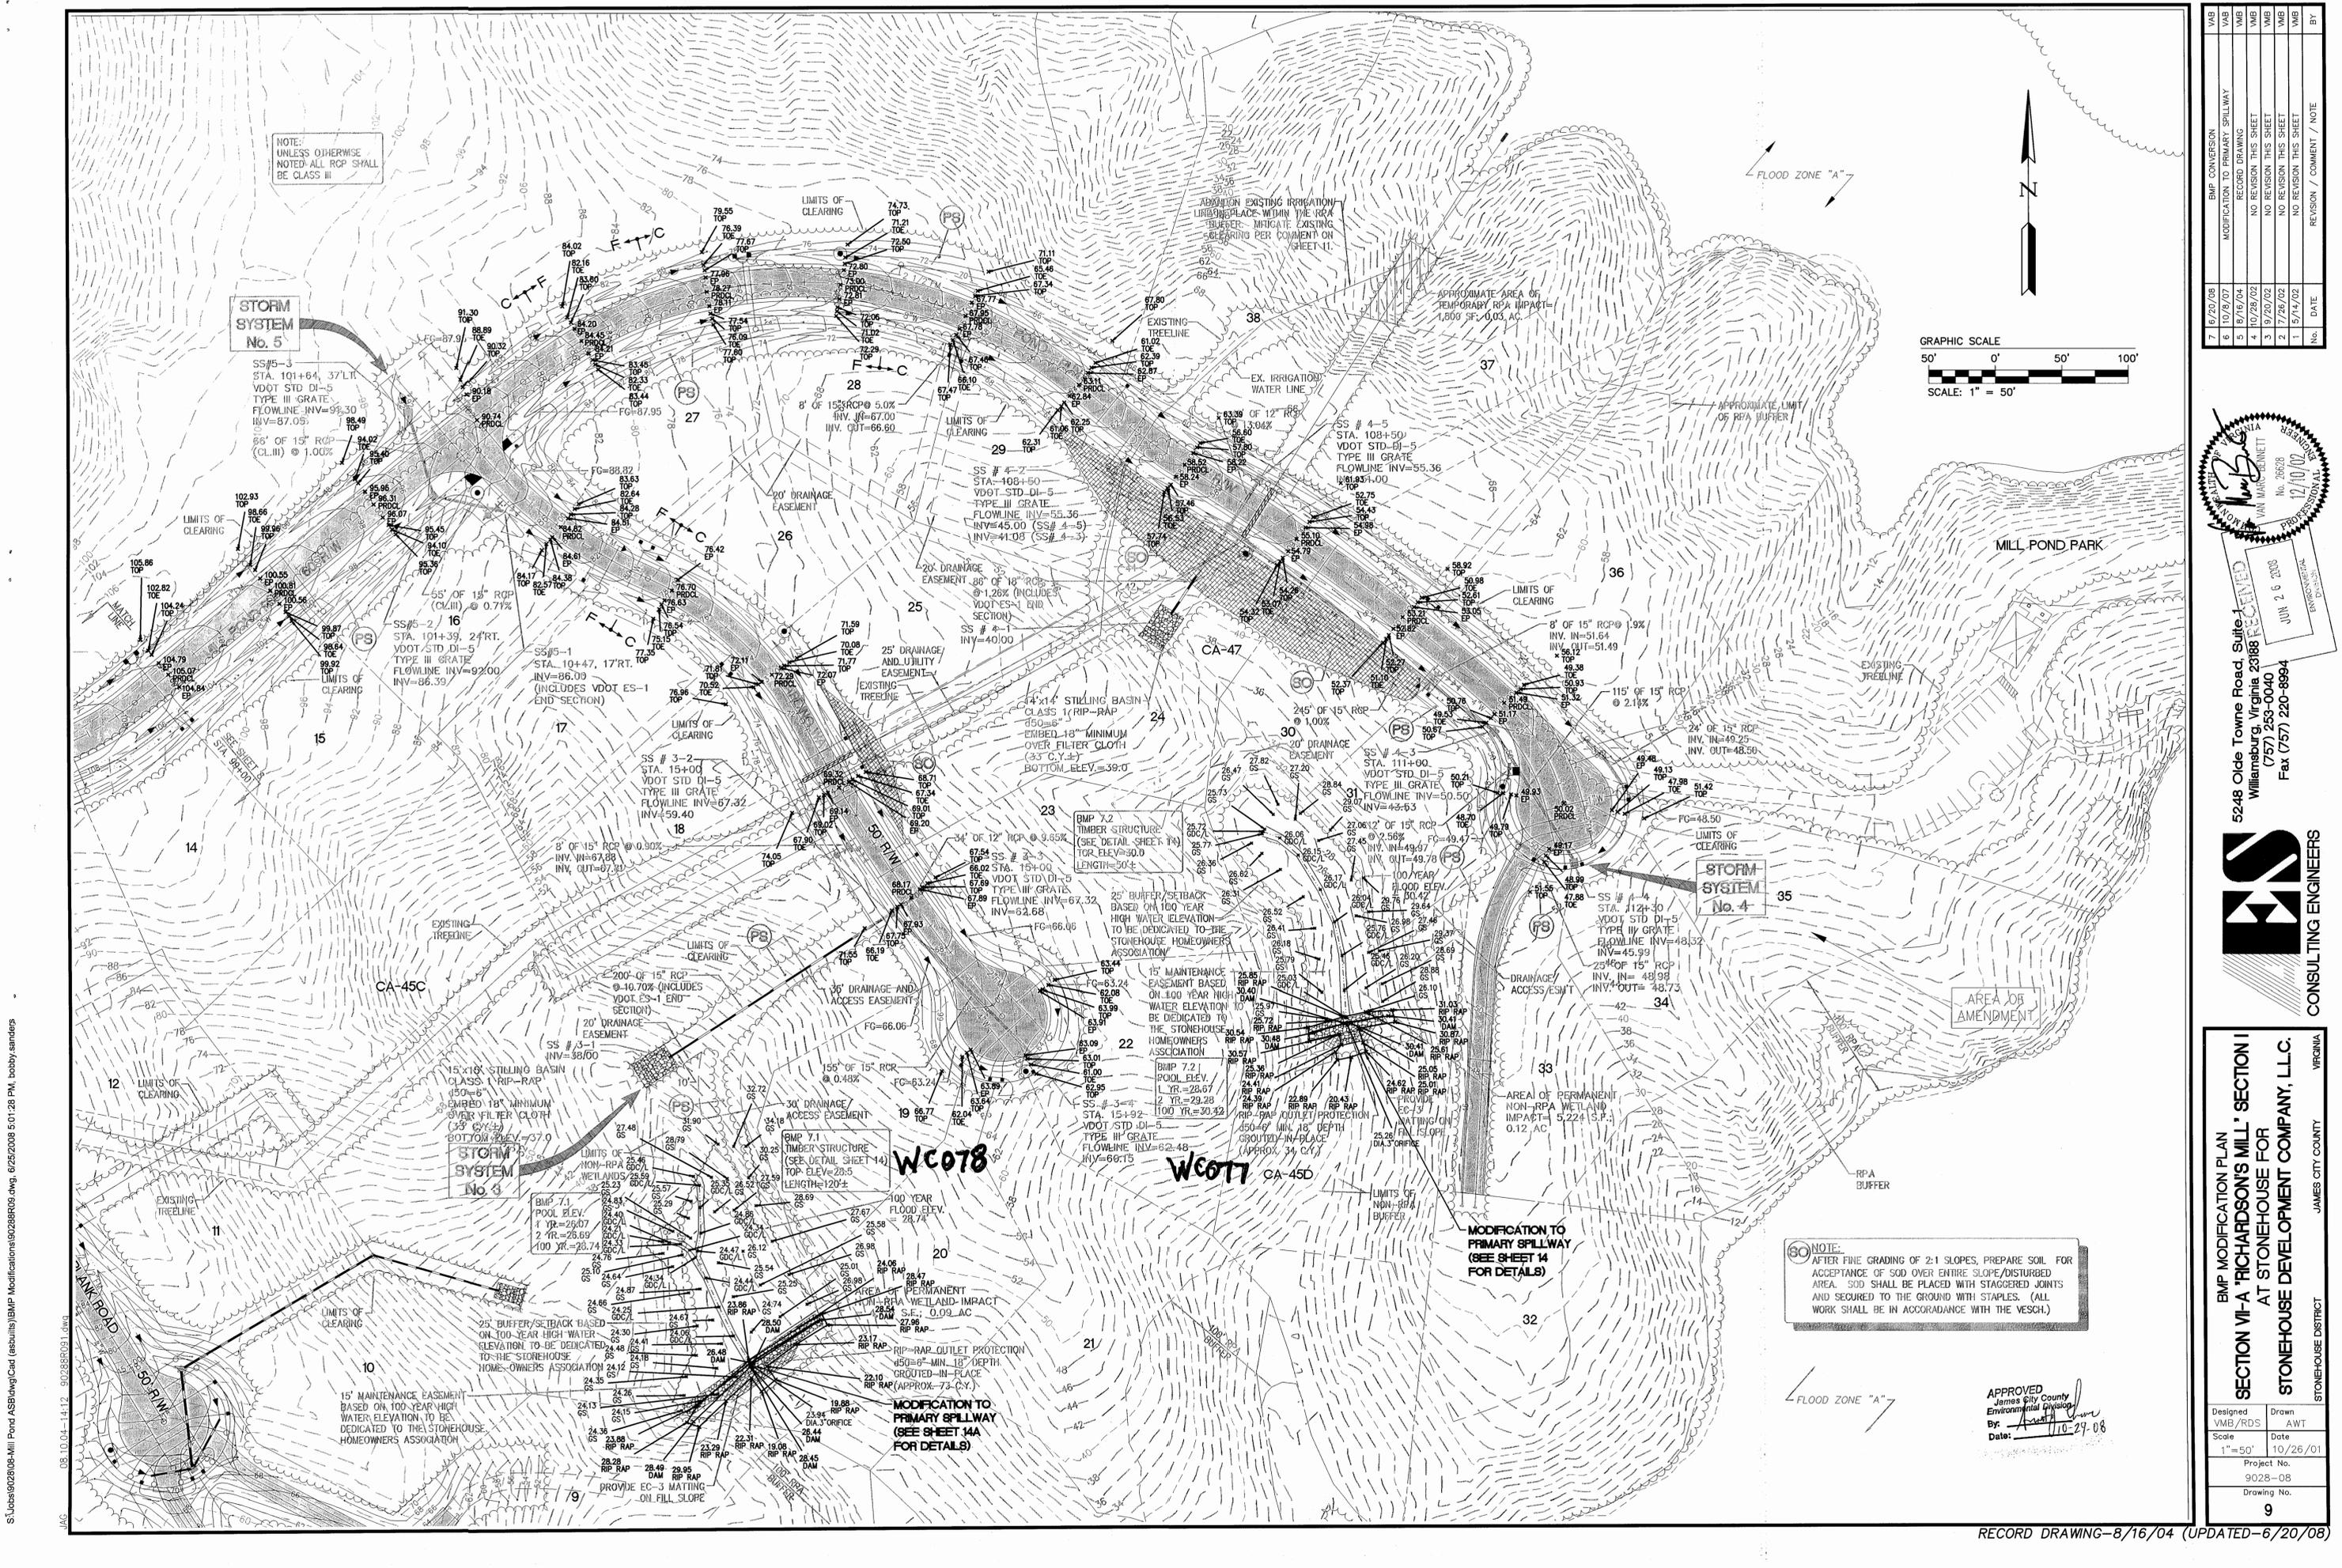

NO.	DATE	REVISION / COMMENT / NOTE
7	16/20/08	BMP CONVERSION
6	10/27/07	MODIFICATION TO PRIMARY SPILLWAY
5	10/27/07	RECORD DRAWING
4	10/25/07	NO REVISION THIS SHEET
3	10/25/07	NO REVISION THIS SHEET
2	7/26/07	NO REVISION THIS SHEET
1	5/14/07	NO REVISION THIS SHEET
NO.	DATE	REVISION / COMMENT / NOTE



5248 Old Towne Road, Suite 1
Williamsburg, Virginia 23188
(757) 253-0040
Fax (757) 220-8994



SECTION VI-A 'RICHARDSON'S MILL' SECTION 1
AT STONEHOUSE FOR
STONEHOUSE DEVELOPMENT COMPANY, L.L.C.


DESIGNED	DRAWN
VMB/RDS	AWT
Scale	Date
1"=50'	10/26/07
Project No.	
9028-08	
Drawing No.	
9	

NOTE:
AFTER FINE GRADING OF 2:1 SLOPES, PREPARE SOIL FOR
ACCEPTANCE OF SOD OVER ENTIRE SLOPE/DISTURBED
AREA. SOD SHALL BE PLACED WITH STAGGERED JOINTS
AND SECURED TO THE GROUND WITH STAPLES. (ALL
WORK SHALL BE IN ACCORDANCE WITH THE VESCH.)


APPROVED
James W. Burnett
Environmental Engineer
By: *[Signature]*
Date: 11/0-29-08

S:\Jobs\902808-Mill Pond ASB\dwg\Cad (resub)\BMP Modifications\9028R08.dwg, 6/25/2008 5:01:28 PM, bobby.sanders


SEDIMENT BASIN	TOP WALL (1)	BOTTOM ELEV. (2)	CLEAN OUT ELEV. (3)	WET POOL (4)	DRAINAGE AREA (AC.)
1	28.50 28.49	15.00	20.10	23.70	10.80
2	30.00 30.45	19.00	23.50	25.30	7.90

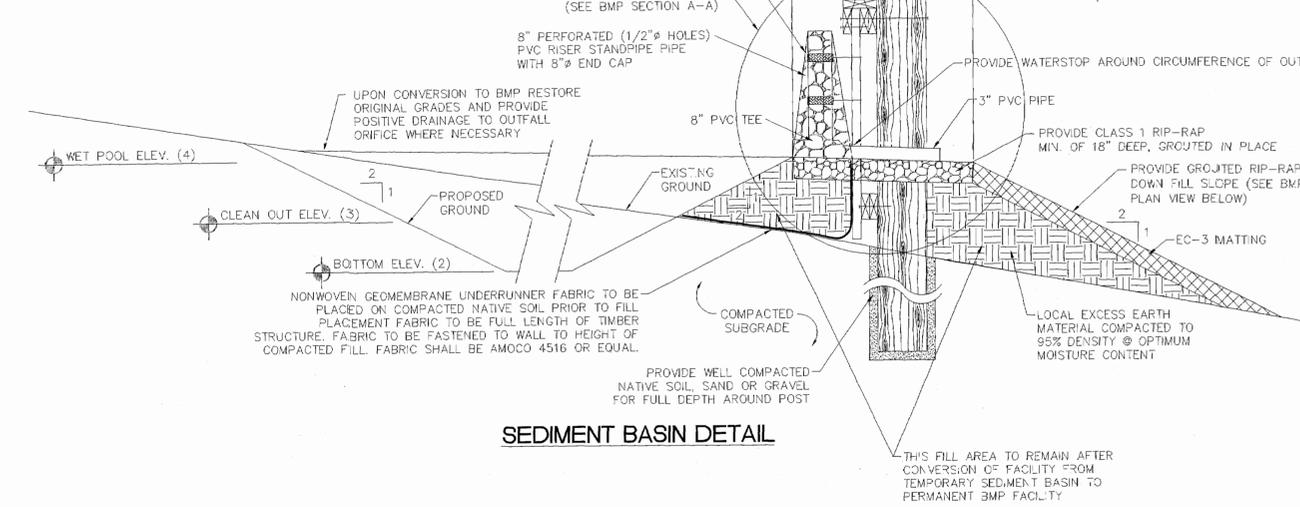

SEDIMENT BASIN DETAIL

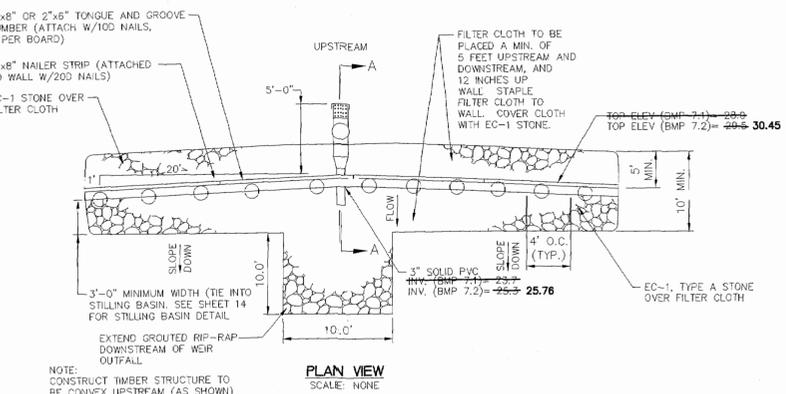

PLAN VIEW
SCALE: NONE

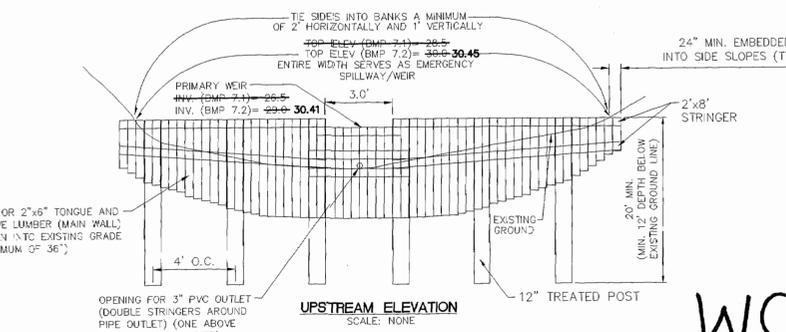


UPSTREAM ELEVATION
SCALE: NONE

WC077

PRESSURE TREATED WOOD DRY DETENTION STRUCTURE WC07.2

	BMP 7.1	BMP 7.2
1 YEAR STORM ELEVATION	28.67	28.67
2 YEAR STORM ELEVATION	29.26	29.26
10 YEAR STORM ELEVATION	29.81	29.81
100 YEAR STORM ELEVATION	30.42	30.42

NOTE: ALL LUMBER TO BE PRESSURE TREATED. ALL FASTENERS TO BE GALVANIZED.

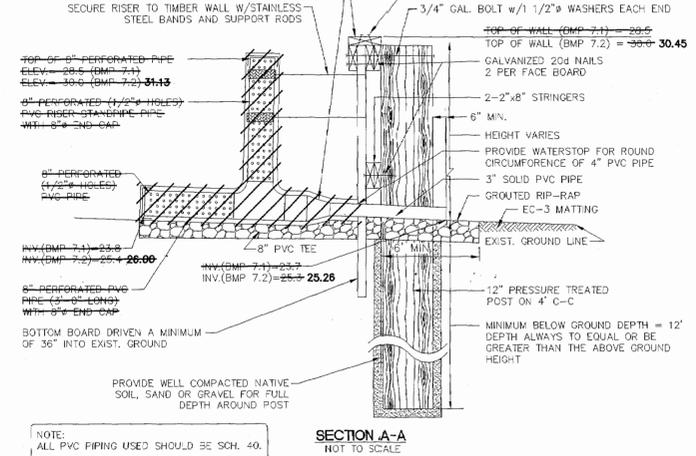

NOTE: ALL PVC PIPING USED SHOULD BE SCH. 40.

GENERAL NOTES FOR CONSTRUCTION OF STORMWATER BASINS

1. THE CONTRACTOR SHALL PROVIDE ALL WORK AND MATERIALS NEEDED TO CONSTRUCT THE STORMWATER BASIN, STORMWATER MANAGEMENT PONDS, BEST MANAGEMENT PRACTICES, SEDIMENT BASINS AND SEDIMENT TRAPS. THE WORK SHALL INCLUDE ALL LABOR, MATERIALS, EQUIPMENT AND MATERIALS NEEDED FOR THE COMPLETION OF GRADING AND EARTHWORK ASSOCIATED WITH THE CONSTRUCTION.
2. THE OWNER SHALL CONSULT AND PROVIDE FOR THE SERVICES OF A GEOTECHNICAL ENGINEER. THE GEOTECHNICAL ENGINEER SHALL PROVIDE TEST RESULTS ON PLACED FILL MATERIALS, IDENTIFYING SOIL CLASSIFICATION, PERMEABILITY, PLASTICITY INDEX, AND COMPACTION. ALL TESTS SHALL BE IN CONFORMANCE WITH ASTM STANDARDS. THE COST OF THE SERVICES OF THE GEOTECHNICAL ENGINEER SHALL BE THE RESPONSIBILITY OF THE OWNER. SATISFACTORY GEOTECHNICAL RESULTS ARE NEEDED PRIOR TO FINAL APPROVAL.
3. ALL INSPECTIONS REQUIRED FOR THE WORK SHALL BE PERFORMED BY A GEOTECHNICAL ENGINEER AT THE EXPENSE OF THE OWNER.
4. ON-SITE EXCAVATED MATERIAL, IF DETERMINED SUITABLE FOR USE AS FILL MATERIAL BY A GEOTECHNICAL ENGINEER, MAY BE USED FOR CONSTRUCTION. SHOULD ADDITIONAL MATERIAL BE REQUIRED, THE CONTRACTOR SHALL IDENTIFY THE NEED FOR MATERIAL TO THE OWNER. AS ADDITIONAL BORROW MATERIAL MAY BE AVAILABLE ON THE STONEHOUSE PROPERTY, ALL EXCAVATED MATERIAL DETERMINED BY THE GEOTECHNICAL ENGINEER TO BE UNSUITABLE SHALL BE DISPOSED OF PROPERLY AT THE CONTRACTOR'S EXPENSE. ALL EXCAVATED MATERIAL NOT REQUIRED FOR BACKFILLING SHALL EITHER BE DEPOSITED ON SITE AND SPREAD BY THE CONTRACTOR, OR SHALL BE DEPOSITED IN AN AREA ON THE STONEHOUSE PROPERTY AS DIRECTED BY THE OWNER. THE CONTRACTOR SHALL PROVIDE PROPER STABILIZATION, AND EROSION AND SEDIMENT CONTROL MEASURES NEEDED TO CONTROL AS PER THE VESCH THIRD EDITION.
5. RECORD DRAWINGS (AS-BUILTS) OF THE STORMWATER MANAGEMENT FACILITY PROPOSED ON THESE DRAWINGS MUST BE SUPPLIED TO THE JAMES CITY COUNTY ENVIRONMENTAL DIVISION WITHIN 30 DAYS OF COMPLETION OF THE SWM/BMP FACILITY. A CONSTRUCTION CERTIFICATE OF THE SWM/BMP SHALL BE SUBMITTED WITH THE RECORD DRAWINGS. RECORD DRAWINGS AND SWM/BMP CERTIFICATION SHALL BE SUBMITTED, REVIEWED AND APPROVED BY THE STAFF OF THE JAMES CITY COUNTY ENVIRONMENTAL DIVISION PRIOR TO THE RELEASE OF POSTED BONDS AND/OR SURETIES.

STORMWATER MANAGEMENT/ BMP FACILITY MAINTENANCE PLAN FOR BMP 7.1 AND 7.2

- PROPER MAINTENANCE OF THIS FACILITY IS ENCOURAGED TO PREVENT THE INTRODUCTION OF DEBRIS AND SEDIMENT IN TO THE FACILITY, SPILLWAY(S) AND DOWNSTREAM WATERWAYS. FOLLOWING INSTALLATION OF THE FACILITY AND ESTABLISHMENT OF VEGETATION IN DISTURBED AREAS, INSPECTIONS FOR SEDIMENT BUILDUPS WILL BE PERFORMED AT LEAST QUARTERLY. IT IS ANTICIPATED THAT UNDER NORMAL CONDITIONS, SEDIMENT REMOVAL FROM THE FACILITY WILL BE REQUIRED ONCE EVERY 10 YEARS. IF OTHER CONSTRUCTION OR RELATED ACTIVITIES ARE PERFORMED ON UPSLOPE PARCELS, ADEQUATE PROTECTION SHOULD BE PROVIDED AND INSPECTIONS PERFORMED AT LEAST ONCE WEEKLY.
- A DESIGNATED REPRESENTATIVE OF THE OWNER WILL INSPECT THE SWM STRUCTURE AFTER EACH SIGNIFICANT RAINFALL EVENT OR THE FOLLOWING WORKING DAY IF A WEEKEND OR HOLIDAY OCCURS. A SIGNIFICANT RAINFALL FOR THIS STRUCTURE IS DEFINED AS ONE (1) INCH OR MORE OF GAUGED RAINFALL WITHIN A 24 HOUR PERIOD. ONCE PER YEAR, A REPRESENTATIVE OF THE COUNTY MAY JOINTLY INSPECT THE STRUCTURE. APPROPRIATE ACTION, PERFORMED AT THE COST OF THE OWNER, WILL BE TAKEN TO ENSURE APPROPRIATE MAINTENANCE. WHERE STRUCTURES ARE TO BE MAINTAINED JOINTLY, ALLOCATION OF MAINTENANCE COSTS WILL BE IN ACCORDANCE WITH THE TERMS ESTABLISHED IN MAINTENANCE AGREEMENTS. KEYS TO LOCKED ACCESS POINTS SHALL BE MADE AVAILABLE TO COUNTY INSPECTION PERSONNEL UPON REQUEST.
- INSPECTION AND MAINTENANCE OF THE FACILITY WILL CONSIST OF THE FOLLOWING ADDITIONAL MEASURES:
1. THE INSPECTION FOR SEDIMENT BUILDUP WILL BE PERFORMED BY VISUAL INSPECTION AND A PHYSICAL DETERMINATION OF SEDIMENT DEPTH WITHIN THE STORAGE AREA. IF THE DEPTH OF SEDIMENT REACHES THE DEPTH OF 1.0 FT. ABOVE THE BOTTOM OF THE LOW FLOW ORIFICE IN THE TIMBER WALL, REMOVAL IS REQUIRED USING A RUBBER-WHEELED BACKHOE. AT THIS TIME, THE STILLING BASINS LOCATED AT THE OUTFALLS OF THE STORM SEWER PIPE SYSTEMS SHALL ALSO BE INSPECTED. IF THE DEPTH OF SEDIMENT WITHIN THE STILLING BASINS REACHES A DEPTH OF 18" ABOVE THE BOTTOM OF THE BASIN OR 6" ABOVE THE INVERT OF THE OUTFALL PIPE, REMOVAL OF THE MATERIAL IS REQUIRED. AT THE SAME TIME, OR AT LEAST ONCE PER YEAR, CLEAN THE OUTFALL PIPES WITHIN THE TIMBER WALL DETENTION BASINS OF ACCUMULATED SEDIMENTS. DISPOSE OF SEDIMENTS REMOVED FROM THE FACILITY AT AN ACCEPTABLE DISPOSAL AREA.
 2. PERFORM QUARTERLY INSPECTIONS OF THE TIMBER STRUCTURE AND SPILLWAY DEVICES FOR THE OBSERVANCE OF COLLECTED DEBRIS. IMMEDIATELY REMOVE ANY DEBRIS TO MAINTAIN THE INTEGRITY OF THE STRUCTURE AND PROVIDE AN ATTRACTIVE APPEARANCE.
 3. PERFORM YEARLY STRUCTURAL INSPECTIONS OF THE FACILITY FOR DAMAGE. STRUCTURAL INSPECTION SHALL BE PERFORMED ON THE TIMBER WALL, ORIFICE/WEIR(S), OUTLET DEVICE AND STONE APRONS. IF DAMAGE IS EVIDENT, FURTHER INVESTIGATION BY A PROFESSIONAL ENGINEER MAY BE REQUIRED TO ASSESS THE INTEGRITY OF THE STRUCTURE.
 4. PERFORM QUARTERLY INSPECTIONS OF THE GRADED SIDE SLOPES OF THE DETENTION FACILITY FOR SIGNS OF ANIMAL/ RODENT BORROWS OR SLOPE EROSION. IMMEDIATELY PERFORM NECESSARY REPAIRS, REFILLING OR RESEEDING AS APPROPRIATE.
 5. RECORD KEEPING. THE OWNER OR DESIGNATED REPRESENTATIVE SHALL KEEP REASONABLE, ACCURATE WRITTEN RECORDS OR INSPECTIONS PERFORMED FOR THE STRUCTURE. RECORDS SHALL DOCUMENT OR REPAIRS PERFORMED. COPIES SHALL BE PROVIDED TO THE COUNTY UPON REQUEST.
 6. THE FACILITY SHALL NOT BE MODIFIED IN ANY WAY WITHOUT PRIOR CONSENT/ APPROVAL OF THE COUNTY.

CONVERSION OF SEDIMENT BASINS INTO BMP FACILITIES

BMP FACILITIES WILL INITIALLY BE CONSTRUCTED AS SEDIMENT BASINS REQUIRING EXCAVATION TO PROVIDE ADEQUATE STORAGE. ONCE J.C.C. ENVIRONMENTAL DIVISION GIVES CONCURRENCE TO REMOVE THE SEDIMENT BASIN FACILITIES, EXCAVATED MATERIAL SHOULD BE REPLACED. ORIGINAL GRADES SHOULD BE RESTORED AND POSITIVE DRAINAGE SHALL BE PROVIDED TO OUTFALL ORIFICE AS NECESSARY. ANY EXCESS EARTH OR SEDIMENT SHALL BE REMOVED AND DISPOSED OF BY CONTRACTOR. ALL DISTURBED AREA SHALL BE SEEDED AND STABILIZED.

VAB	REVISION / COMMENT / NOTE	DATE	BY
7	BMP CONVERSION	6/20/08	
6	MODIFICATION TO PRIMARY SPILLWAY	10/29/07	
5	RECORD DRAWING	8/16/04	
4	NO REVISION THIS SHEET	10/28/02	
3	REVISED PER JCC COMMENTS DATED 9/26/02	9/20/02	
2	REVISED PER JCC COMMENTS DATED 8/20/02	7/26/02	
1	SHEET ADDED	8/14/02	



RECEIVED
JUN 26 2008
ENGINEERING DIVISION

5248 Old Towne Road, Suite 1
Williamsburg, Virginia 23188
(757) 253-0040
Fax (757) 220-8994




BMP MODIFICATION PLAN
SECT. VII-A 'RICHARDSON'S MILL' SECT. 1
AT STONEHOUSE FOR
STONEHOUSE DEVELOPMENT COMPANY, L.L.C.


DESIGNED: VMB/RDS
SCALE: NONE
DRAWN: AWT
DATE: 5/3/02
PROJECT NO.: 9028-8
DRAWING NO.: 14

STONEHOUSE DISTRICT
JAMES CITY COUNTY
VIRGINIA

SEDIMENT BASIN	TOP WALL (1)	BOTTOM ELEV. (2)	CLEAN OUT ELEV. (3)	WET POOL (4)	DRAINAGE AREA (AC.)
1	28.66 28.49	15.00	20.10	23.70	10.80
2	30.66 30.45	19.00	23.50	25.30	7.90

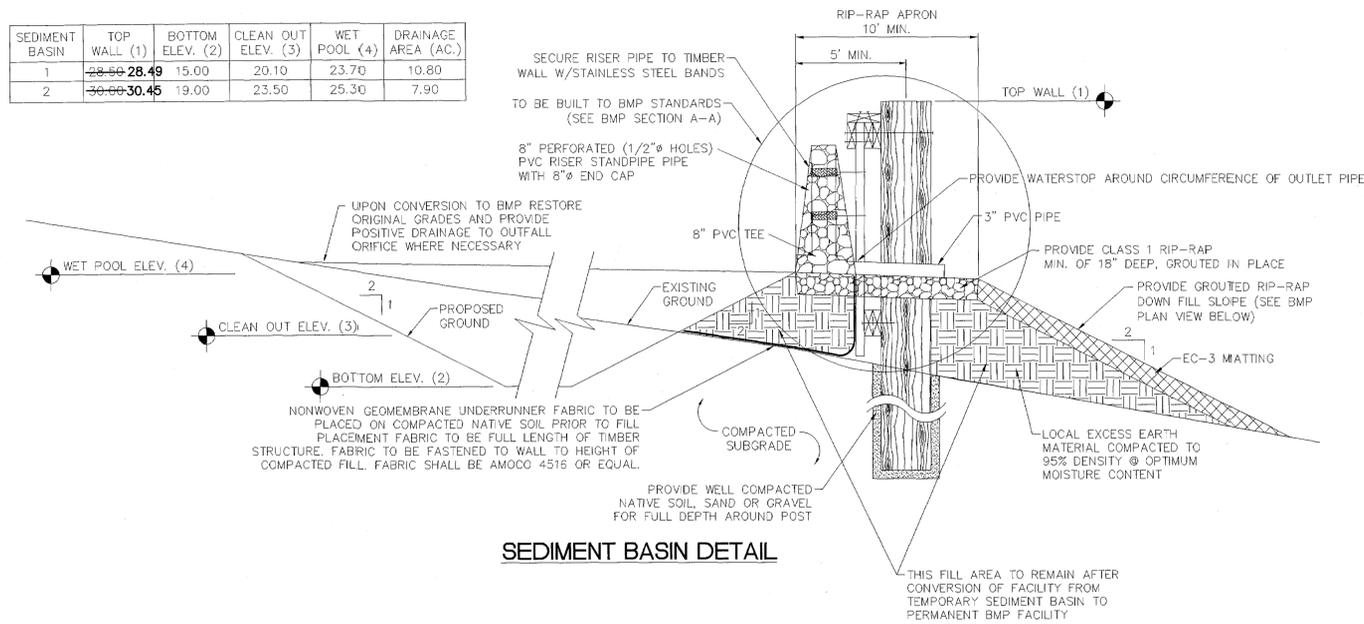

SEDIMENT BASIN DETAIL

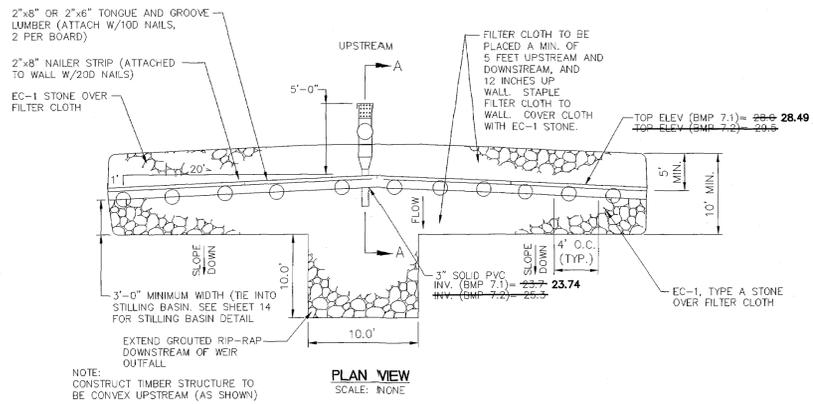


NOTE: CONSTRUCT TIMBER STRUCTURE TO BE CONVEX UPSTREAM (AS SHOWN)

PLAN VIEW
SCALE: NONE


	BMP 7.1	BMP 7.2
1 YEAR STORM ELEVATION	26.07	26.66
2 YEAR STORM ELEVATION	26.69	27.28
10 YEAR STORM ELEVATION	28.18	28.81
100 YEAR STORM ELEVATION	28.74	29.42

NOTE: ALL LUMBER TO BE PRESSURE TREATED. ALL FASTENERS TO BE GALVANIZED.

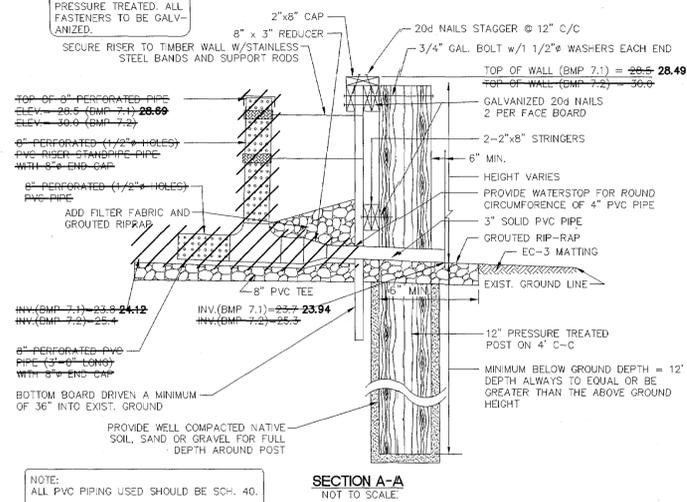

NOTE: ALL PVC PIPING USED SHOULD BE SCH. 40.

SECTION A-A
NOT TO SCALE

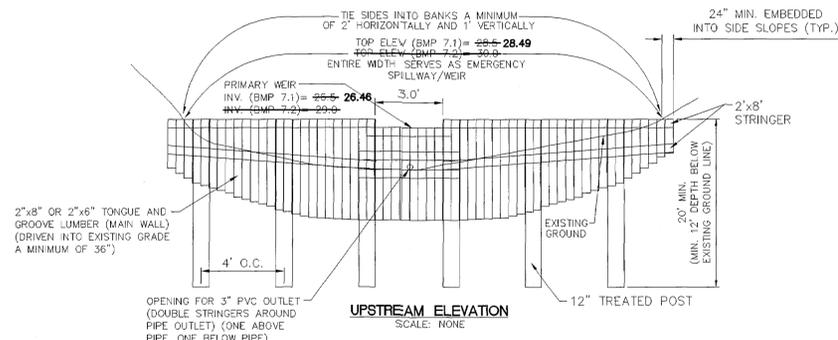

UPSTREAM ELEVATION
SCALE: NONE

PRESSURE TREATED WOOD DRY DETENTION STRUCTURE WC07.1

WC078

GENERAL NOTES FOR CONSTRUCTION OF STORMWATER BASINS

1. THE CONTRACTOR SHALL PROVIDE ALL WORK AND MATERIALS NEEDED TO CONSTRUCT THE STORMWATER BASIN, STORMWATER MANAGEMENT PONDS, BEST MANAGEMENT PRACTICES, SEDIMENT BASINS AND SEDIMENT TRAPS. THE WORK SHALL INCLUDE ALL LABOR, MATERIALS, EQUIPMENT AND MATERIALS NEEDED FOR THE COMPLETION OF GRADING AND EARTHWORK ASSOCIATED WITH THE CONSTRUCTION.
2. THE OWNER SHALL CONSULT AND PROVIDE FOR THE SERVICES OF A GEOTECHNICAL ENGINEER. THE GEOTECHNICAL ENGINEER SHALL PROVIDE TEST RESULTS ON PLACED FILL MATERIALS, IDENTIFYING SOIL CLASSIFICATION, PERMEABILITY, PLASTICITY INDEX, AND COMPACTION. ALL TESTS SHALL BE IN CONFORMANCE WITH ASTM STANDARDS. THE COST OF THE SERVICES OF THE GEOTECHNICAL ENGINEER SHALL BE THE RESPONSIBILITY OF THE OWNER. SATISFACTORY GEOTECHNICAL RESULTS ARE NEEDED PRIOR TO FINAL APPROVAL.
3. ALL INSPECTIONS REQUIRED FOR THE WORK SHALL BE PERFORMED BY A GEOTECHNICAL ENGINEER AT THE EXPENSE OF THE OWNER.
4. ON-SITE EXCAVATED MATERIAL, IF DETERMINED SUITABLE FOR USE AS FILL MATERIAL BY A GEOTECHNICAL ENGINEER, MAY BE USED FOR CONSTRUCTION. SHOULD ADDITIONAL MATERIAL BE REQUIRED, THE CONTRACTOR SHALL IDENTIFY THE NEED FOR MATERIAL TO THE OWNER, AS ADDITIONAL BORROW MATERIAL MAY BE AVAILABLE ON THE STONEHOUSE PROPERTY. ALL EXCAVATED MATERIAL DETERMINED BY THE GEOTECHNICAL ENGINEER TO BE UNSUITABLE SHALL BE DISPOSED OF PROPERLY AT THE CONTRACTOR'S EXPENSE. ALL EXCAVATED MATERIAL NOT REQUIRED FOR BACKFILLING SHALL EITHER BE DEPOSITED ON SITE AND SPREAD BY THE CONTRACTOR, OR SHALL BE DEPOSITED IN AN AREA ON THE STONEHOUSE PROPERTY AS DIRECTED BY THE OWNER. THE CONTRACTOR SHALL PROVIDE PROPER STABILIZATION AND EROSION AND SEDIMENT CONTROL MEASURES NEEDED TO CONTROL AS PER THE VESCH THIRD EDITION.
5. RECORD DRAWINGS (AS-BUILTS) OF THE STORMWATER MANAGEMENT FACILITY PROPOSED ON THESE DRAWINGS MUST BE SUPPLIED TO THE JAMES CITY COUNTY ENVIRONMENTAL DIVISION WITHIN 30 DAYS OF COMPLETION OF THE SWM/BMP FACILITY. A CONSTRUCTION CERTIFICATE OF THE SWM/BMP SHALL BE SUBMITTED WITH THE RECORD DRAWINGS. RECORD DRAWINGS AND SWM/BMP CERTIFICATION SHALL BE SUBMITTED, REVIEWED AND APPROVED BY THE STAFF OF THE JAMES CITY COUNTY ENVIRONMENTAL DIVISION PRIOR TO THE RELEASE OF POSTED BONDS AND/OR SURETIES.

STORMWATER MANAGEMENT/ BMP FACILITY MAINTENANCE PLAN FOR BMP 7.1 AND 7.2

PROPER MAINTENANCE OF THIS FACILITY IS ENCOURAGED TO PREVENT THE INTRODUCTION OF DEBRIS AND SEDIMENT INTO THE FACILITY, SPILLWAY(S) AND DOWNSTREAM WATERWAYS. FOLLOWING INSTALLATION OF THE FACILITY AND ESTABLISHMENT OF VEGETATION IN DISTURBED AREAS, INSPECTIONS FOR SEDIMENT BUILDUPS WILL BE PERFORMED AT LEAST QUARTERLY. IT IS ANTICIPATED THAT UNDER NORMAL CONDITIONS, SEDIMENT REMOVAL FROM THE FACILITY WILL BE REQUIRED ONCE EVERY 10 YEARS. IF OTHER CONSTRUCTION OR RELATED ACTIVITIES ARE PERFORMED ON UPSLOPE PARCELS, ADEQUATE PROTECTION SHOULD BE PROVIDED AND INSPECTIONS PERFORMED AT LEAST ONCE WEEKLY.

A DESIGNATED REPRESENTATIVE OF THE OWNER WILL INSPECT THE SWM STRUCTURE AFTER EACH SIGNIFICANT RAINFALL EVENT OR THE FOLLOWING WORKING DAY IF A WEEKEND OR HOLIDAY OCCURS. A SIGNIFICANT RAINFALL FOR THIS STRUCTURE IS DEFINED AS ONE (1) INCH OR MORE OF GAUGED RAINFALL WITHIN A 24 HOUR PERIOD. ONCE PER YEAR, A REPRESENTATIVE OF THE COUNTY MAY JOINTLY INSPECT THE STRUCTURE. APPROPRIATE ACTION, PERFORMED AT THE COST OF THE OWNER, WILL BE TAKEN TO ENSURE APPROPRIATE MAINTENANCE. WHERE STRUCTURES ARE TO BE MAINTAINED JOINTLY, ALLOCATION OF MAINTENANCE COSTS WILL BE IN ACCORDANCE WITH THE TERMS ESTABLISHED IN MAINTENANCE AGREEMENTS. KEYS TO LOCKED ACCESS POINTS SHALL BE MADE AVAILABLE TO COUNTY INSPECTION PERSONNEL UPON REQUEST.

INSPECTION AND MAINTENANCE OF THE FACILITY WILL CONSIST OF THE FOLLOWING ADDITIONAL MEASURES:

1. THE INSPECTION FOR SEDIMENT BUILDUP WILL BE PERFORMED BY VISUAL INSPECTION AND A PHYSICAL DETERMINATION OF SEDIMENT DEPTH WITHIN THE STORAGE AREA. IF THE DEPTH OF SEDIMENT REACHES THE DEPTH OF 1.0 FT. ABOVE THE BOTTOM OF THE LOW FLOW ORIFICE IN THE TIMBER WALL, REMOVAL IS REQUIRED USING A RUBBER-WHEELED BACKHOE. AT THIS TIME, THE STILLING BASINS LOCATED AT THE OUTFALLS OF THE STORM SEWER PIPE SYSTEMS SHALL ALSO BE INSPECTED. IF THE DEPTH OF SEDIMENT WITHIN THE STILLING BASINS REACHES A DEPTH OF 18" ABOVE THE BOTTOM OF THE BASIN OR 6" ABOVE THE INVERT OF THE OUTFALL PIPE, REMOVAL OF THE MATERIAL IS REQUIRED. AT THE SAME TIME, OR AT LEAST ONCE PER YEAR, CLEAN THE OUTFALL PIPES WITHIN THE TIMBER WALL DETENTION BASINS OF ACCUMULATED SEDIMENTS. DISPOSE OF SEDIMENTS REMOVED FROM THE FACILITY AT AN ACCEPTABLE DISPOSAL AREA.
2. PERFORM QUARTERLY INSPECTIONS OF THE TIMBER STRUCTURE AND SPILLWAY DEVICES FOR THE OBSERVANCE OF COLLECTED DEBRIS. IMMEDIATELY REMOVE ANY DEBRIS TO MAINTAIN THE INTEGRITY OF THE STRUCTURE AND PROVIDE AN ATTRACTIVE APPEARANCE.
3. PERFORM YEARLY STRUCTURAL INSPECTIONS OF THE FACILITY FOR DAMAGE. STRUCTURAL INSPECTION SHALL BE PERFORMED ON THE TIMBER WALL, ORIFICE/ WEIR(S), OUTLET DEVICE AND STONE APRONS. IF DAMAGE IS EVIDENT, FURTHER INVESTIGATION BY A PROFESSIONAL ENGINEER MAY BE REQUIRED TO ASSESS THE INTEGRITY OF THE STRUCTURE.
4. PERFORM QUARTERLY INSPECTIONS OF THE GRADED SIDE SLOPES OF THE DETENTION FACILITY FOR SIGNS OF ANIMAL/ RODENT BORROWS OR SLOPE EROSION. IMMEDIATELY PERFORM NECESSARY REPAIRS, REFILLING OR RESEEDING AS APPROPRIATE.
5. RECORD KEEPING. THE OWNER OR DESIGNATED REPRESENTATIVE SHALL KEEP REASONABLE, ACCURATE WRITTEN RECORDS OR INSPECTIONS PERFORMED FOR THE STRUCTURE. RECORDS SHALL DOCUMENT OR REPAIRS PERFORMED. COPIES SHALL BE PROVIDED TO THE COUNTY UPON REQUEST.
6. THE FACILITY SHALL NOT BE MODIFIED IN ANY WAY WITHOUT PRIOR CONSENT/ APPROVAL OF THE COUNTY.

CONVERSION OF SEDIMENT BASINS INTO BMP FACILITIES

BMP FACILITIES WILL INITIALLY BE CONSTRUCTED AS SEDIMENT BASINS REQUIRING EXCAVATION TO PROVIDE ADEQUATE STORAGE. ONCE J.C.C. ENVIRONMENTAL DIVISION GIVES CONCURRENCE TO REMOVE THE SEDIMENT BASIN FACILITIES, EXCAVATED MATERIAL SHOULD BE REPLACED. ORIGINAL GRADES SHOULD BE RESTORED AND POSITIVE DRAINAGE SHALL BE PROVIDED TO OUTFALL ORIFICE AS NECESSARY. ANY EXCESS EARTH OR SEDIMENT SHALL BE REMOVED AND DISPOSED OF BY CONTRACTOR. ALL DISTURBED AREA SHALL BE SEEDED AND STABILIZED.

NO.	DATE	REVISION / COMMENT / NOTE
7	10/20/08	BMP CONVERSION
6	10/16/07	MODIFICATION TO PRIMARY SPILLWAY
5	9/16/04	NO REVISION THIS SHEET
4	10/28/02	NO REVISION THIS SHEET
3	9/20/02	REVISED PER JCC COMMENTS DATED 9/16/02
2	7/26/02	REVISED PER JCC COMMENTS DATED 6/20/02
1	5/14/02	SHEET ADDED




5248 Old Towne Road, Suite 4
Williamsburg, Virginia 23188
(757) 253-0040
Fax (757) 220-8994



BMP MODIFICATION PLAN
SECT. VII-A "RICHARDSON'S MILL" SECT. 1
AT STONEHOUSE FOR
STONEHOUSE DEVELOPMENT COMPANY, L.L.C.

Designed	Drawn
VMB/RDS	AWT
Scale	Date
NONE	5/3/02
Project No.	
9028-8	
Drawing No.	
14A	

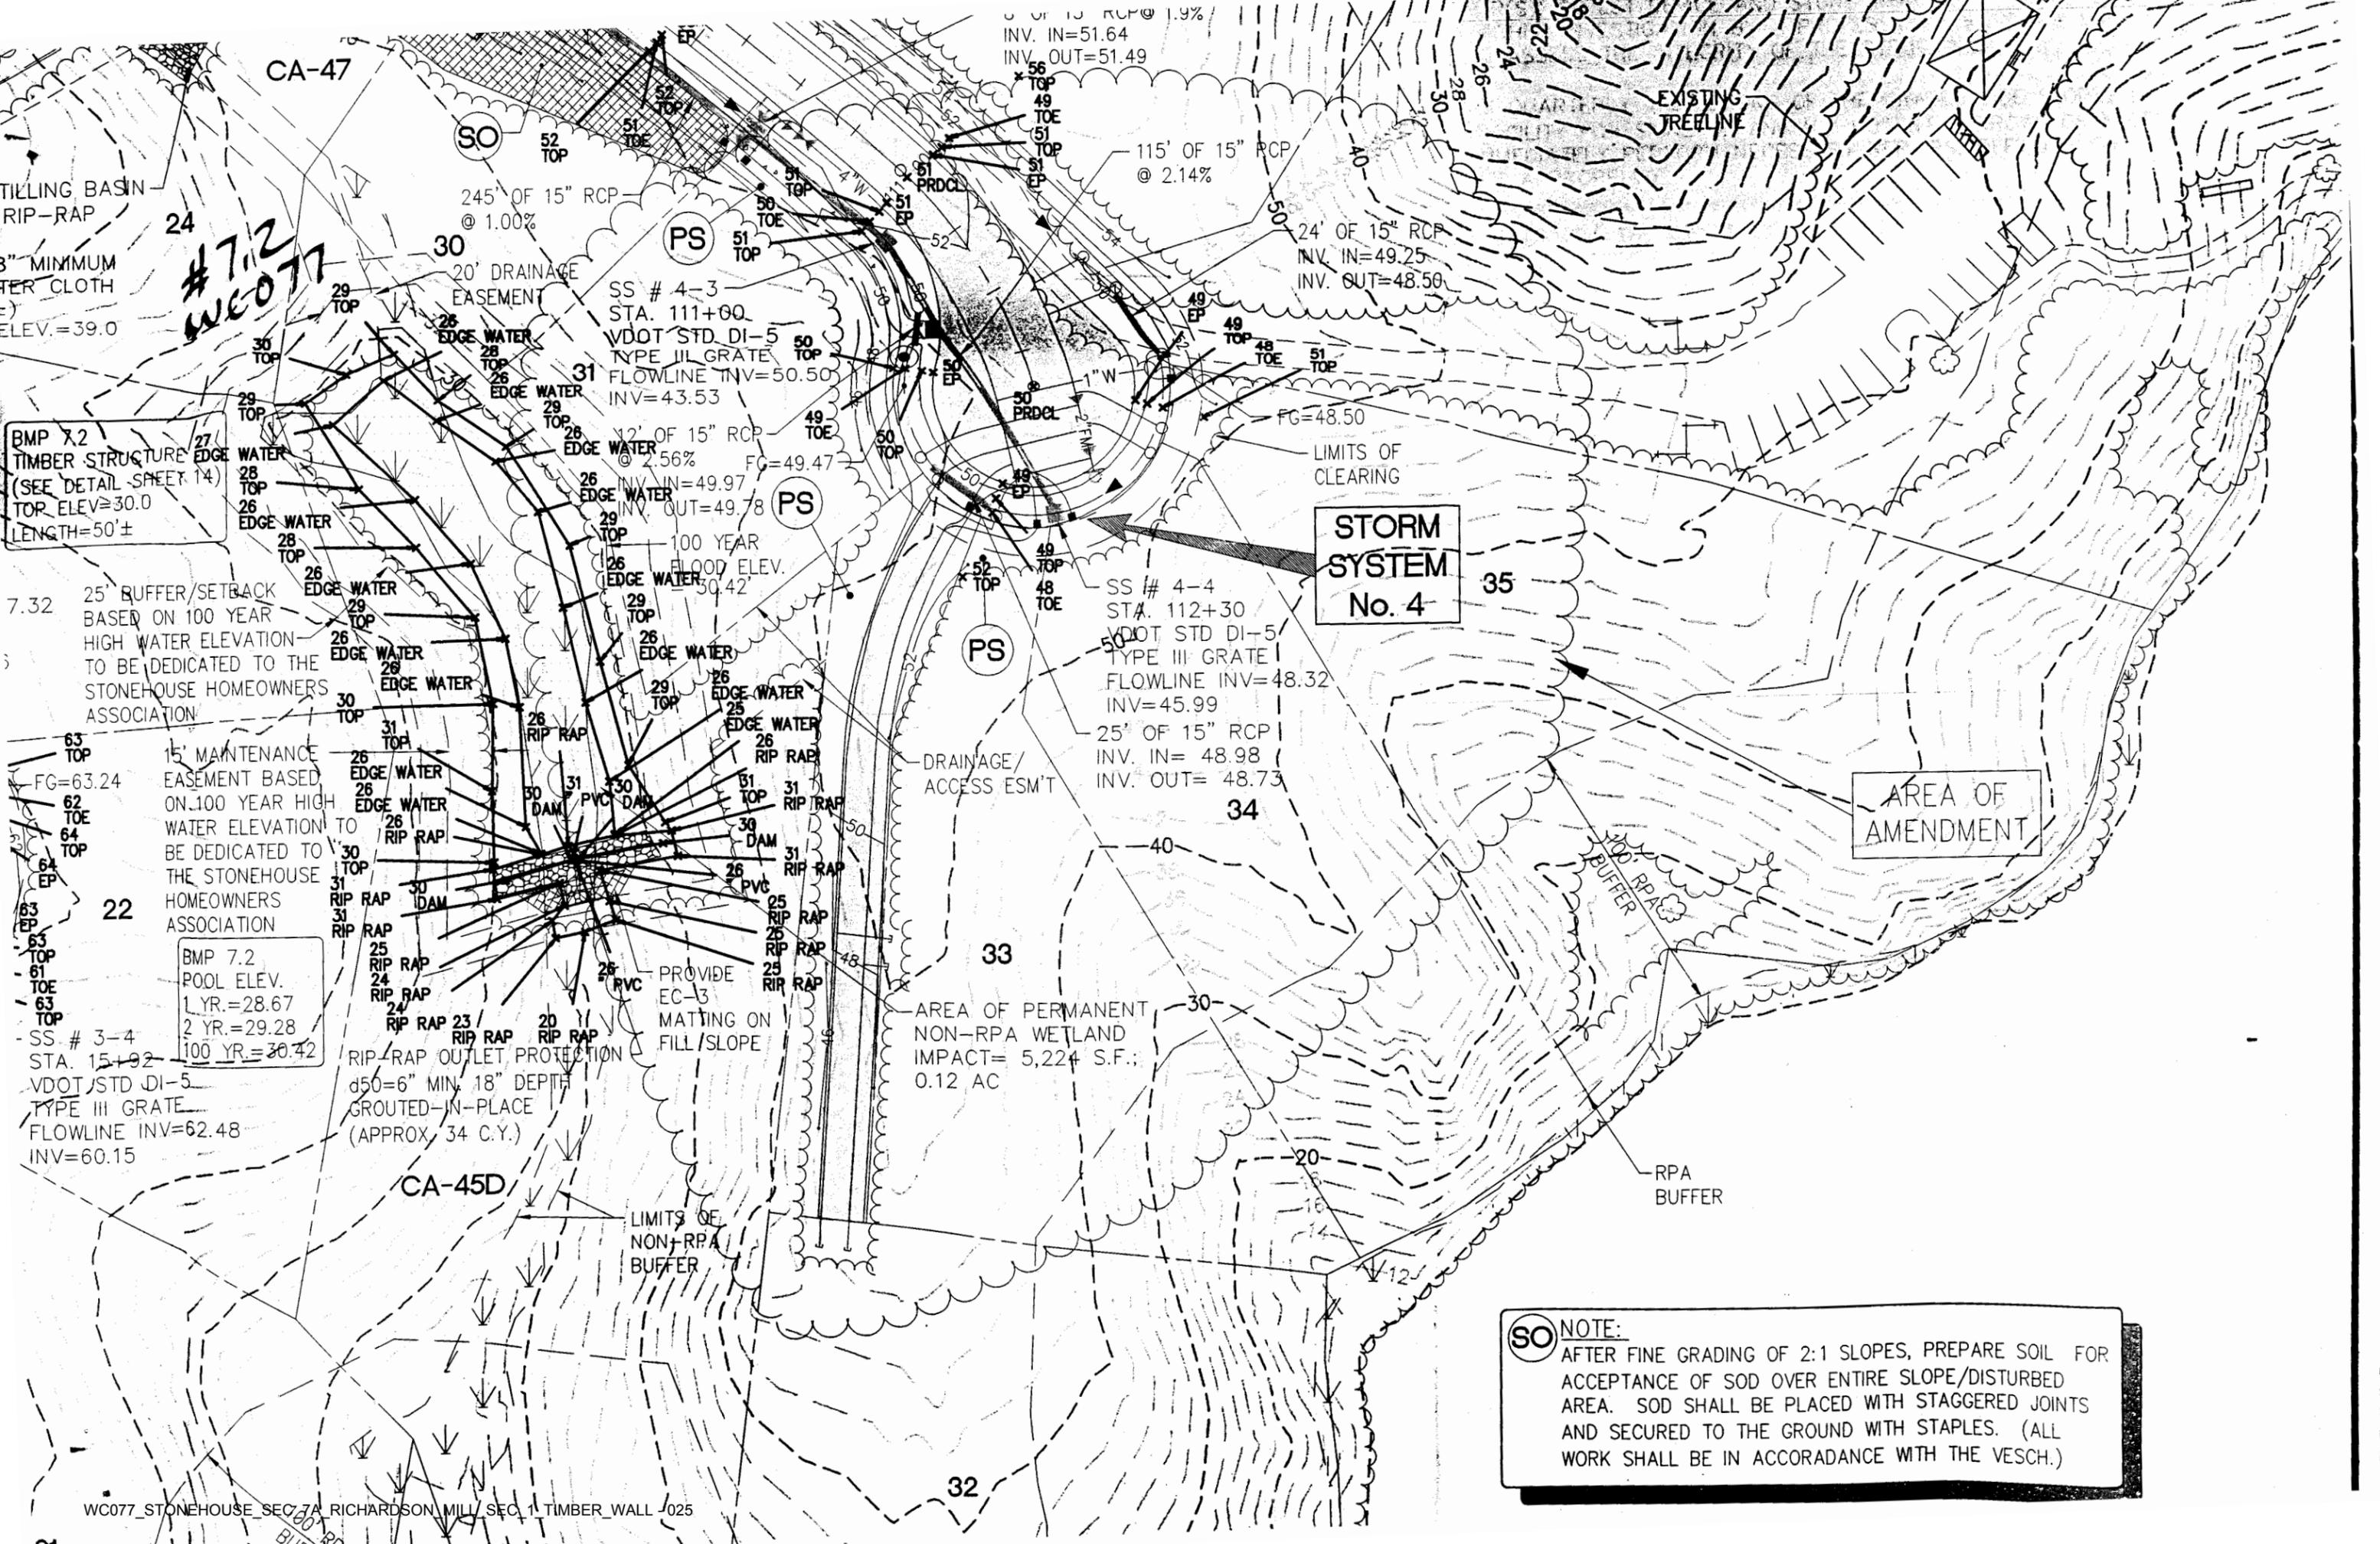

TILLING BASIN
RIP-RAP
3" MINIMUM
WATER CLOTH
ELEV.=39.0

BMP 7.2
TIMBER STRUCTURE
(SEE DETAIL SHEET 14)
TOP ELEV. ≥ 30.0
LENGTH=50'±

7.32 25' BUFFER/SETBACK
BASED ON 100 YEAR
HIGH WATER ELEVATION
TO BE DEDICATED TO THE
STONEHOUSE HOMEOWNERS
ASSOCIATION

15' MAINTENANCE
EASEMENT BASED
ON 100 YEAR
HIGH WATER ELEVATION
TO BE DEDICATED TO
THE STONEHOUSE
HOMEOWNERS
ASSOCIATION

BMP 7.2
POOL ELEV.
1 YR.=28.67
2 YR.=29.28
100 YR.=30.42

SS # 3-4
STA. 15+92
VDOT STD DI-5
TYPE III GRATE
FLOWLINE INV=62.48
INV=60.15

RIP RAP OUTLET PROTECTION
d50=6" MIN. 18" DEPTH
GROUTED-IN-PLACE
(APPROX. 34 C.Y.)

SS # 4-3
STA. 111+00
VDOT STD DI-5
TYPE III GRATE
FLOWLINE INV=50.50
INV=43.53

12' OF 15" RCP
@ 2.56%
FC=49.47
100 YEAR
FLOOD ELEV.
50.42


SS # 4-4
STA. 112+30
VDOT STD DI-5
TYPE III GRATE
FLOWLINE INV=48.32
INV=45.99
25' OF 15" RCP
INV. IN= 48.98
INV. OUT= 48.73

AREA OF PERMANENT
NON-RPA WETLAND
IMPACT= 5.224 S.F.;
0.12 AC

STORM
SYSTEM
No. 4

AREA OF
AMENDMENT

SO NOTE:
AFTER FINE GRADING OF 2:1 SLOPES, PREPARE SOIL FOR
ACCEPTANCE OF SOD OVER ENTIRE SLOPE/DISTURBED
AREA. SOD SHALL BE PLACED WITH STAGGERED JOINTS
AND SECURED TO THE GROUND WITH STAPLES. (ALL
WORK SHALL BE IN ACCORDANCE WITH THE VESCH.)

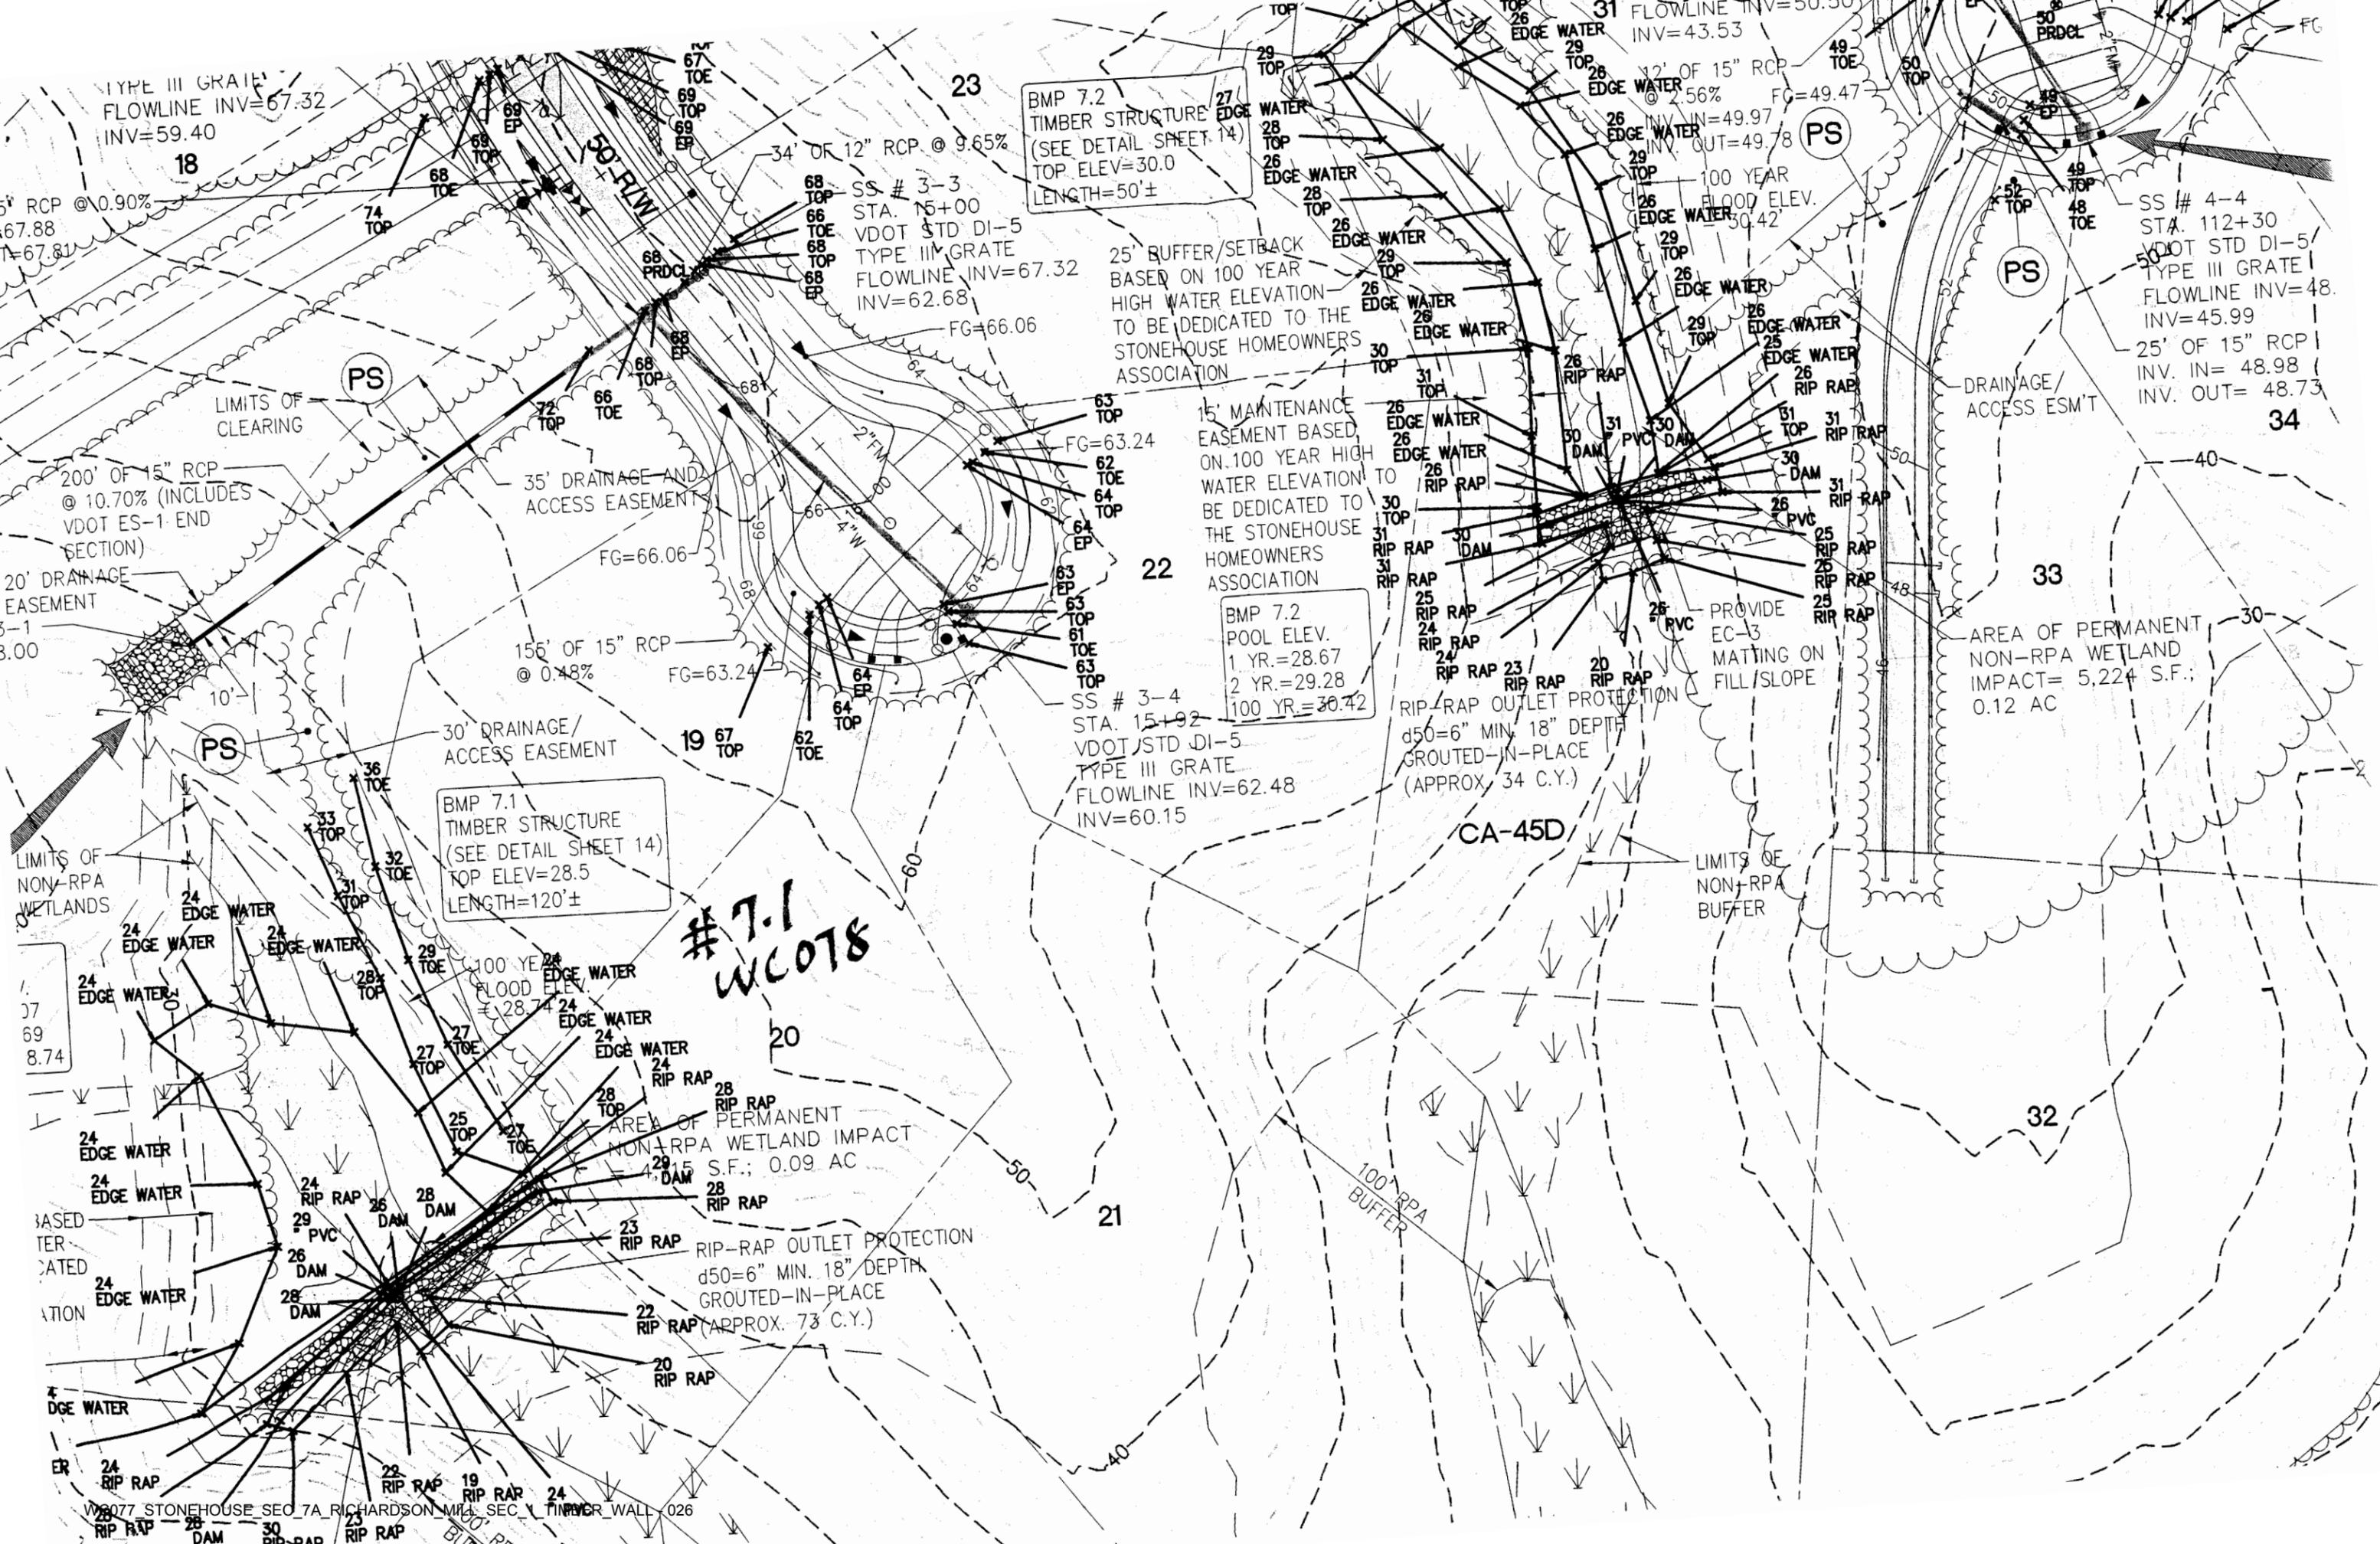

TYPE III GRADE
FLOWLINE INV=67.32
INV=59.40

BMP 7.2
TIMBER STRUCTURE
(SEE DETAIL SHEET 14)
TOP ELEV=30.0
LENGTH=50'±

BMP 7.1
TIMBER STRUCTURE
(SEE DETAIL SHEET 14)
TOP ELEV=28.5
LENGTH=120'±

25' BUFFER/SETBACK
BASED ON 100 YEAR
HIGH WATER ELEVATION
TO BE DEDICATED TO THE
STONEHOUSE HOMEOWNERS
ASSOCIATION

15' MAINTENANCE
EASEMENT BASED
ON 100 YEAR HIGH
WATER ELEVATION
TO BE DEDICATED TO
THE STONEHOUSE
HOMEOWNERS
ASSOCIATION

BMP 7.2
POOL ELEV.
1 YR.=28.67
2 YR.=29.28
100 YR.=30.42

*#7.1
WC078*

AREA OF PERMANENT
NON-RPA WETLAND
IMPACT = 4,195 S.F.; 0.09 AC

RIP-RAP OUTLET PROTECTION
d50=6" MIN. 18" DEPTH
GROUTED-IN-PLACE
(APPROX. 73 C.Y.)

AREA OF PERMANENT
NON-RPA WETLAND
IMPACT = 5,224 S.F.;
0.12 AC

5' RCP @ 0.90%
67.88
67.81

200' OF 15" RCP
@ 10.70% (INCLUDES
VDOT ES-1 END
SECTION)

35' DRAINAGE AND
ACCESS EASEMENT

155' OF 15" RCP
@ 0.48%

30' DRAINAGE/
ACCESS EASEMENT

LIMITS OF
NON-RPA
WETLANDS

BASED
TER-
CATED
ATION

INV. OUT=66.60

CLEARING

SS # 4-5
STA. 108+50
VDOT STD DI-5
TYPE III GRATE
FLOWLINE INV=55.36
INV=51.00

SS # 4-2
STA. 108+50
VDOT STD DI-5
TYPE III GRATE
FLOWLINE INV=55.36
INV=45.00 (SS# 4-5)
INV=41.08 (SS# 4-3)

20' DRAINAGE
EASEMENT 86' OF 18" RCP
@ 1.26% (INCLUDES
VDOT ES-1 END
SECTION)

SS # 4-1
INV=40.00

14'x14' STILLING BASIN
CLASS 1 RIP-RAP
d50=6"
EMBED 18" MINIMUM
OVER FILTER CLOTH
(33 C.Y.±)
BOTTOM ELEV.=39.0

BMP 7.2
TIMBER STRUCTURE
(SEE DETAIL SHEET 14)
TOP ELEV=30.0
LENGTH=50'±

25' BUFFER/SETBACK
BASED ON 100 YEAR
HIGH WATER ELEVATION
TO BE DEDICATED TO THE
STONEHOUSE HOMEOWNERS
ASSOCIATION

15' MAINTENANCE
EASEMENT BASED
ON 100 YEAR HIGH
WATER ELEVATION
TO BE DEDICATED TO
THE STONEHOUSE
HOMEOWNERS
ASSOCIATION

BMP 7.2
POOL ELEV.
1 YR.=28.67
2 YR.=29.28
100 YR.=30.42

SS # 3-4
STA. 15+92
VDOT STD DI-5
TYPE III GRATE
FLOWLINE INV=62.48
INV=60.15

RIP-RAP OUTLET PROTECTION
d50=6" MIN. 18" DEPTH
GROUTED-IN-PLACE
(APPROX. 34 C.Y.)

PROVIDE
EC-3
MATTING ON
FILL/SLOPE

DRAINAGE
EMENT

EXISTING
TREELINE

35' DRAINAGE AND
ACCESS EASEMENTS

0' DRAINAGE/
ACCESS EASEMENT

BMP 7.1
TIMBER STRUCTURE
(SEE DETAIL SHEET 14)
TOP ELEV=28.5
LENGTH=120'±

100 YEAR
FLOOD ELEV.
28.74
AREA OF PERMANENT
NON-RPA WETLAND IMPACT
S.F.; 0.09 AC

RIP-RAP OUTLET PROTECTION
d50=6" MIN. 18" DEPTH
GROUTED-IN-PLACE
(APPROX. 73 C.Y.)

#7.1
WC078

#7.2
WC077

CA-47

CA-45D

21

24

23

25

19

20

29

30

31

32

33

34

35

36

37

38

39


SO

SO

PS

PS

AN
NO

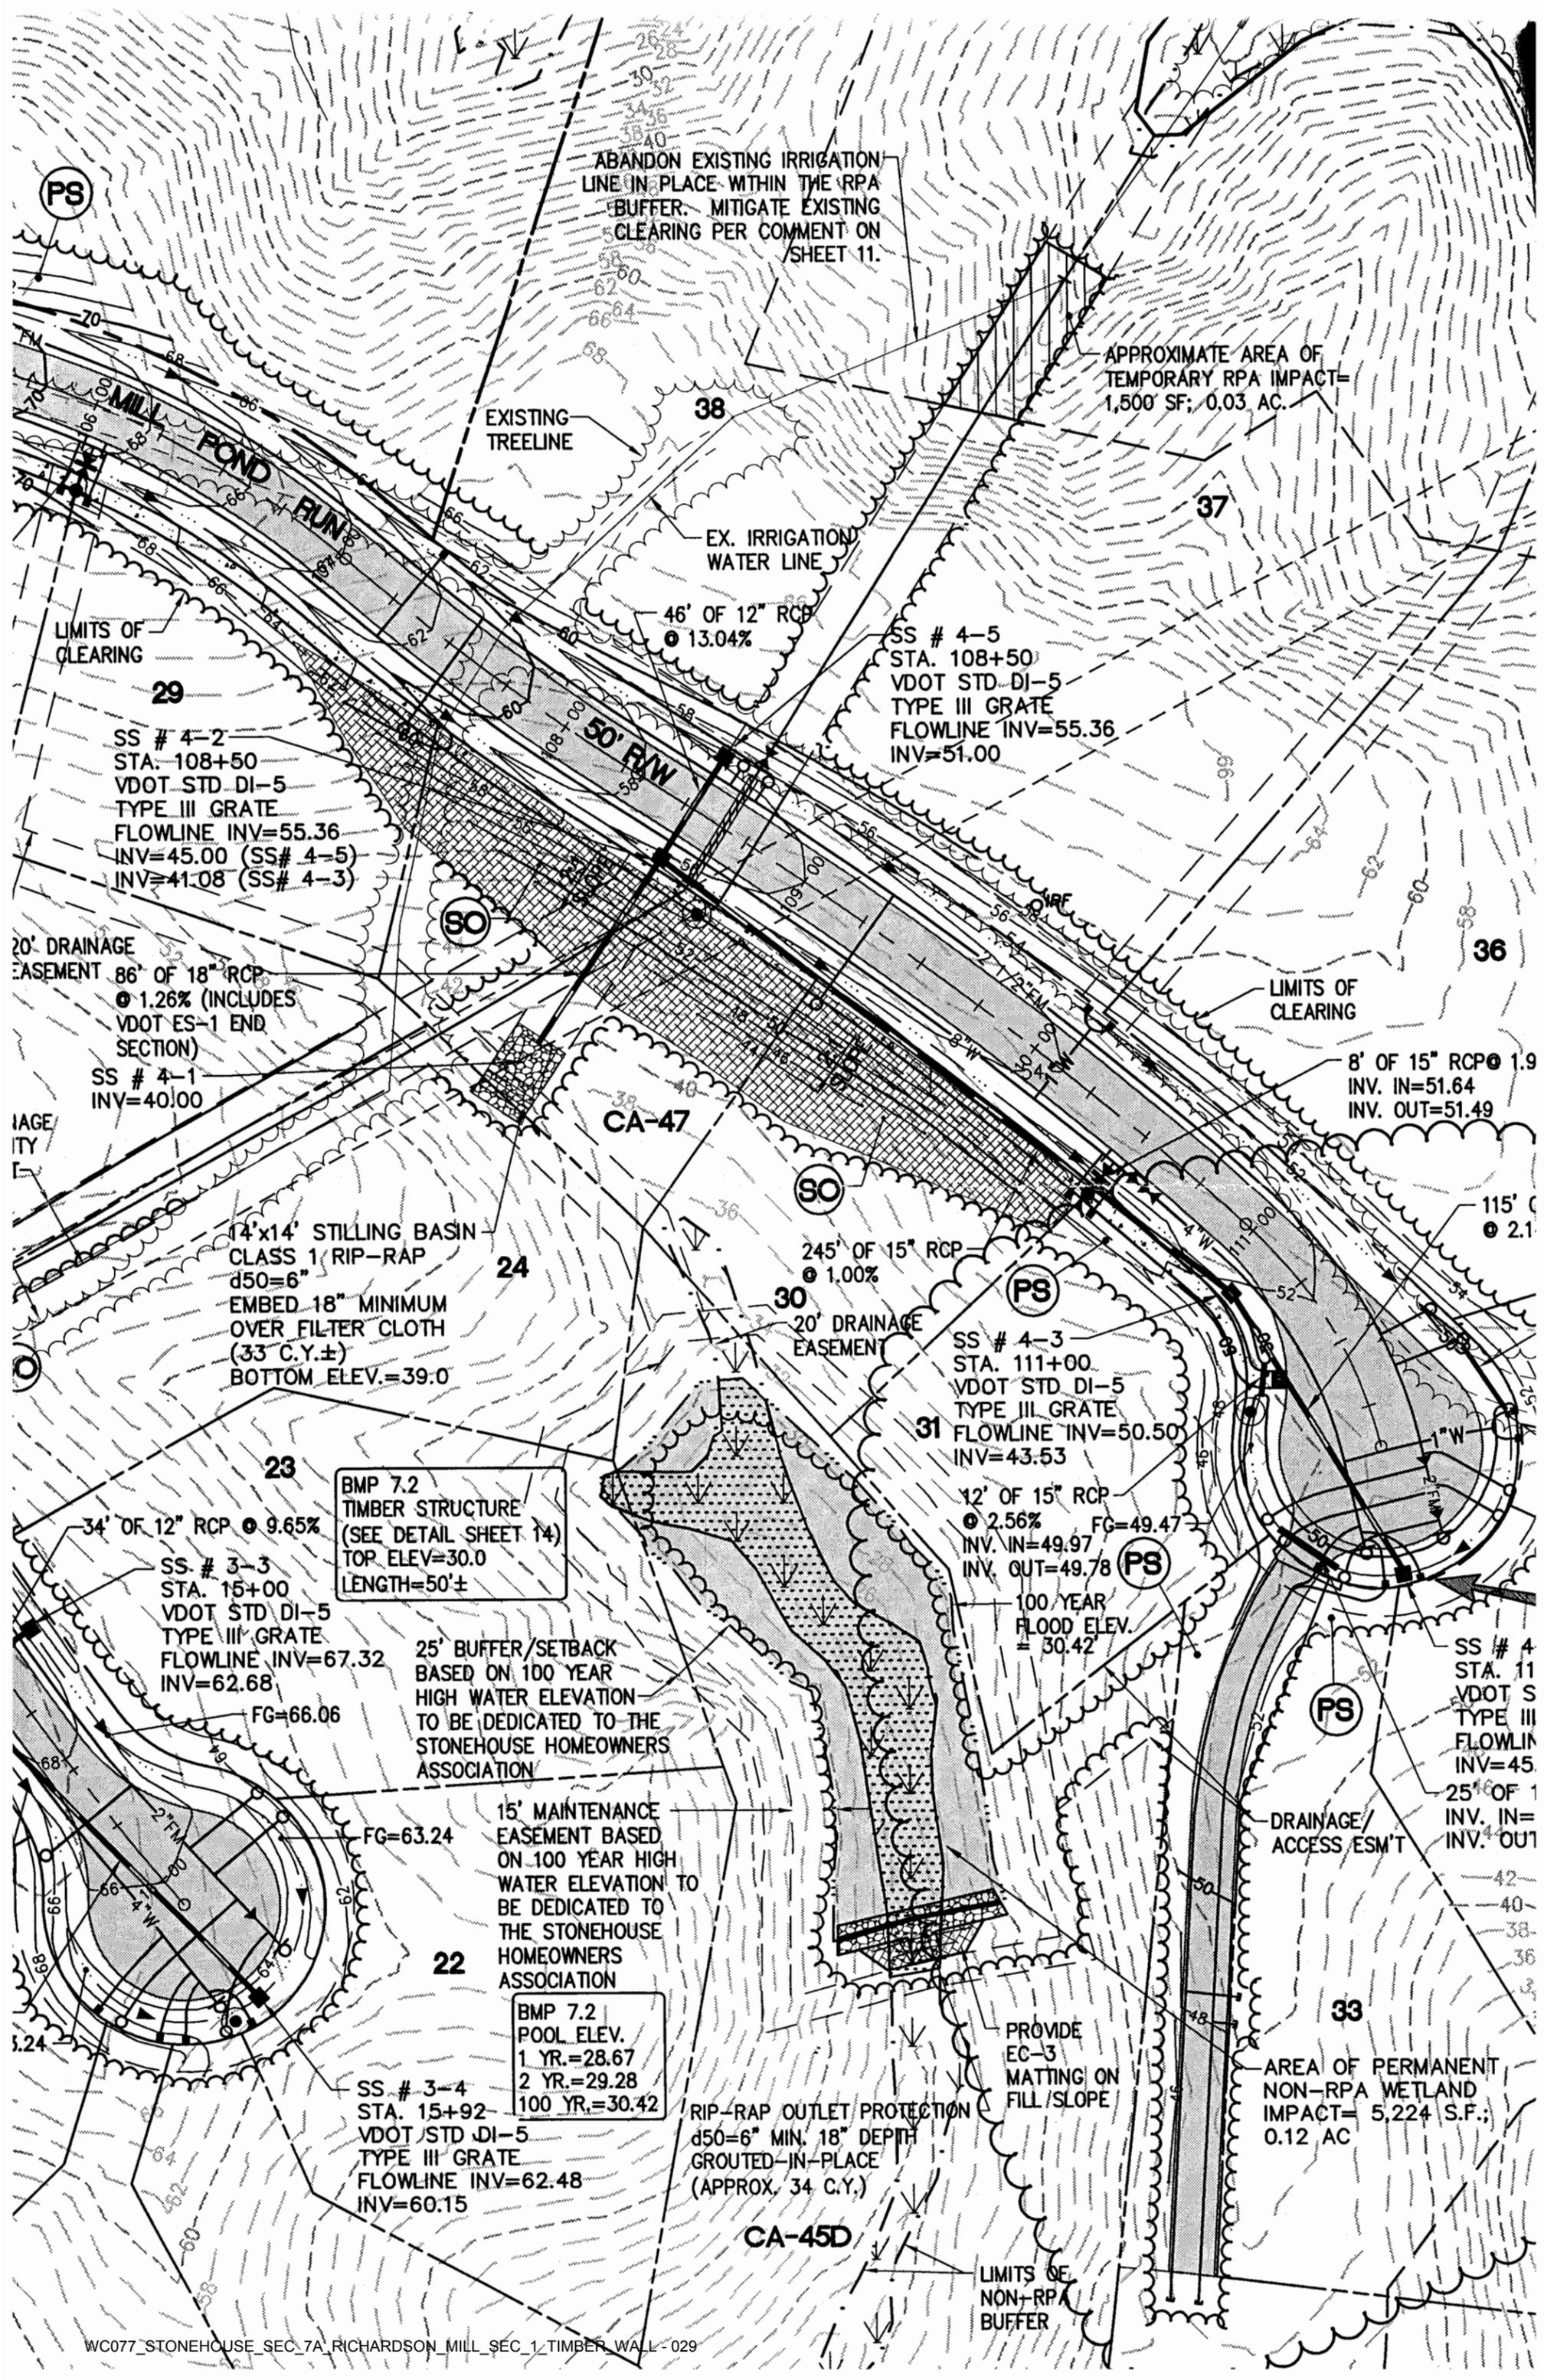

ABANDON EXISTING IRRIGATION LINE IN PLACE WITHIN THE RPA BUFFER. MITIGATE EXISTING CLEARING PER COMMENT ON SHEET 11.

APPROXIMATE AREA OF TEMPORARY RPA IMPACT= 1,500 SF; 0.03 AC.

EXISTING TREELINE

EX. IRRIGATION WATER LINE

46' OF 12" RCP @ 13.04%

SS # 4-5
STA. 108+50
VDOT STD DI-5
TYPE III GRATE
FLOWLINE INV=55.36
INV=51.00

LIMITS OF CLEARING

SS # 4-2
STA. 108+50
VDOT STD DI-5
TYPE III GRATE
FLOWLINE INV=55.36
INV=45.00 (SS# 4-5)
INV=41.08 (SS# 4-3)

20' DRAINAGE EASEMENT
86' OF 18" RCP @ 1.26% (INCLUDES VDOT ES-1 END SECTION)

SS # 4-1
INV=40.00

LIMITS OF CLEARING

8' OF 15" RCP @ 1.9
INV. IN=51.64
INV. OUT=51.49

14'x14' STILLING BASIN - CLASS 1 RIP-RAP d50=6" EMBED 18" MINIMUM OVER FILTER CLOTH (33 C.Y.±) BOTTOM ELEV.=39.0

245' OF 15" RCP @ 1.00%

20' DRAINAGE EASEMENT

SS # 4-3
STA. 111+00
VDOT STD DI-5
TYPE III GRATE
FLOWLINE INV=50.50
INV=43.53

12' OF 15" RCP @ 2.56% FG=49.47
INV. IN=49.97
INV. OUT=49.78

100 YEAR FLOOD ELEV. = 30.42

BMP 7.2
TIMBER STRUCTURE (SEE DETAIL SHEET 14)
TOP ELEV=30.0
LENGTH=50'±

34' OF 12" RCP @ 9.65%

SS # 3-3
STA. 15+00
VDOT STD DI-5
TYPE III GRATE
FLOWLINE INV=67.32
INV=62.68
FG=66.06

25' BUFFER/SETBACK BASED ON 100 YEAR HIGH WATER ELEVATION TO BE DEDICATED TO THE STONEHOUSE HOMEOWNERS ASSOCIATION

15' MAINTENANCE EASEMENT BASED ON 100 YEAR HIGH WATER ELEVATION TO BE DEDICATED TO THE STONEHOUSE HOMEOWNERS ASSOCIATION

BMP 7.2
POOL ELEV.
1 YR.=28.67
2 YR.=29.28
100 YR.=30.42

SS # 3-4
STA. 15+92
VDOT STD DI-5
TYPE III GRATE
FLOWLINE INV=62.48
INV=60.15

RIP-RAP OUTLET PROTECTION d50=6" MIN. 18" DEPTH GROUTED-IN-PLACE (APPROX. 34 C.Y.)

PROVIDE EC-3 MATTING ON FILL/SLOPE

DRAINAGE/ACCESS ESM'T

AREA OF PERMANENT NON-RPA WETLAND IMPACT= 5,224 S.F.; 0.12 AC

CA-45D

LIMITS OF NON-RPA BUFFER

Hydrograph Summary Report

Hyd. No.	Hydrograph type (origin)	Peak flow (cfs)	Time interval (min)	Time to peak (min)	Volume (cuft)	Inflow hyd(s)	Maximum elevation (ft)	Maximum storage (cuft)	Hydrograph description
1	SCS Runoff	2.89	2	746	20,547	---	---	---	PRE-DEV. RUNOFF
3	SCS Runoff	9.89	2	726	31,724	---	---	---	POST-DEV. RUNOFF
5	Reservoir	0.43	2	930	31,566	3	28.67	21,712	BMP ROUTED
7	Reservoir	0.40	2	946	30,729	3	28.28	32,929	SED BASIN ROUTED

PREDEV

DA = 9.34 AC.
 CN = 70
 TL = 50 MIN

2- 5.37 CFS
 10- 8.45 CFS
 100 26.46 CFS

POST DEV

7.93 AC
 80
 19 MIN.

14.96 CFS
 20.70 CFS
 50.68 CFS

Routed BMP

1-YR 0.43 CFS @ EL. 28.67
 2-YR 1.65 CFS @ EL. 29.28
 10-YR 6.16 CFS @ EL. 29.81
 100-YR 49.78 CFS @ EL. 30.42 OHW

BMP 7.2
 WC 077

Proj. file: 90280872.gpw	Return Period: 1 yr	Run date: 07-26-2002
--------------------------	---------------------	----------------------

Hydrograph Summary Report

Hyd. No.	Hydrograph type (origin)	Peak flow (cfs)	Time interval (min)	Time to peak (min)	Volume (cuft)	Inflow hyd(s)	Maximum elevation (ft)	Maximum storage (cuft)	Hydrograph description	
1	SCS Runoff	5.37	2	744	34,179	---	----	----	PRE-DEV. RUNOFF	
3	SCS Runoff	14.96	2	724	47,104	---	----	----	POST-DEV. RUNOFF	
5	Reservoir	1.65	2	770	46,861	3	29.28	27,446	BMP ROUTED	
7	Reservoir	1.01	2	818	45,642	3	29.16	41,161	SED BASIN ROUTED	
Proj. file: 90280872.gpw				Return Period: 2 yr			Run date: 07-26-2002			

Hydrograph Summary Report

Hyd. No.	Hydrograph type (origin)	Peak flow (cfs)	Time interval (min)	Time to peak (min)	Volume (cuft)	Inflow hyd(s)	Maximum elevation (ft)	Maximum storage (cuft)	Hydrograph description	
1	SCS Runoff	8.45	2	744	50,828	---	----	----	PRE-DEV. RUNOFF	
3	SCS Runoff	20.70	2	724	64,768	---	----	----	POST-DEV. RUNOFF	
5	Reservoir	6.16	2	742	64,488	3	29.81	32,459	BMP ROUTED	
7	Reservoir	4.40	2	746	63,146	3	29.63	45,582	SED BASIN ROUTED	
Proj. file: 90280872.gpw				Return Period: 10 yr			Run date: 07-26-2002			

Hydrograph Summary Report

Hyd. No.	Hydrograph type (origin)	Peak flow (cfs)	Time interval (min)	Time to peak (min)	Volume (cuft)	Inflow hyd(s)	Maximum elevation (ft)	Maximum storage (cuft)	Hydrograph description	
1	SCS Runoff	26.46	2	744	149,902	---	----	----	PRE-DEV. RUNOFF	
3	SCS Runoff	50.68	2	724	160,572	---	----	----	POST-DEV. RUNOFF	
5	Reservoir	49.78	2	726	160,241	3	30.42	40,089	BMP ROUTED	
7	Reservoir	49.62	2	726	158,699	3	30.42	54,855	SED BASIN ROUTED	
Proj. file: 90280872.gpw				Return Period: 100 yr			Run date: 07-26-2002			

Hydrograph Plot

Hydraflow Hydrographs by Intelisolve


Hyd. No. 1

PRE-DEV. RUNOFF

Hydrograph type = SCS Runoff
Storm frequency = 1 yrs
Drainage area = 9.34 ac
Basin Slope = 12.0 %
Tc method = USER
Total precip. = 2.80 in
Storm duration = 24 hrs

Peak discharge = 2.89 cfs
Time interval = 2 min
Curve number = 70
Hydraulic length = 875 ft
Time of conc. (Tc) = 50 min
Distribution = Type II
Shape factor = 484

Hydrograph Volume = 20,547 cuft

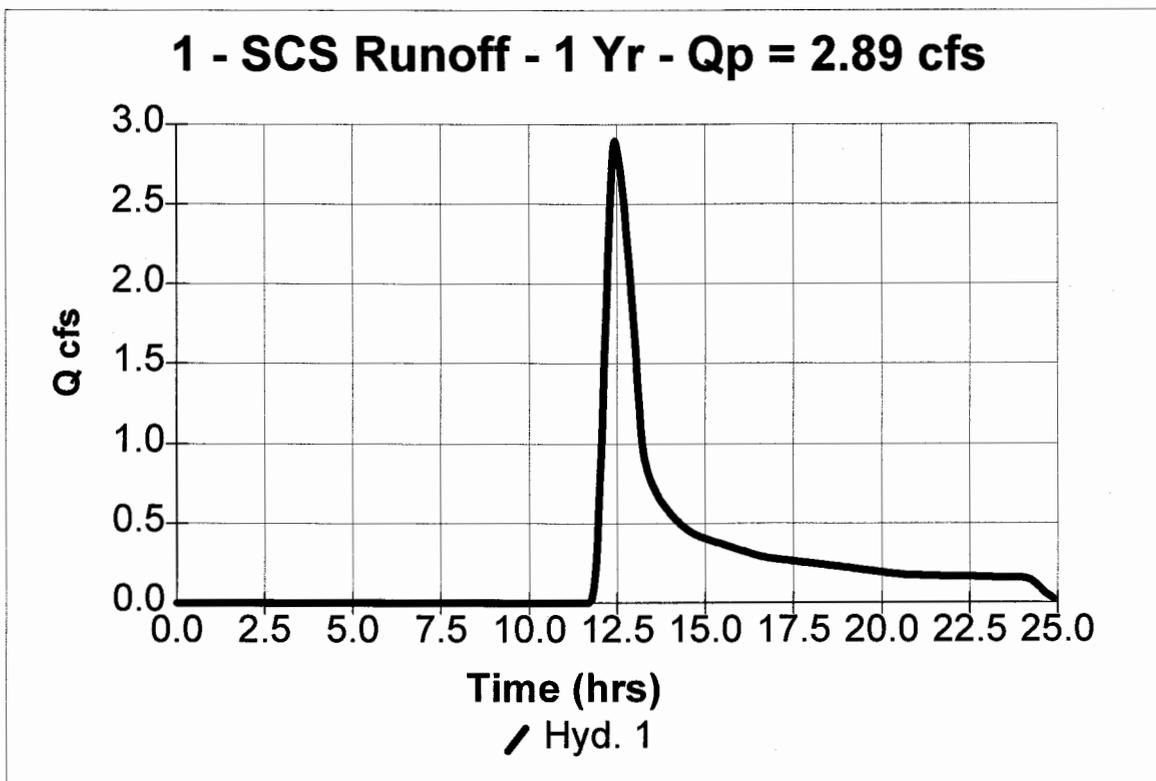

Hydrograph Plot

Hydraflow Hydrographs by Intelisolve


Hyd. No. 1

PRE-DEV. RUNOFF

Hydrograph type = SCS Runoff
Storm frequency = 2 yrs
Drainage area = 9.34 ac
Basin Slope = 12.0 %
Tc method = USER
Total precip. = 3.50 in
Storm duration = 24 hrs

Peak discharge = 5.37 cfs
Time interval = 2 min
Curve number = 70
Hydraulic length = 875 ft
Time of conc. (Tc) = 50 min
Distribution = Type II
Shape factor = 484

Hydrograph Volume = 34,179 cuft

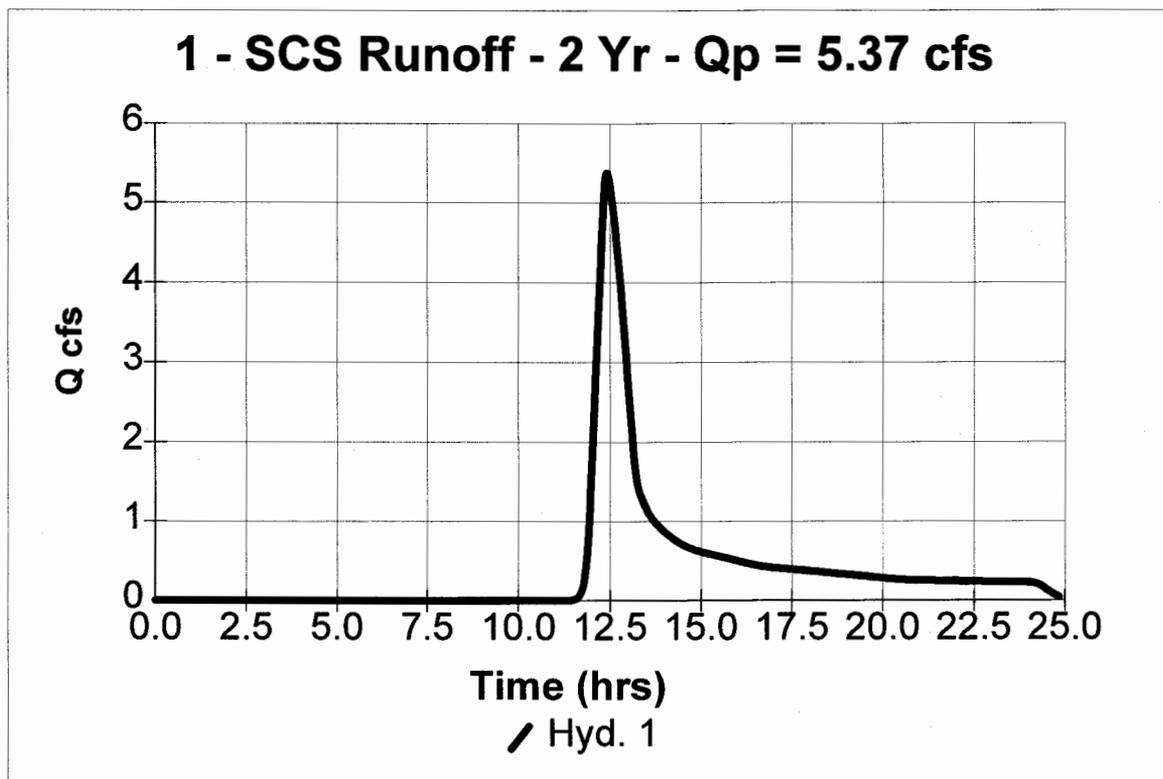

Hydrograph Plot

Hydraflow Hydrographs by Intelisolve


Hyd. No. 1

PRE-DEV. RUNOFF

Hydrograph type = SCS Runoff
Storm frequency = 10 yrs
Drainage area = 9.34 ac
Basin Slope = 12.0 %
Tc method = USER
Total precip. = 4.25 in
Storm duration = 24 hrs

Peak discharge = 8.45 cfs
Time interval = 2 min
Curve number = 70
Hydraulic length = 875 ft
Time of conc. (Tc) = 50 min
Distribution = Type II
Shape factor = 484

Hydrograph Volume = 50,828 cuft

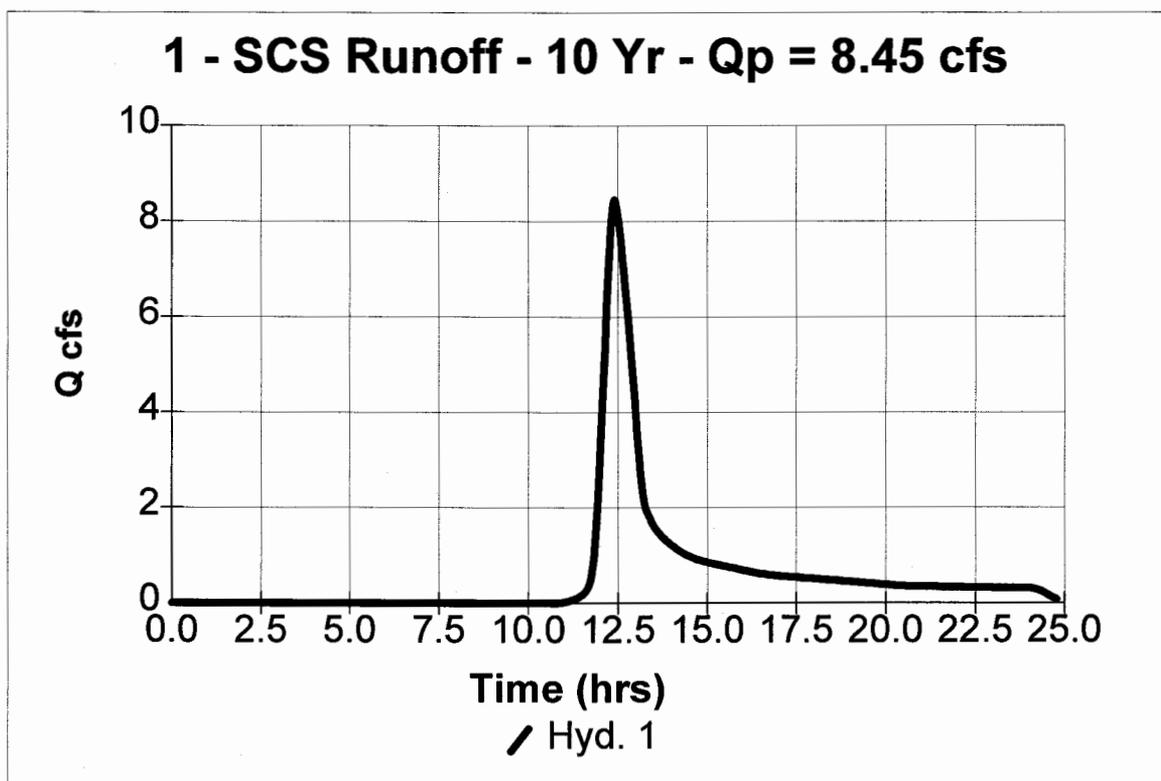

Hydrograph Plot


Hydraflow Hydrographs by Intelisolve

Hyd. No. 1

PRE-DEV. RUNOFF

Hydrograph type	= SCS Runoff	Peak discharge	= 26.46 cfs
Storm frequency	= 100 yrs	Time interval	= 2 min
Drainage area	= 9.34 ac	Curve number	= 70
Basin Slope	= 12.0 %	Hydraulic length	= 875 ft
Tc method	= USER	Time of conc. (Tc)	= 50 min
Total precip.	= 7.95 in	Distribution	= Type II
Storm duration	= 24 hrs	Shape factor	= 484

Hydrograph Volume = 149,902 cuft

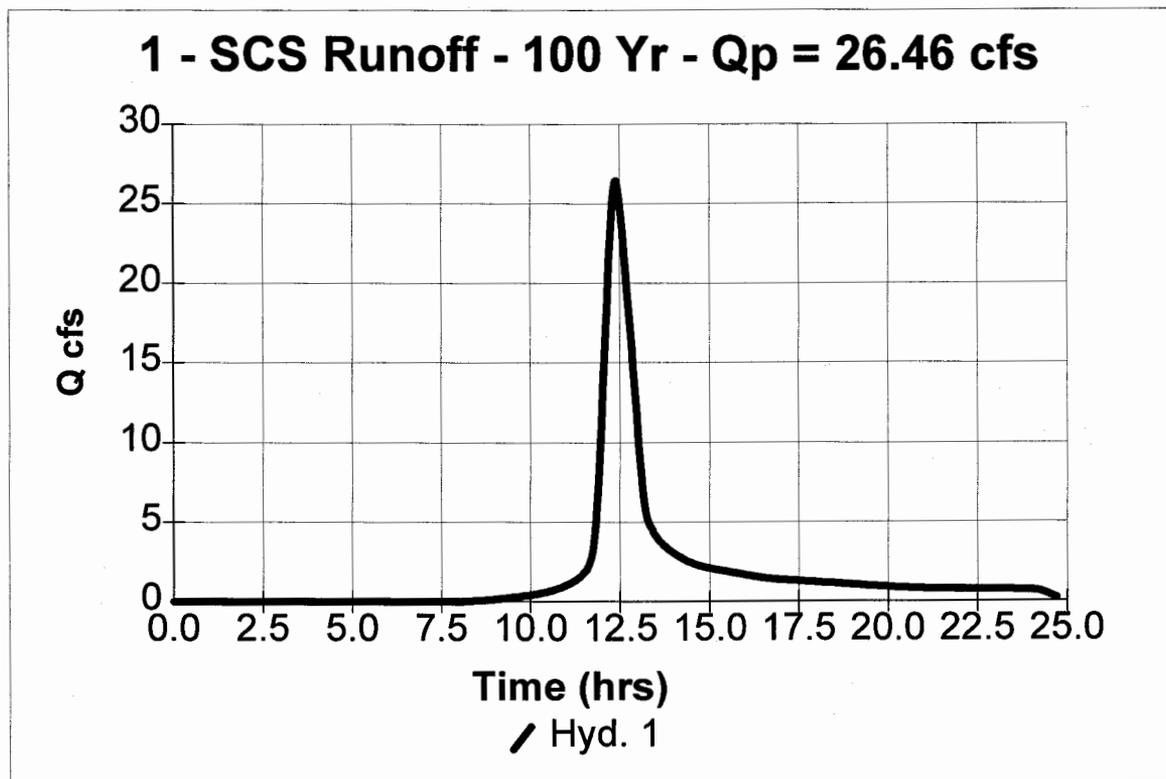

Hydrograph Plot

Hydraflow Hydrographs by Intelisolve


Hyd. No. 3

POST-DEV. RUNOFF

Hydrograph type = SCS Runoff
Storm frequency = 1 yrs
Drainage area = 7.93 ac
Basin Slope = 10.0 %
Tc method = USER
Total precip. = 2.80 in
Storm duration = 24 hrs

Peak discharge = 9.89 cfs
Time interval = 2 min
Curve number = 80
Hydraulic length = 855 ft
Time of conc. (Tc) = 19 min
Distribution = Type II
Shape factor = 484

Hydrograph Volume = 31,724 cuft

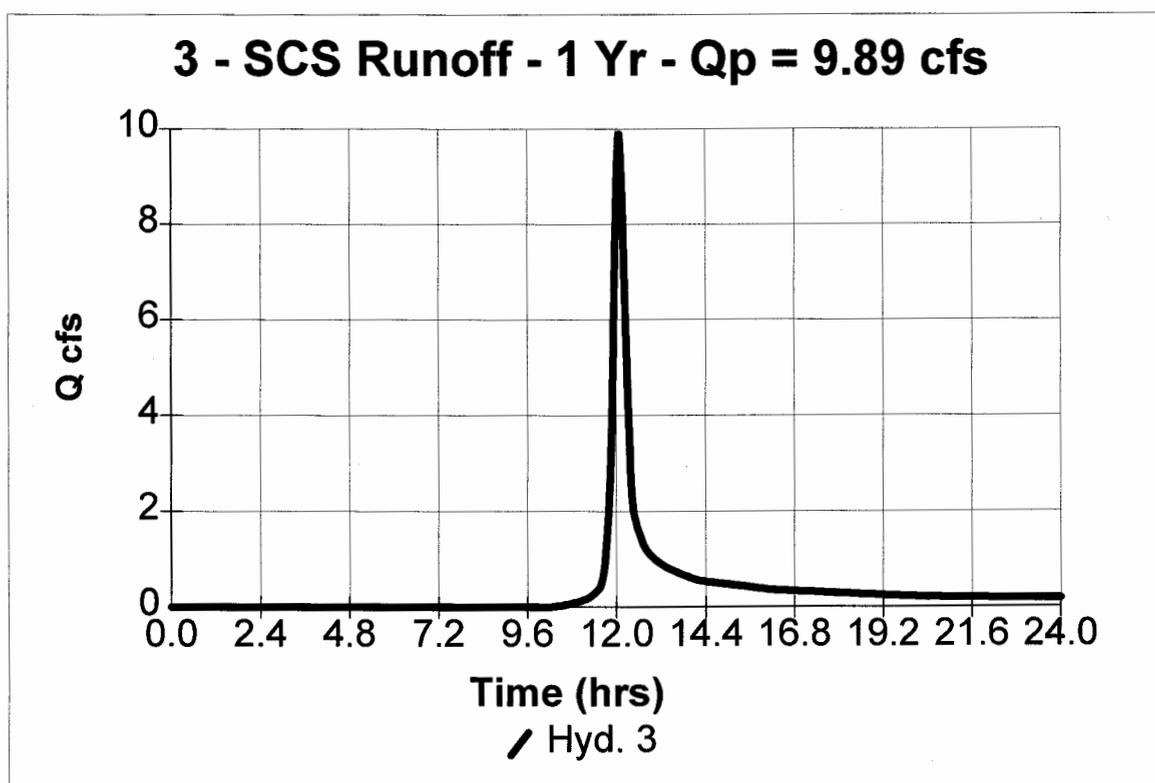

Hydrograph Plot

Hydraflow Hydrographs by Intelisolve


Hyd. No. 3

POST-DEV. RUNOFF

Hydrograph type = SCS Runoff
Storm frequency = 2 yrs
Drainage area = 7.93 ac
Basin Slope = 10.0 %
Tc method = USER
Total precip. = 3.50 in
Storm duration = 24 hrs

Peak discharge = 14.96 cfs
Time interval = 2 min
Curve number = 80
Hydraulic length = 855 ft
Time of conc. (Tc) = 19 min
Distribution = Type II
Shape factor = 484

Hydrograph Volume = 47,104 cuft

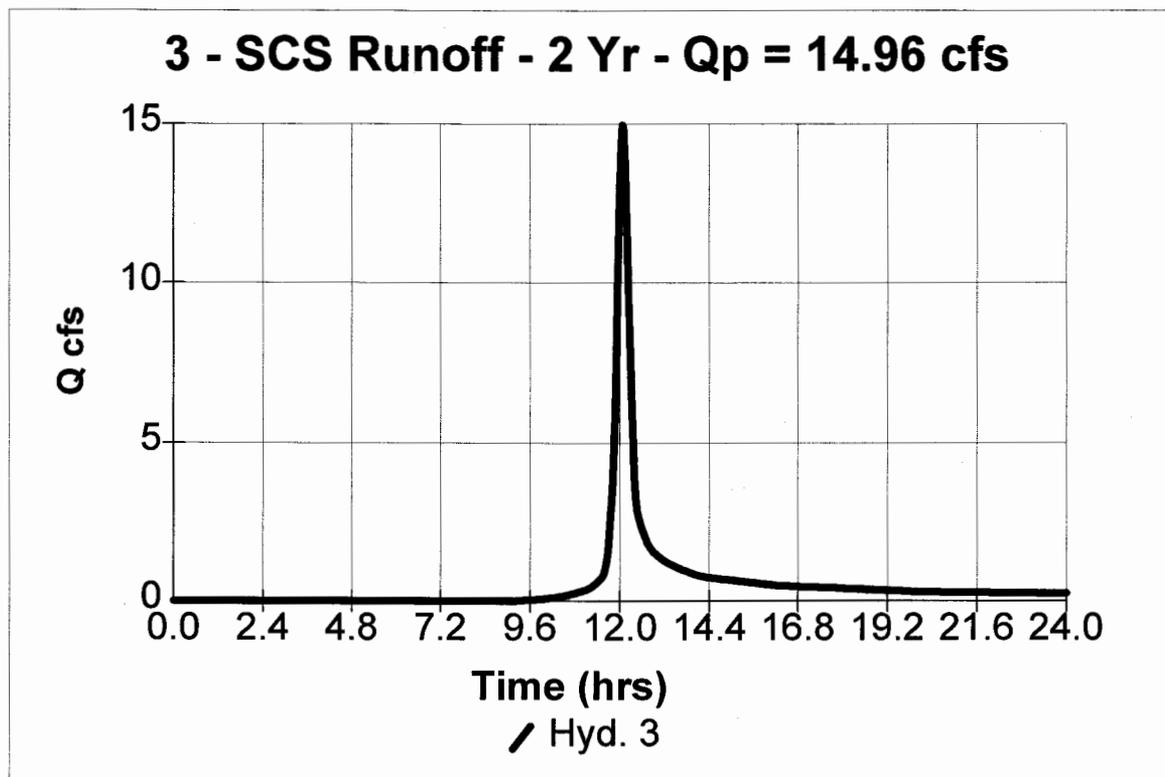

Hydrograph Plot

Hydraflow Hydrographs by Intelisolve


Hyd. No. 3

POST-DEV. RUNOFF

Hydrograph type = SCS Runoff
Storm frequency = 10 yrs
Drainage area = 7.93 ac
Basin Slope = 10.0 %
Tc method = USER
Total precip. = 4.25 in
Storm duration = 24 hrs

Peak discharge = 20.70 cfs
Time interval = 2 min
Curve number = 80
Hydraulic length = 855 ft
Time of conc. (Tc) = 19 min
Distribution = Type II
Shape factor = 484

Hydrograph Volume = 64,768 cuft

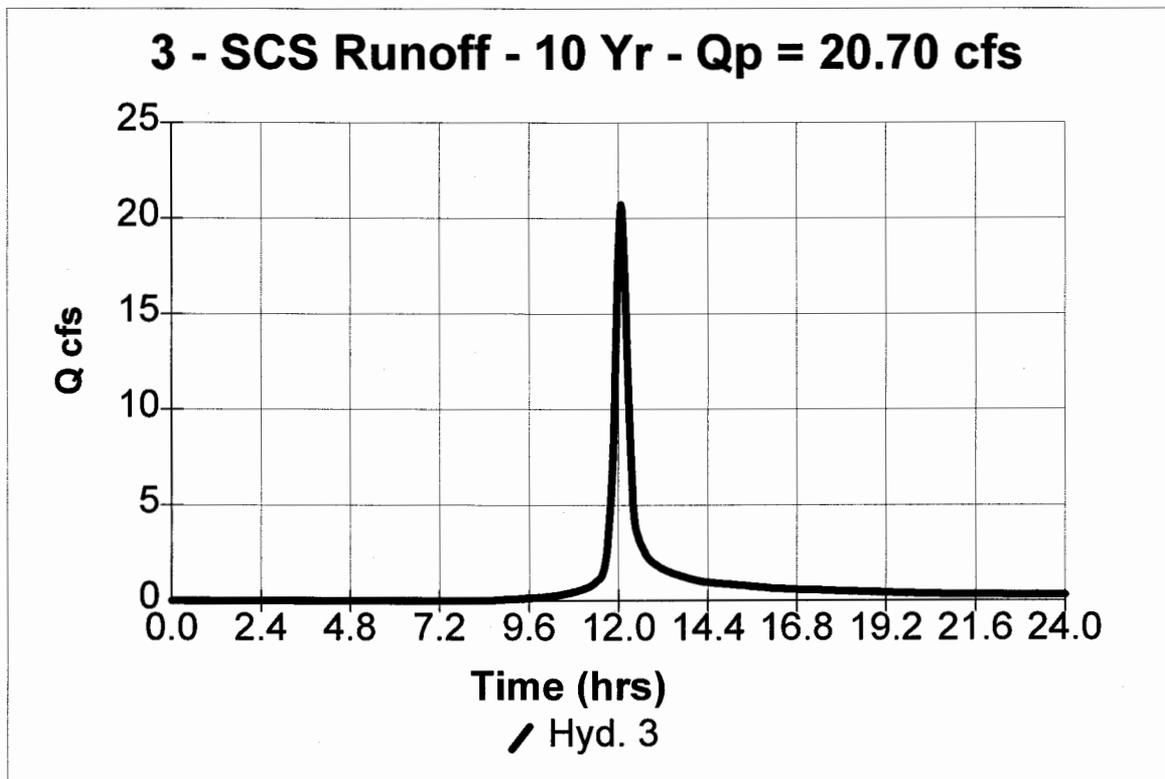

Hydrograph Plot

Hydraflow Hydrographs by Intelisolve


Hyd. No. 3

POST-DEV. RUNOFF

Hydrograph type = SCS Runoff
Storm frequency = 100 yrs
Drainage area = 7.93 ac
Basin Slope = 10.0 %
Tc method = USER
Total precip. = 7.95 in
Storm duration = 24 hrs

Peak discharge = 50.68 cfs
Time interval = 2 min
Curve number = 80
Hydraulic length = 855 ft
Time of conc. (Tc) = 19 min
Distribution = Type II
Shape factor = 484

Hydrograph Volume = 160,572 cuft

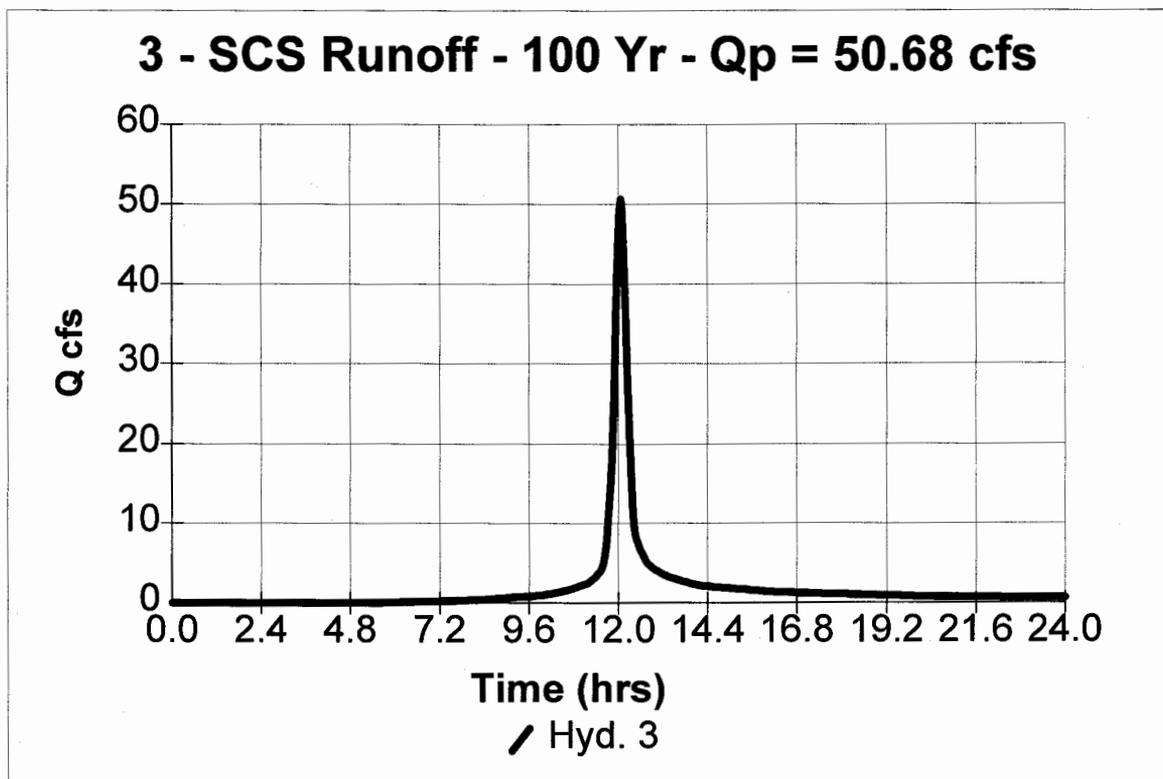

Reservoir Report

Reservoir No. 1 - TIMBER WALL 7.2

Hydraflow Hydrographs by Intelisolve

Pond Data

Pond storage is based on known contour areas. Average end area method used.

Stage / Storage Table

Stage (ft)	Elevation (ft)	Contour area (sqft)	Incr. Storage (cuft)	Total storage (cuft)
0.00	21.00	00	0	0
1.00	22.00	35	18	18
3.00	24.00	829	864	882
5.00	26.00	3,183	4,012	4,894
7.00	28.00	7,322	10,505	15,399
9.00	30.00	11,554	18,876	34,275
11.00	32.00	15,961	27,515	61,790

Culvert / Orifice Structures

	[A]	[B]	[C]	[D]
Rise in	= 3.0	0.0	0.0	0.0
Span in	= 3.0	0.0	0.0	0.0
No. Barrels	= 1	0	0	0
Invert El. ft	= 25.30	0.00	0.00	0.00
Length ft	= 5.0	0.0	0.0	0.0
Slope %	= 0.50	0.00	0.00	0.00
N-Value	= .013	.013	.000	.000
Orif. Coeff.	= 0.60	0.60	0.00	0.00
Multi-Stage	= n/a	No	No	No

Weir Structures

	[A]	[B]	[C]	[D]
Crest Len ft	= 50.00	3.00	0.00	0.00
Crest El. ft	= 30.00	29.00	0.00	0.00
Weir Coeff.	= 2.60	2.60	0.00	0.00
Weir Type	= Broad	Broad	---	---
Multi-Stage	= No	No	No	No

Exfiltration Rate = 0.00 in/hr/sqft Tailwater Elev. = 0.00 ft

Stage / Storage / Discharge Table

Note: All outflows have been analyzed under inlet and outlet control.

Stage ft	Storage cuft	Elevation ft	Clv A cfs	Clv B cfs	Clv C cfs	Clv D cfs	Wr A cfs	Wr B cfs	Wr C cfs	Wr D cfs	Exfil cfs	Total cfs
0.00	0	21.00	0.00	---	---	---	0.00	0.00	---	---	---	0.00
1.00	18	22.00	0.00	---	---	---	0.00	0.00	---	---	---	0.00
3.00	882	24.00	0.00	---	---	---	0.00	0.00	---	---	---	0.00
5.00	4,894	26.00	0.17	---	---	---	0.00	0.00	---	---	---	0.17
7.00	15,399	28.00	0.38	---	---	---	0.00	0.00	---	---	---	0.38
9.00	34,275	30.00	0.51	---	---	---	0.00	7.80	---	---	---	8.31
11.00	61,790	32.00	0.61	---	---	---	367.70	40.53	---	---	---	408.83

Hydrograph Plot

Hydraflow Hydrographs by Intelisolve

Hyd. No. 5


BMP ROUTED

Hydrograph type = Reservoir
Storm frequency = 1 yrs
Inflow hyd. No. = 3
Max. Elevation = 28.67 ft

Peak discharge = 0.43 cfs
Time interval = 2 min
Reservoir name = TIMBER WALL 7.2
Max. Storage = 21,712 cuft

Storage Indication method used.

Hydrograph Volume = 31,566 cuft

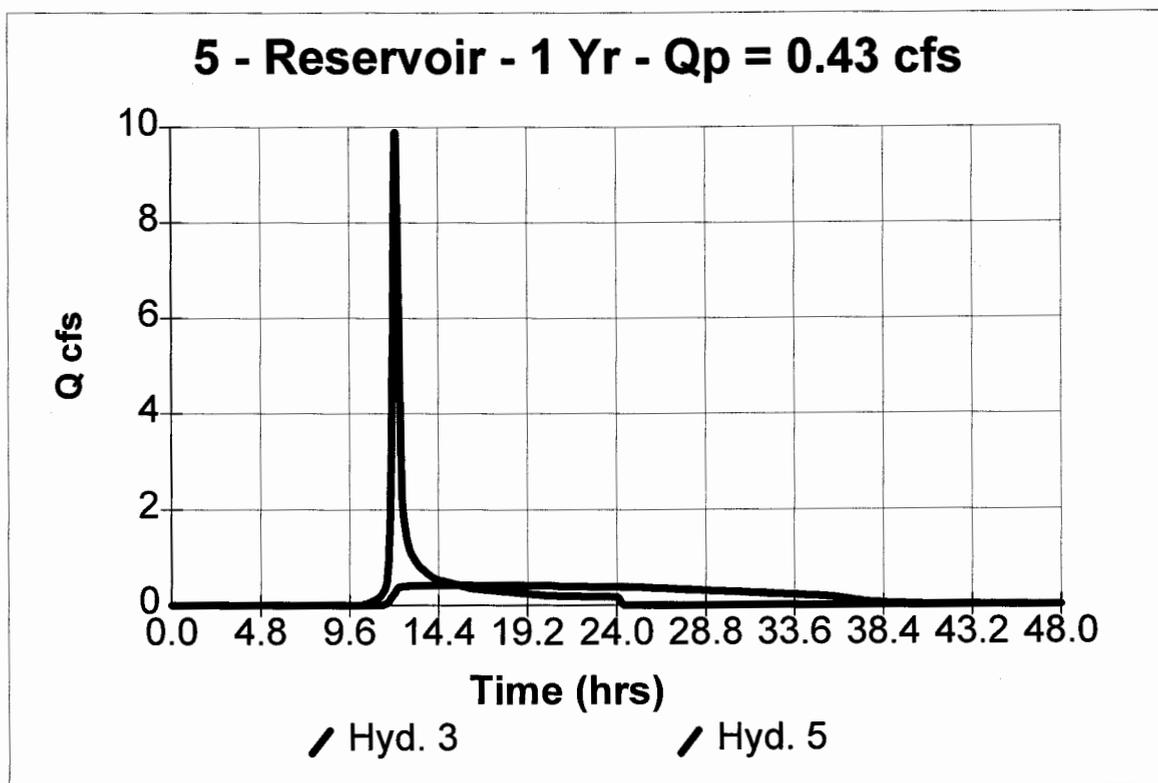

Hydrograph Plot

Hydraflow Hydrographs by Intelisolve

Hyd. No. 5


BMP ROUTED

Hydrograph type = Reservoir
Storm frequency = 2 yrs
Inflow hyd. No. = 3
Max. Elevation = 29.28 ft

Peak discharge = 1.65 cfs
Time interval = 2 min
Reservoir name = TIMBER WALL 7.2
Max. Storage = 27,446 cuft

Storage Indication method used.

Hydrograph Volume = 46,861 cuft

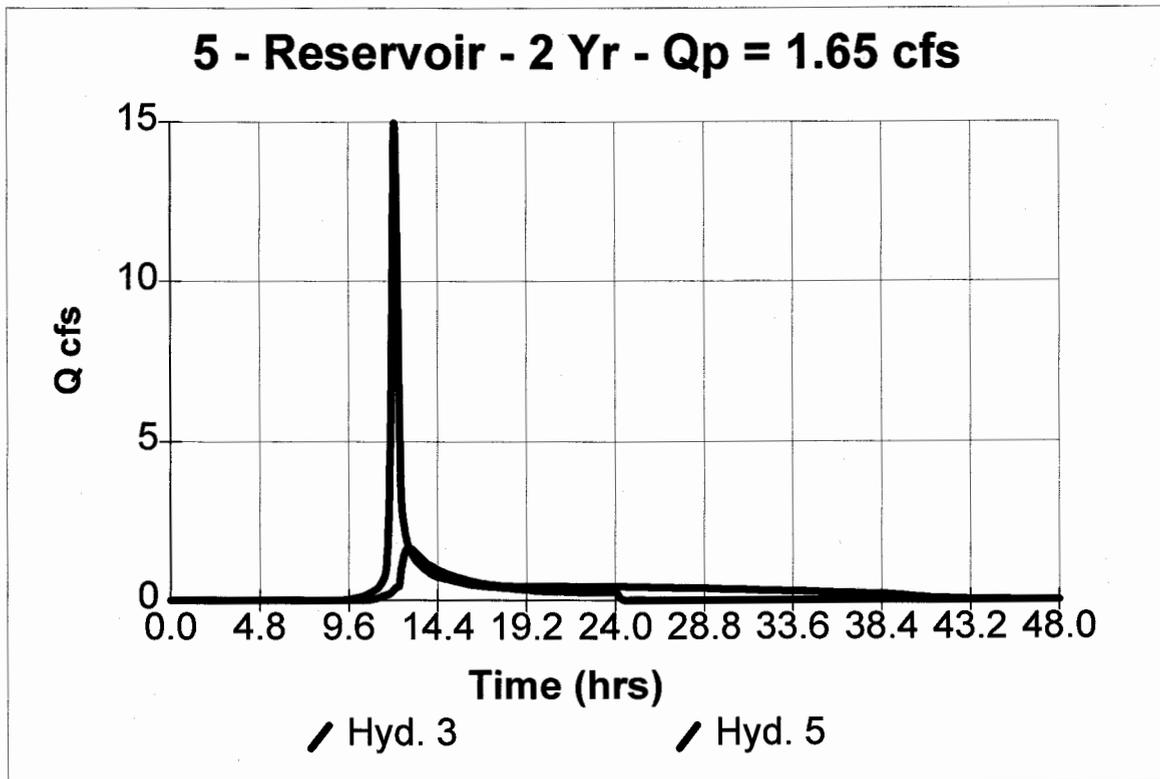

Hydrograph Plot

Hydraflow Hydrographs by Intelisolve

Hyd. No. 5


BMP ROUTED

Hydrograph type = Reservoir
Storm frequency = 10 yrs
Inflow hyd. No. = 3
Max. Elevation = 29.81 ft

Peak discharge = 6.16 cfs
Time interval = 2 min
Reservoir name = TIMBER WALL 7.2
Max. Storage = 32,459 cuft

Storage Indication method used.

Hydrograph Volume = 64,488 cuft

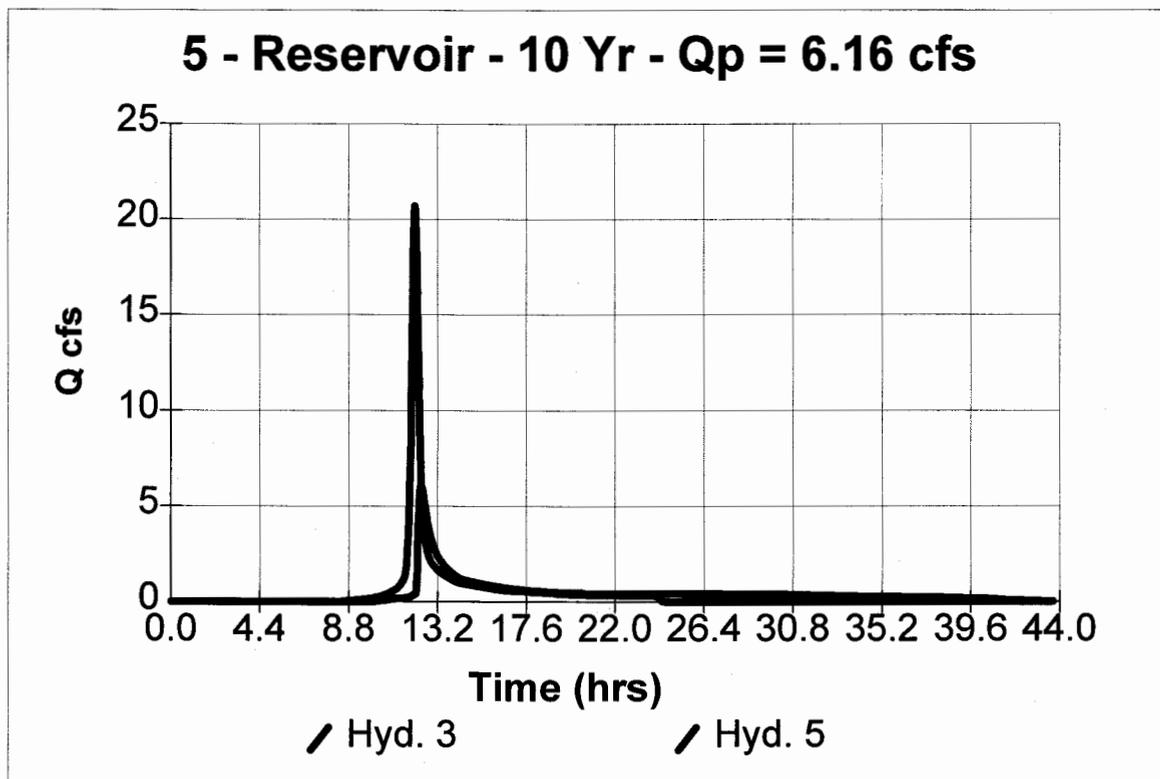

Hydrograph Plot

Hydraflow Hydrographs by Intelisolve

Hyd. No. 5


BMP ROUTED

Hydrograph type = Reservoir
Storm frequency = 100 yrs
Inflow hyd. No. = 3
Max. Elevation = 30.42 ft

Peak discharge = 49.78 cfs
Time interval = 2 min
Reservoir name = TIMBER WALL 7.2
Max. Storage = 40,089 cuft

Storage Indication method used.

Hydrograph Volume = 160,241 cuft

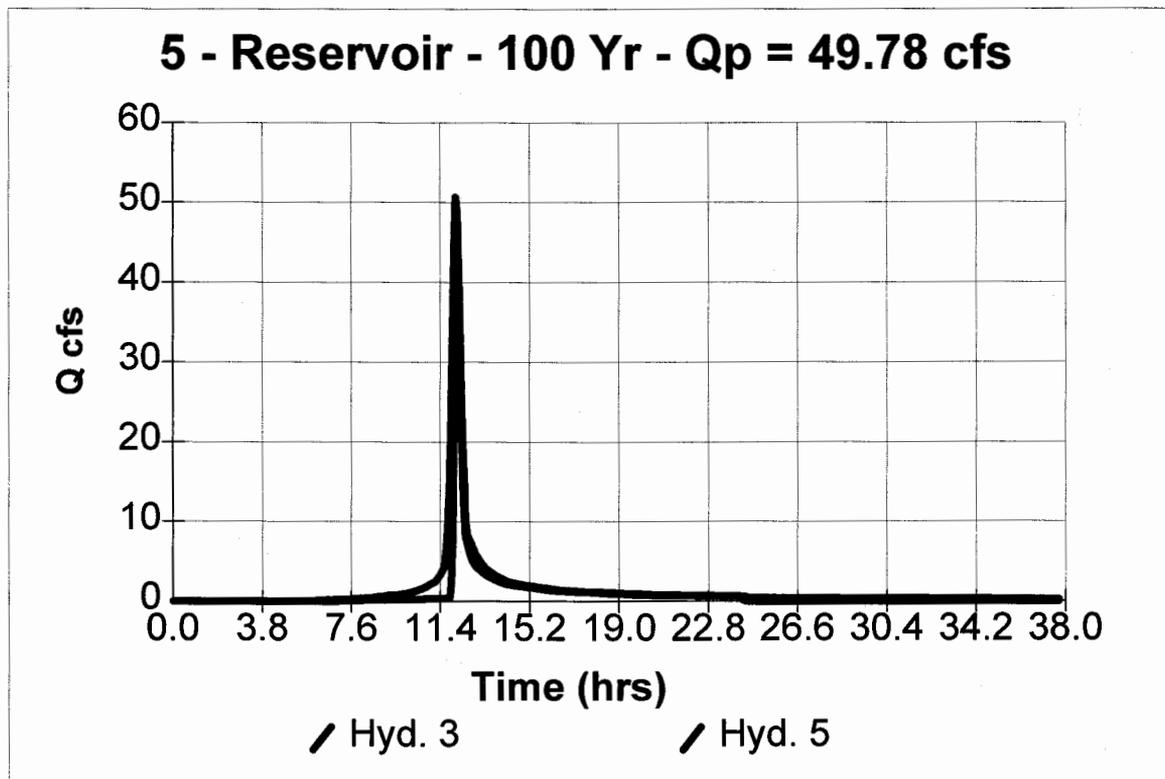

Reservoir Report

Reservoir No. 1 - TIMBER WALL 7.2

Hydraflow Hydrographs by Intelisolve

Pond Data

Pond storage is based on known contour areas. Average end area method used.

Stage / Storage Table

Stage (ft)	Elevation (ft)	Contour area (sqft)	Incr. Storage (cuft)	Total storage (cuft)
0.00	21.00	00	0	0
1.00	22.00	35	18	18
3.00	24.00	829	864	882
5.00	26.00	3,183	4,012	4,894
7.00	28.00	7,322	10,505	15,399
9.00	30.00	11,554	18,876	34,275
11.00	32.00	15,961	27,515	61,790

Culvert / Orifice Structures

	[A]	[B]	[C]	[D]
Rise in	= 3.0	0.0	0.0	0.0
Span in	= 3.0	0.0	0.0	0.0
No. Barrels	= 1	0	0	0
Invert El. ft	= 25.30	0.00	0.00	0.00
Length ft	= 5.0	0.0	0.0	0.0
Slope %	= 0.50	0.00	0.00	0.00
N-Value	= .013	.013	.000	.000
Orif. Coeff.	= 0.60	0.60	0.00	0.00
Multi-Stage	= n/a	No	No	No

Weir Structures

	[A]	[B]	[C]	[D]
Crest Len ft	= 50.00	3.00	0.00	0.00
Crest El. ft	= 30.00	29.00	0.00	0.00
Weir Coeff.	= 2.60	2.60	0.00	0.00
Weir Type	= Broad	Broad	---	---
Multi-Stage	= No	No	No	No

Exfiltration Rate = 0.00 in/hr/sqft Tailwater Elev. = 0.00 ft

Note: All outflows have been analyzed under inlet and outlet control.

Stage / Storage / Discharge Table

Stage ft	Storage cuft	Elevation ft	Civ A cfs	Civ B cfs	Civ C cfs	Civ D cfs	Wr A cfs	Wr B cfs	Wr C cfs	Wr D cfs	Exfil cfs	Total cfs
0.00	0	21.00	0.00	---	---	---	0.00	0.00	---	---	---	0.00
1.00	18	22.00	0.00	---	---	---	0.00	0.00	---	---	---	0.00
3.00	882	24.00	0.00	---	---	---	0.00	0.00	---	---	---	0.00
5.00	4,894	26.00	0.17	---	---	---	0.00	0.00	---	---	---	0.17
7.00	15,399	28.00	0.38	---	---	---	0.00	0.00	---	---	---	0.38
9.00	34,275	30.00	0.51	---	---	---	0.00	7.80	---	---	---	8.31
11.00	61,790	32.00	0.61	---	---	---	367.70	40.53	---	---	---	408.83

Hydrograph Plot

Hydraflow Hydrographs by Intelisolve

Hyd. No. 7


SED BASIN ROUTED

Hydrograph type = Reservoir
Storm frequency = 25 yrs
Inflow hyd. No. = 3
Max. Elevation = 30.22 ft

Peak discharge = 24.72 cfs
Time interval = 2 min
Reservoir name = SED BASIN 7.2
Max. Storage = 52,073 cuft


Storage Indication method used.

Hydrograph Volume = 101,078 cuft

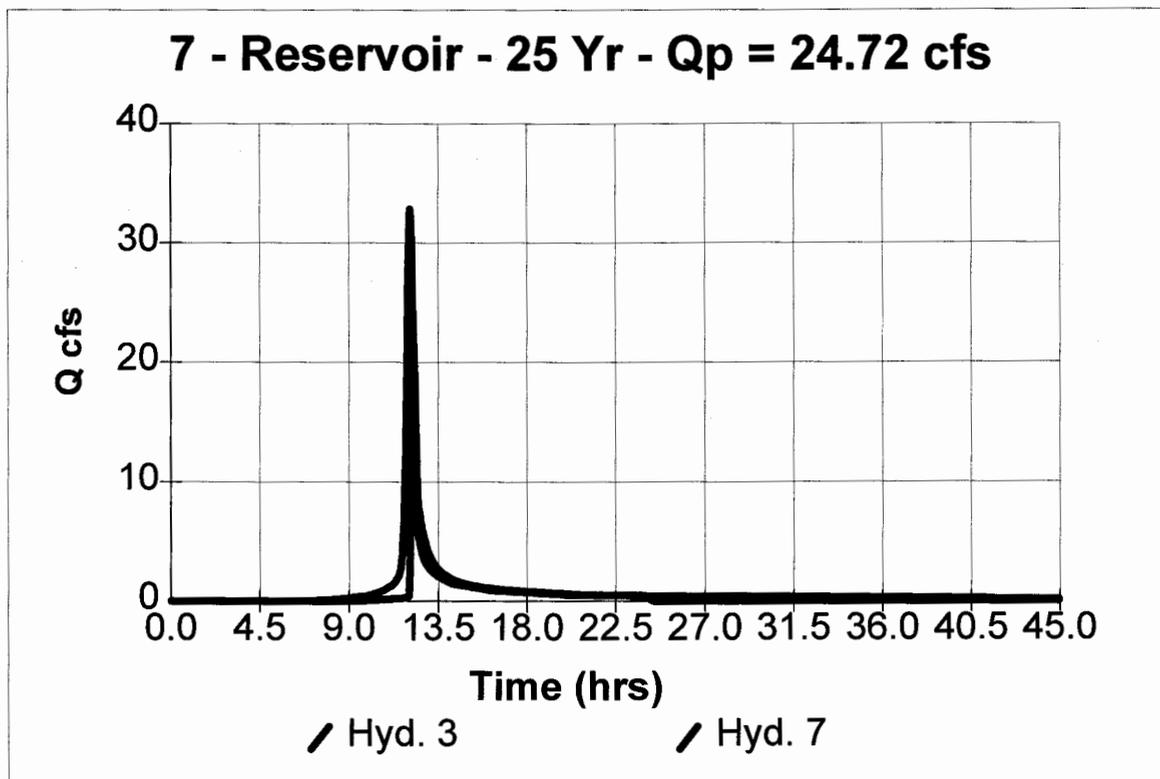

Adequate Channel Analysis for Outfall of Storm System 1
 Stonehouse Richardson's Mill Phase 1
 10/26/2001 (Revised 7/30/02)
 Project No. 9028-08

CHANNEL GEOMETRY
 Parabolic Channel

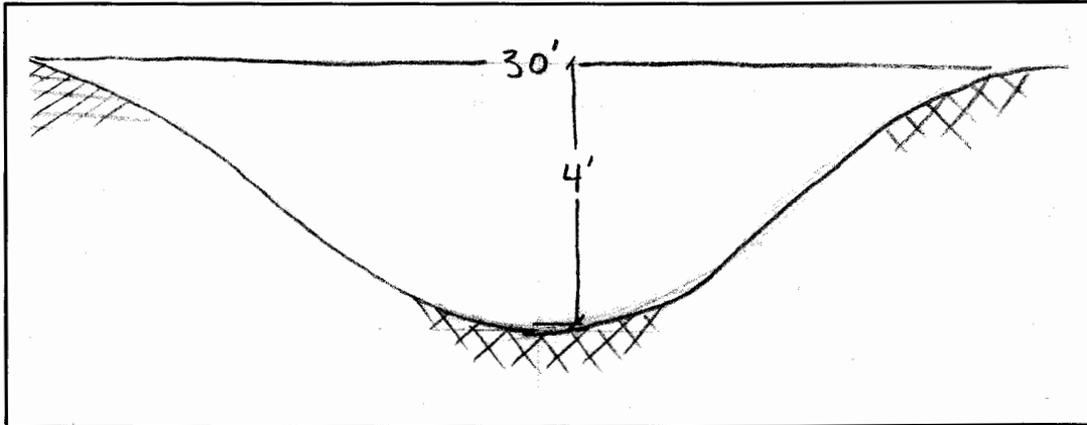

TOP WIDTH =	30 FT
HEIGHT =	4 FT
SLOPE (S)	0.28 FT/FT
MANNING'S N	0.20

CALCULATION OF CHANNEL CAPACITY AND VELOCITY

MANNING'S EQUATION

$$V = 1.49 / N * R^{2/3} * S^{1/2}$$

WHERE:

V = AVERAGE VELOCITY
 N = MANNING'S ROUGHNESS COEF.
 R = HYDRAULIC RADIUS = A / WP
 S = SLOPE OF CHANNEL
 A = AREA OF CROSS SECTION
 WP = WETTED PERIMETER

MANNING'S ROUGHNESS COEF.

N1 = CHANNEL IN EARTH	0.02 (Earthen Channel)
N2 = EROSION	0.02 (Side slopes eroded)
N3 = SIZE/SHAPE OF CHANN	0.005 (Channel shape changes slightly over length)
N4 = OBSTRUCTIONS	0.05 (flow obstructed by trees and large amounts of underbrush)
N5 = VEGETATION	0.075 (trees and underbrush)
N6 = MEANDER	<u>0.15</u> (Flow line meanders through trees and underbrush)

$$N = (N1 + N2 + N3 + N4 + N5) * N6 + (N1 + N2 + N3 + N4 + N5)$$

$$N = \underline{0.20}$$

SOIL TYPE

SANDY LOAM

MAX. PERMISSIBLE VELOCITY = 2.5 FT/S

2-YEAR STORM EVENT

TIME OF CONCENTRATION 5.7 min
 RAINFALL INTENSITY = 6.9 in/hr
 RUNOFF COEF. = 0.77
 DRAINAGE AREA = 0.7 Ac.

PEAK FLOW RATE = 2.84 CFS (SEE HYDROGRAPH)
 PEAK VELOCITY = 2.01 FT/S

*** VELOCITY FOR POST DEVELOPMENT 2-YEAR STORM IS LESS THAN MAXIMUM PERMISSIBLE VELOCITY OF 2.50 ft/s THEREFORE, CHANNEL IS ADEQUATE.**

10-YEAR STORM EVENT

PEAK FLOW RATE = 3.70 CFS (SEE HYDROGRAPH)

*** 10 yr storm event results in a depth within the confines of the channel**

Depth (FT)	Incremental Top Width (FT)	Area (SQ FT)	Wetted Perimeter (FT)	Hydraulic Radius (FT)	Velocity (FT/SEC)	Flow (CFS)
0.00	0.00	0.00	0.00	0.00	0.00	0.00
0.02	2.83	0.04	12.00	0.01	0.24	0.01
0.04	4.00	0.11	24.01	0.03	0.42	0.04
0.06	4.90	0.20	36.01	0.05	0.58	0.11
0.08	5.66	0.30	48.03	0.08	0.74	0.22
0.10	6.32	0.42	60.04	0.11	0.91	0.38
0.12	6.93	0.55	72.06	0.14	1.07	0.60
0.14	7.48	0.70	84.08	0.17	1.25	0.87
0.16	8.00	0.85	96.10	0.21	1.42	1.21
0.18	8.49	1.02	108.13	0.25	1.60	1.63
0.20	8.94	1.19	120.16	0.29	1.78	2.12
0.22	9.38	1.38	132.19	0.34	1.97	2.70
0.22	9.47	1.42	134.76	0.35	2.01	2.84
0.24	9.80	1.57	144.23	0.39	2.15	3.38
0.25	9.97	1.65	149.48	0.41	2.24	3.70


Hydrograph Plot

Hyd. No. 1

STORM SYSTEM 1

Hydrograph type	= Rational	Peak discharge	= 2.84 cfs
Storm frequency	= 2 yrs	Time interval	= 1 min
Drainage area	= 0.7 ac	Runoff coeff.	= 0.77
Intensity	= 5.275 in/hr	Time of conc. (Tc)	= 6 min
IDF Curve	= JCChydrographs.IDF	Asc/Rec limb fact	= 1/2

Hydrograph Volume = 1,535 cuft

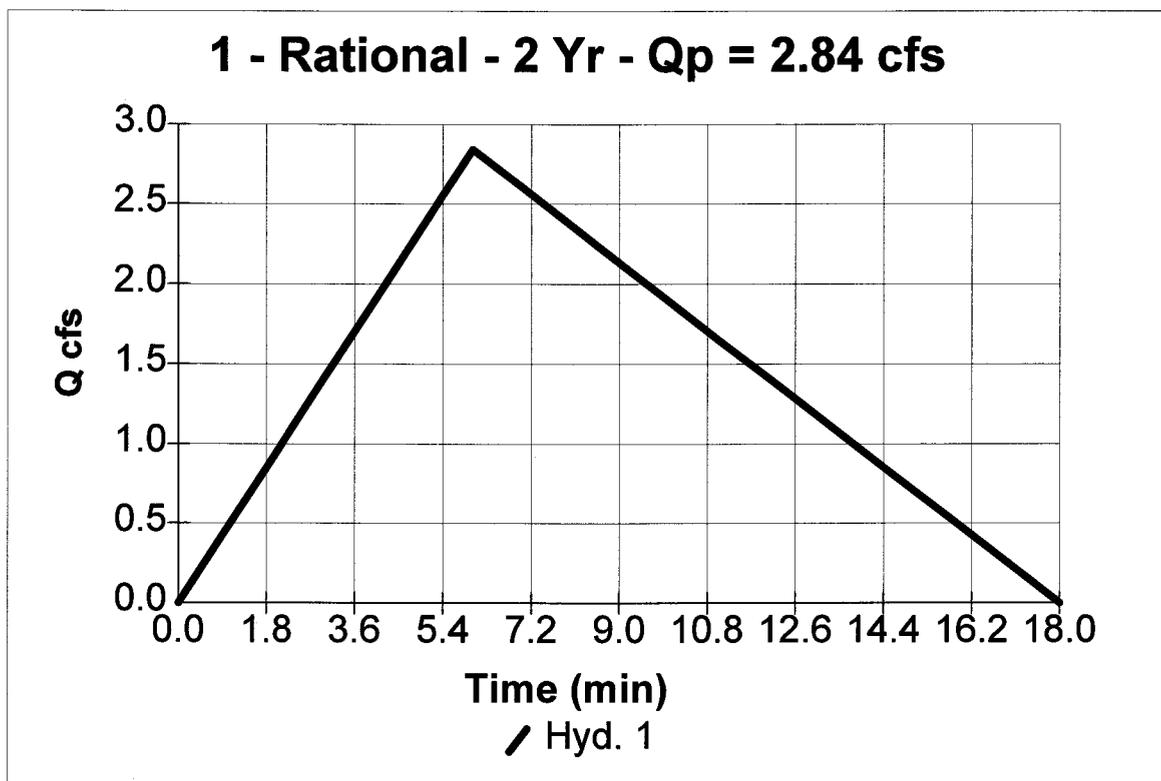

Hydrograph Plot


Hyd. No. 1

STORM SYSTEM 1

Hydrograph type = Rational
Storm frequency = 10 yrs
Drainage area = 0.7 ac
Intensity = 6.859 in/hr
IDF Curve = JCChydrographs.IDF

Peak discharge = 3.70 cfs
Time interval = 1 min
Runoff coeff. = 0.77
Time of conc. (Tc) = 6 min
Asc/Rec limb fact = 1/2

Hydrograph Volume = 1,996 cuft

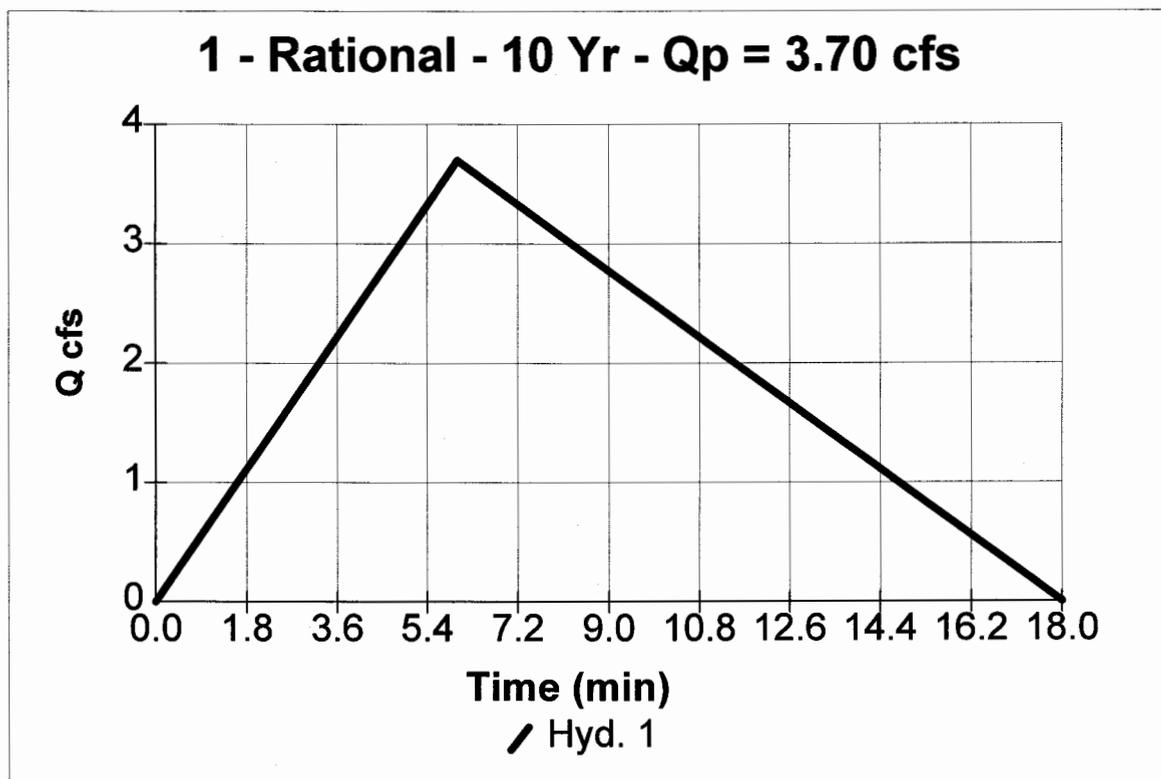


Adequate Channel Analysis for Outfall of Storm System 2

Stonehouse Richardson's Mill Phase 1

10/26/2001(Revised 7/30/02)

Project No. 9028-08

CHANNEL GEOMETRY

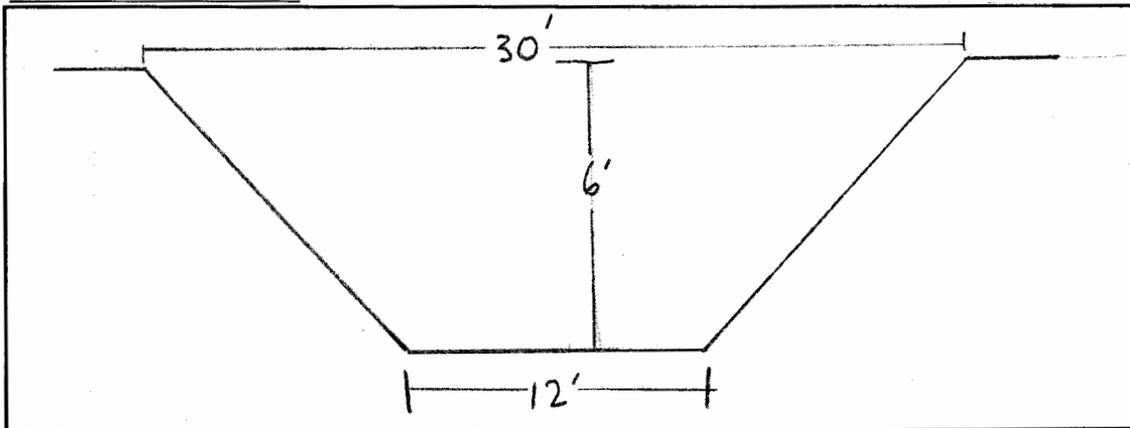

TOP WIDTH =	30 FT
BOTTOM WIDTH =	12 FT
HEIGHT =	6 FT
Z =	1.5 FT
SLOPE (S)	0.05 FT/FT
MANNING'S N	0.20

CALCULATION OF CHANNEL CAPACITY AND VELOCITY

MANNING'S EQUATION

$$V = 1.49 / N * R^{2/3} * S^{1/2}$$

WHERE:

- V = AVERAGE VELOCITY
- N = MANNING'S ROUGHNESS COEF.
- R = HYDRAULIC RADIUS = A / WP
- S = SLOPE OF CHANNEL
- A = AREA OF CROSS SECTION
- WP = WETTED PERIMETER

MANNING'S ROUGHNESS COEF.

N1 = CHANNEL IN EARTH	0.02 (Earthen Channel)
N2 = EROSION	0.01 (Side slopes eroded)
N3 = SIZE/SHAPE OF CHANN	0.005 (Channel shape changes slightly over length)
N4 = OBSTRUCTIONS	0.04 (flow obstructed by large trees and underbrush)
N5 = VEGETATION	0.1 (trees and underbrush)
N6 = MEANDER	0.15 (Flow line meanders through trees and underbrush)

$$N = (N1 + N2 + N3 + N4 + N5) * N6 + (N1 + N2 + N3 + N4 + N5)$$

$$N = 0.20$$

SOIL TYPE

SANDY LOAM

MAX. PERMISSIBLE VELOCITY = 2.5 FT /SEC

2-YEAR STORM EVENT

TIME OF CONCENTRATION 5.7 min
RAINFALL INTENSITY = 6.9 in/hr
RUNOFF COEF. = 0.77
DRAINAGE AREA = 0.8 Ac.

PEAK FLOW RATE = 9.70 CFS (SEE HYDROGRAPH)
PEAK VELOCITY = 1.20 FT/S

* VELOCITY FOR POST DEVELOPMENT 2-YEAR STORM IS LESS THAN MAXIMUM PERMISSIBLE VELOCITY OF 2.50 ft/s THEREFORE, CHANNEL IS ADEQUATE.

10-YEAR STORM EVENT

PEAK FLOW RATE = 12.71 CFS (SEE HYDROGRAPH)

* 10 yr storm event results in a depth within the confines of the channel

<u>Incremental</u>			<u>Hydraulic</u>		
<u>Depth</u>	<u>Area</u>	<u>WP</u>	<u>Radius</u>	<u>Velocity</u>	<u>Flow</u>
(FT)	(SQ FT)	(FT)	(FT)	(FT/SEC)	(CFS)
0.00	0.00	12.00	0.00	0.00	0.00
0.05	0.60	12.10	0.05	0.23	0.14
0.10	1.22	12.20	0.10	0.36	0.43
0.15	1.83	12.30	0.15	0.47	0.86
0.20	2.46	12.40	0.20	0.57	1.39
0.25	3.09	12.50	0.25	0.66	2.03
0.30	3.74	12.60	0.30	0.74	2.77
0.35	4.38	12.70	0.35	0.82	3.59
0.40	5.04	12.80	0.39	0.89	4.51
0.45	5.70	12.90	0.44	0.97	5.51
0.50	6.38	13.00	0.49	1.04	6.60
0.55	7.05	13.10	0.54	1.10	7.78
0.60	7.74	13.20	0.59	1.17	9.03
0.63	8.09	13.25	0.61	1.20	9.70
0.65	8.43	13.30	0.63	1.23	10.37
0.70	9.14	13.40	0.68	1.29	11.79
0.73	9.58	13.46	0.71	1.33	12.71
0.75	9.84	13.50	0.73	1.35	13.28
0.80	10.56	13.60	0.78	1.41	14.86
0.85	11.28	13.70	0.82	1.46	16.52

Hydrograph Plot


Hyd. No. 2

STORM SYSTEM 2

Hydrograph type = Rational
Storm frequency = 2 yrs
Drainage area = 2.7 ac
Intensity = 5.047 in/hr
IDF Curve = JCChydrographs.IDF

Peak discharge = 9.70 cfs
Time interval = 1 min
Runoff coeff. = 0.72
Time of conc. (Tc) = 7 min
Asc/Rec limb fact = 1/2

Hydrograph Volume = 6,112 cuft

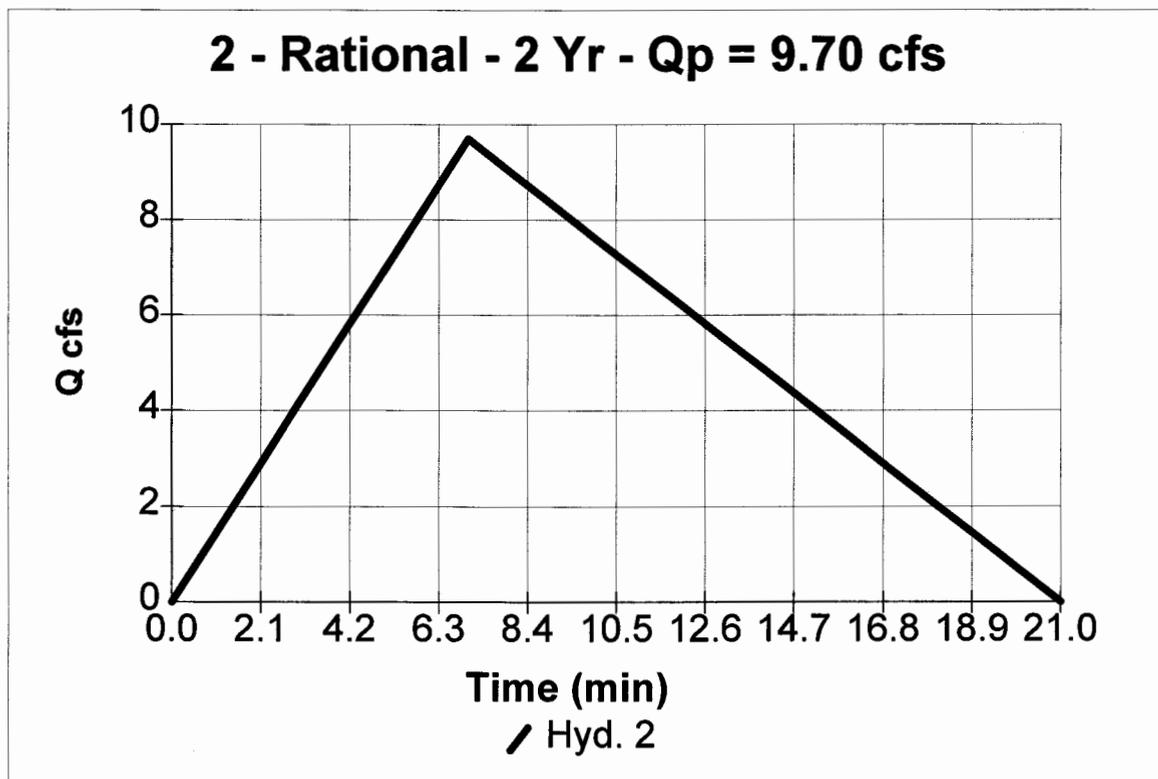

Hydrograph Plot


Hyd. No. 2

STORM SYSTEM 2

Hydrograph type = Rational
Storm frequency = 10 yrs
Drainage area = 2.7 ac
Intensity = 6.612 in/hr
IDF Curve = JCChydrographs.IDF

Peak discharge = 12.71 cfs
Time interval = 1 min
Runoff coeff. = 0.72
Time of conc. (Tc) = 7 min
Asc/Rec limb fact = 1/2

Hydrograph Volume = 8,007 cuft

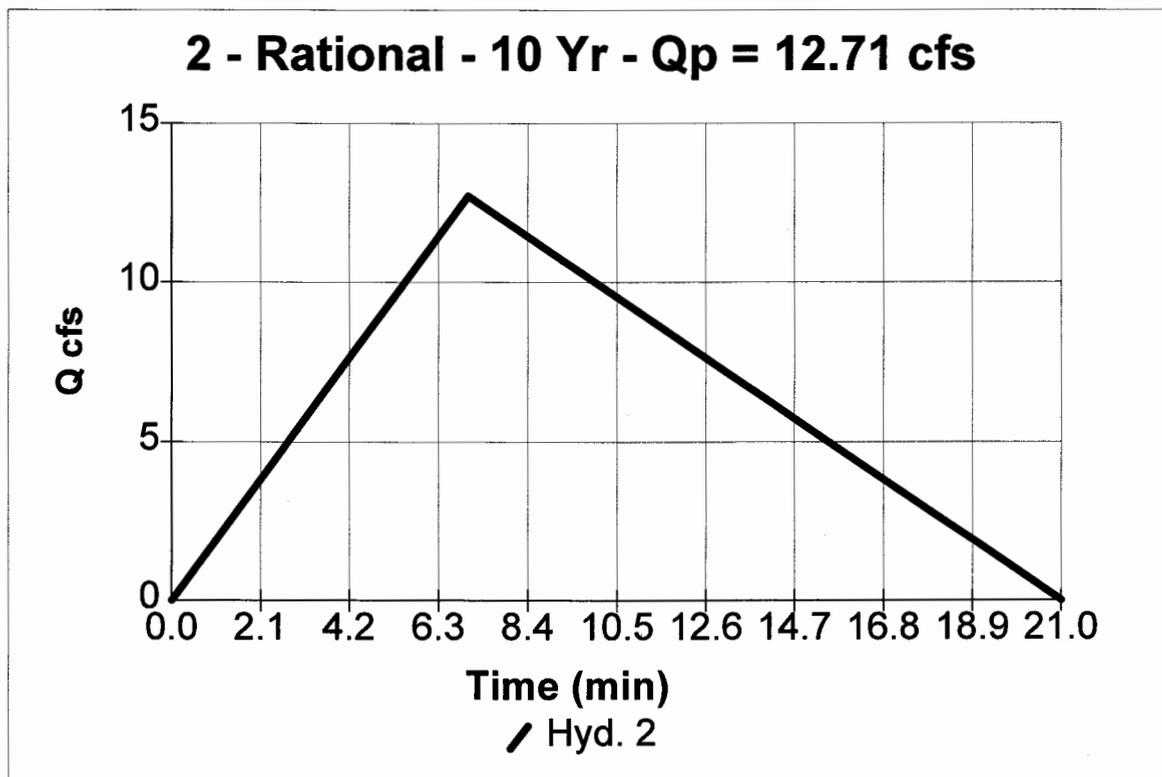

Adequate Channel Analysis for Outfall of Storm System 3


Stonehouse Richardson's Mill Phase 1

10/26/2001 (Revised 7/30/02)

Project No. 9028-08

CHANNEL GEOMETRY

Trapezoidal Channel

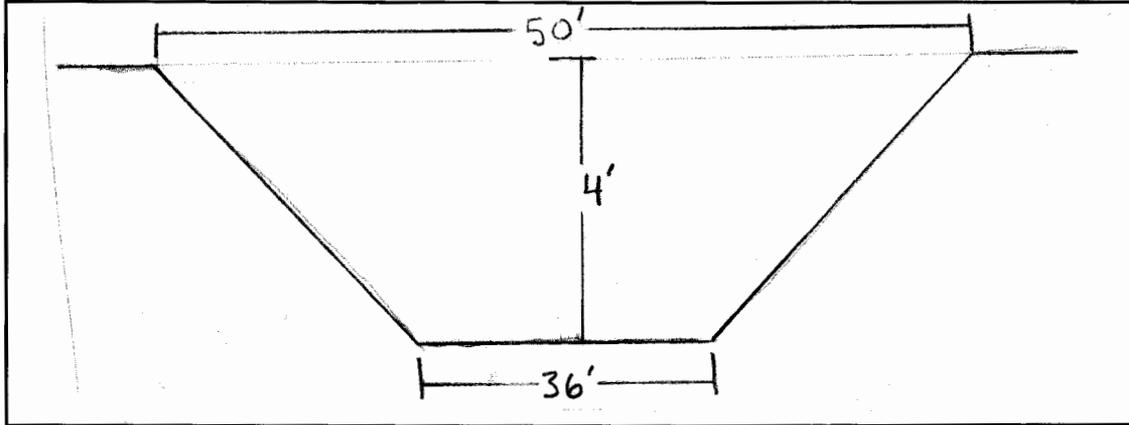

TOP WIDTH =	50 FT
BOTTOM WIDTH =	36 FT
HEIGHT =	4 FT
Z =	1.75 FT
SLOPE (S)	0.085 FT/FT
MANNING'S N	0.13

Note: Ravine fairly flat and wide with no clearly defined flow channel.

CALCULATION OF CHANNEL CAPACITY AND VELOCITY

MANNING'S EQUATION

$$V = 1.49 / N * R^{2/3} * S^{1/2}$$

WHERE:

- V = AVERAGE VELOCITY
- N = MANNING'S ROUGHNESS COEF.
- R = HYDRAULIC RADIUS = A / WP
- S = SLOPE OF CHANNEL
- A = AREA OF CROSS SECTION
- WP = WETTED PERIMETER

MANNING'S ROUGHNESS COEF.

N1 = CHANNEL IN EARTH	0.02 (Earthen Channel)
N2 = EROSION	0.01 (Channel is slightly eroded)
N3 = SIZE/SHAPE OF CHANNEL	0.01 (Channel shape changes over length)
N4 = OBSTRUCTIONS	0.025 (flow obstructed by underbrush and trees)
N5 = VEGETATION	0.05 (some small trees and underbrush)
N6 = MEANDER	0.15 (Flow line meanders through trees and underbrush)

$$N = (N1 + N2 + N3 + N4 + N5) * N6 + (N1 + N2 + N3 + N4 + N5)$$

$$N = 0.13$$

SOIL TYPE

SANDY LOAM

MAX. PERMISSIBLE VELOCITY = 2.5 FT /SEC

2-YEAR STORM EVENT

TIME OF CONCENTRATION = 7.4 min
RAINFALL INTENSITY = 6.5 in/hr
RUNOFF COEF. = 0.8
DRAINAGE AREA = 2.27 Ac.

PEAK FLOW RATE = 9.61 CFS (SEE HYDROGRAPH)
PEAK VELOCITY = 1.19 FT/S

* VELOCITY FOR POST DEVELOPMENT 2-YEAR STORM IS LESS THAN MAXIMUM PERMISSIBLE VELOCITY OF 2.50 ft/s THEREFORE, CHANNEL IS ADEQUATE.

10-YEAR STORM EVENT

PEAK FLOW RATE = 12.01 CFS (SEE HYDROGRAPH)

* 10 yr storm event results in a depth within the confines of the channel

Depth (FT)	Area (SQ FT)	Wetted Perimeter (FT)	Hydraulic Radius (FT)	Velocity (FT/SEC)	Flow (CFS)
0.00	0.00	36.00	0.00	0.00	0.00
0.02	0.72	36.08	0.02	0.24	0.17
0.04	1.44	36.16	0.04	0.38	0.55
0.06	2.17	36.24	0.06	0.50	1.09
0.08	2.89	36.32	0.08	0.61	1.76
0.10	3.62	36.40	0.10	0.70	2.55
0.12	4.35	36.48	0.12	0.80	3.46
0.14	5.07	36.56	0.14	0.88	4.47
0.16	5.80	36.64	0.16	0.96	5.58
0.18	6.54	36.73	0.18	1.04	6.79
0.20	7.27	36.81	0.20	1.11	8.10
0.22	8.00	36.89	0.22	1.19	9.49
0.22	8.06	36.89	0.22	1.19	9.61
0.24	8.74	36.97	0.24	1.26	10.98
0.25	9.23	37.02	0.25	1.30	12.01

Hydrograph Plot


Hyd. No. 3

STORM SYSTEM 3

Hydrograph type = Rational
Storm frequency = 2 yrs
Drainage area = 2.3 ac
Intensity = 5.047 in/hr
IDF Curve = JCChydrographs.IDF

Peak discharge = 9.16 cfs
Time interval = 1 min
Runoff coeff. = 0.8
Time of conc. (Tc) = 7 min
Asc/Rec limb fact = 1/2

Hydrograph Volume = 5,774 cuft

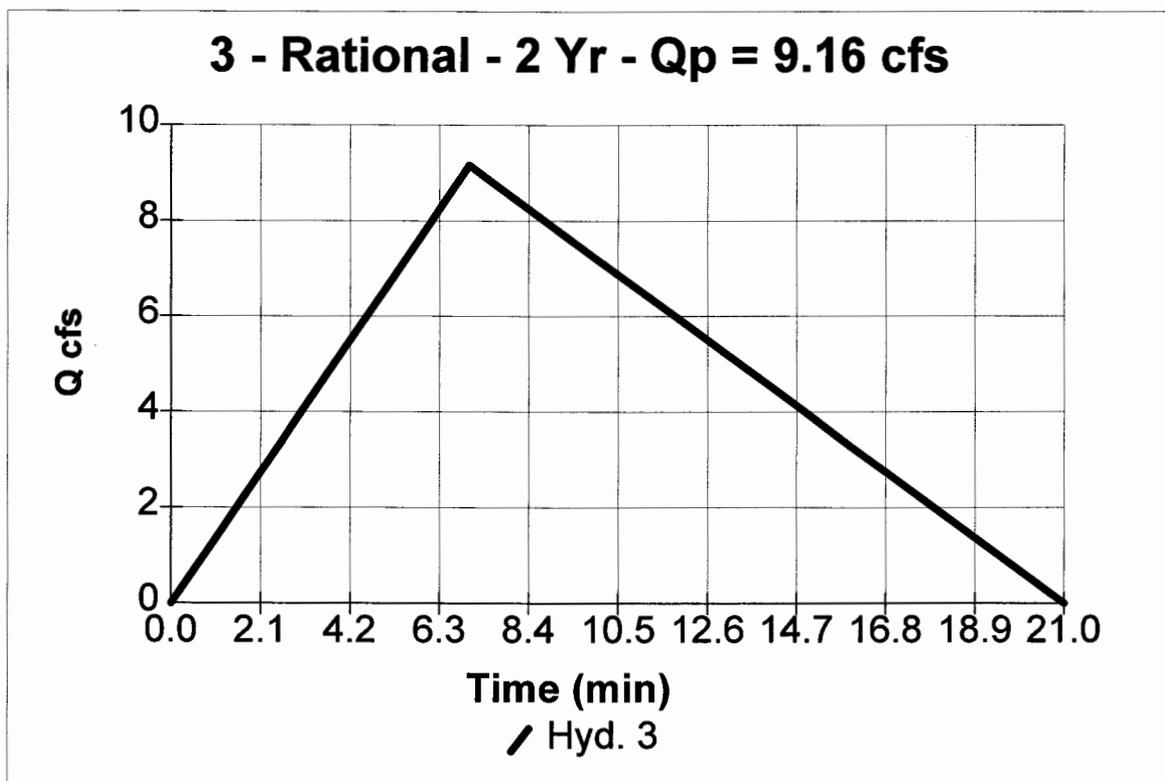

Hydrograph Plot


Hyd. No. 3

STORM SYSTEM 3

Hydrograph type = Rational
Storm frequency = 10 yrs
Drainage area = 2.3 ac
Intensity = 6.612 in/hr
IDF Curve = JCChydrographs.IDF

Peak discharge = 12.01 cfs
Time interval = 1 min
Runoff coeff. = 0.8
Time of conc. (Tc) = 7 min
Asc/Rec limb fact = 1/2


Hydrograph Volume = 7,564 cuft

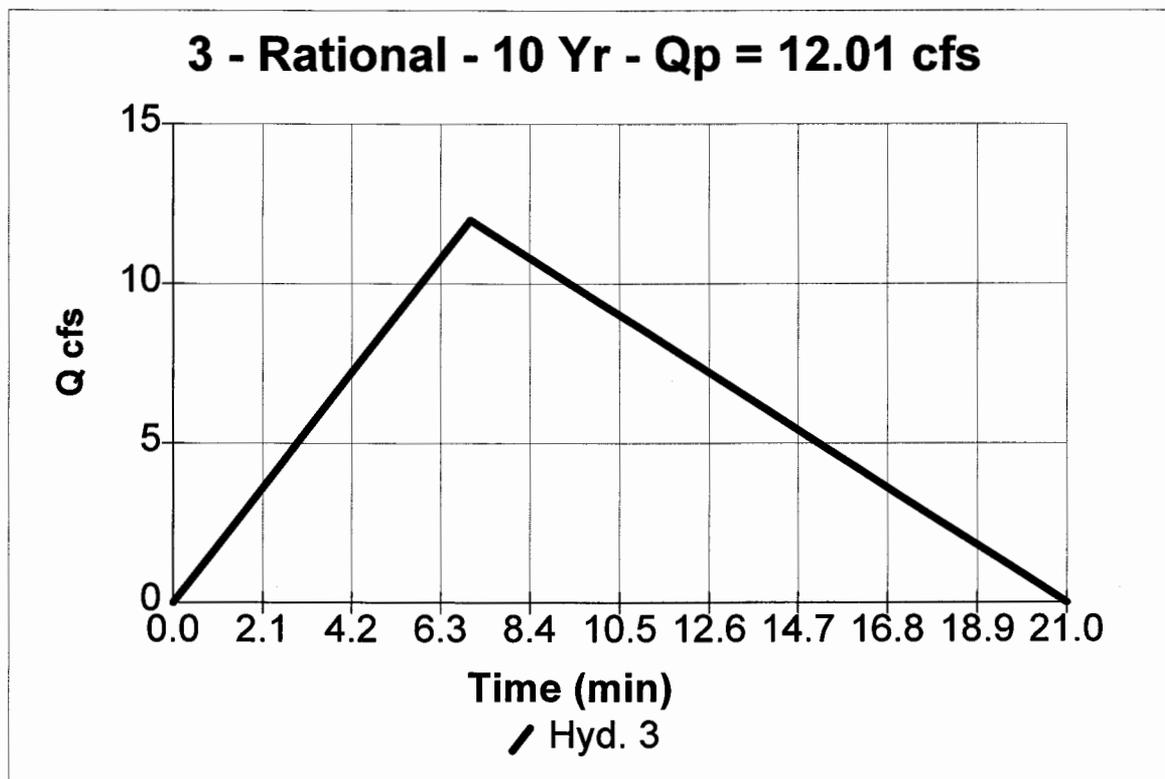

Adequate Channel Analysis for Outfall of Storm System 4
 Stonehouse Richardson's Mill Phase 1
 10/26/2001 (Revised 7/30/02)
 Project No. 9028-08

CHANNEL GEOMETRY

Parabolic Channel

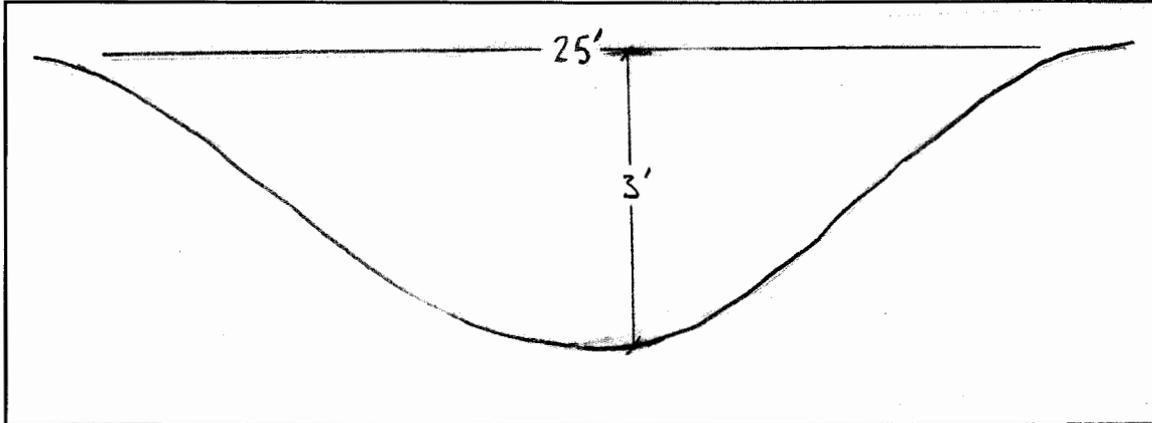

TOP WIDTH = 25 ft
 HEIGHT = 3 ft
 SLOPE (S) 0.06 ft/ft
 MANNING'S N 0.10

Note: Ravine fairly flat and wide with no clearly defined flow channel.

CALCULATION OF CHANNEL CAPACITY AND VELOCITY

MANNING'S EQUATION

$$V = 1.49 / N * R^{2/3} * S^{1/2}$$

WHERE:

V = AVERAGE VELOCITY
 N = MANNING'S ROUGHNESS COEF.
 R = HYDRAULIC RADIUS = A / WP
 S = SLOPE OF CHANNEL
 A = AREA OF CROSS SECTION
 WP = WETTED PERIMETER

MANNING'S ROUGHNESS COEF.

N1 = CHANNEL IN EARTH	0.02 (Earthen Channel)
N2 = EROSION	0 (Channel in good condition)
N3 = SIZE/SHAPE OF CHANN	0 (Channel shape consistent)
N4 = OBSTRUCTIONS	0.02 (flow obstructed by underbrush and trees)
N5 = VEGETATION	0.05 (some trees and underbrush)
N6 = MEANDER	0.15 (Flow line meanders through trees and underbrush)

$$N = (N1 + N2 + N3 + N4 + N5) * N6 + (N1 + N2 + N3 + N4 + N5)$$

$$N = \underline{0.10}$$

SOIL TYPE

SANDY LOAM

MAX. PERMISSIBLE VELOCITY = 2.5 FT /SEC

2-YEAR STORM EVENT

TIME OF CONCENTRATION 6.4 min
RAINFALL INTENSITY = 6.8 in/hr
RUNOFF COEF. = 0.8
DRAINAGE AREA = 0.8 Ac.

PEAK FLOW RATE = 3.38 CFS (SEE HYDROGRAPH)
PEAK VELOCITY = 1.99 FT/S

*** VELOCITY FOR POST DEVELOPMENT 2-YEAR STORM IS LESS THAN MAXIMUM PERMISSIBLE VELOCITY OF 2.50 ft/s THEREFORE, CHANNEL IS ADEQUATE.**

10-YEAR STORM EVENT

PEAK FLOW RATE = 4.39 CFS (SEE HYDROGRAPH)

*** 10 yr storm event results in a depth within the confines of the channel**

<u>Incremental</u> <u>Depth</u> (FT)	<u>Incremental</u> <u>Top Width</u> (FT)	<u>Area</u> (SQ FT)	<u>Wetted</u> <u>Perimeter</u> (FT)	<u>Hydraulic</u> <u>Radius</u> (FT)	<u>Velocity</u> (FT/SEC)	<u>Flow</u> (CFS)
0.00	0.00	0.00	0.00	0.00	0.00	0.00
0.02	2.83	0.04	12.00	0.01	0.21	0.01
0.04	4.00	0.11	24.01	0.03	0.36	0.04
0.06	4.90	0.20	36.01	0.05	0.51	0.10
0.08	5.66	0.30	48.03	0.08	0.65	0.20
0.10	6.32	0.42	60.04	0.11	0.79	0.33
0.12	6.93	0.55	72.06	0.14	0.94	0.52
0.14	7.48	0.70	84.08	0.17	1.09	0.76
0.16	8.00	0.85	96.10	0.21	1.24	1.06
0.18	8.49	1.02	108.13	0.25	1.40	1.42
0.20	8.94	1.19	120.16	0.29	1.56	1.86
0.22	9.38	1.38	132.19	0.34	1.72	2.36
0.24	9.80	1.57	144.23	0.39	1.88	2.95
0.25	10.06	1.70	152.05	0.42	1.99	3.38
0.26	10.20	1.77	156.27	0.44	2.05	3.63
0.28	10.58	1.98	168.31	0.50	2.22	4.39

Hydrograph Plot

Hydraflow Hydrographs by Intelisolve


Hyd. No. 4

STORM SYSTEM 4

Hydrograph type = Rational
Storm frequency = 2 yrs
Drainage area = 0.8 ac
Intensity = 5.275 in/hr
IDF Curve = JCChydrographs.IDF

Peak discharge = 3.38 cfs
Time interval = 1 min
Runoff coeff. = 0.8
Time of conc. (Tc) = 6 min
Asc/Rec limb fact = 1/2

Hydrograph Volume = 1,823 cuft

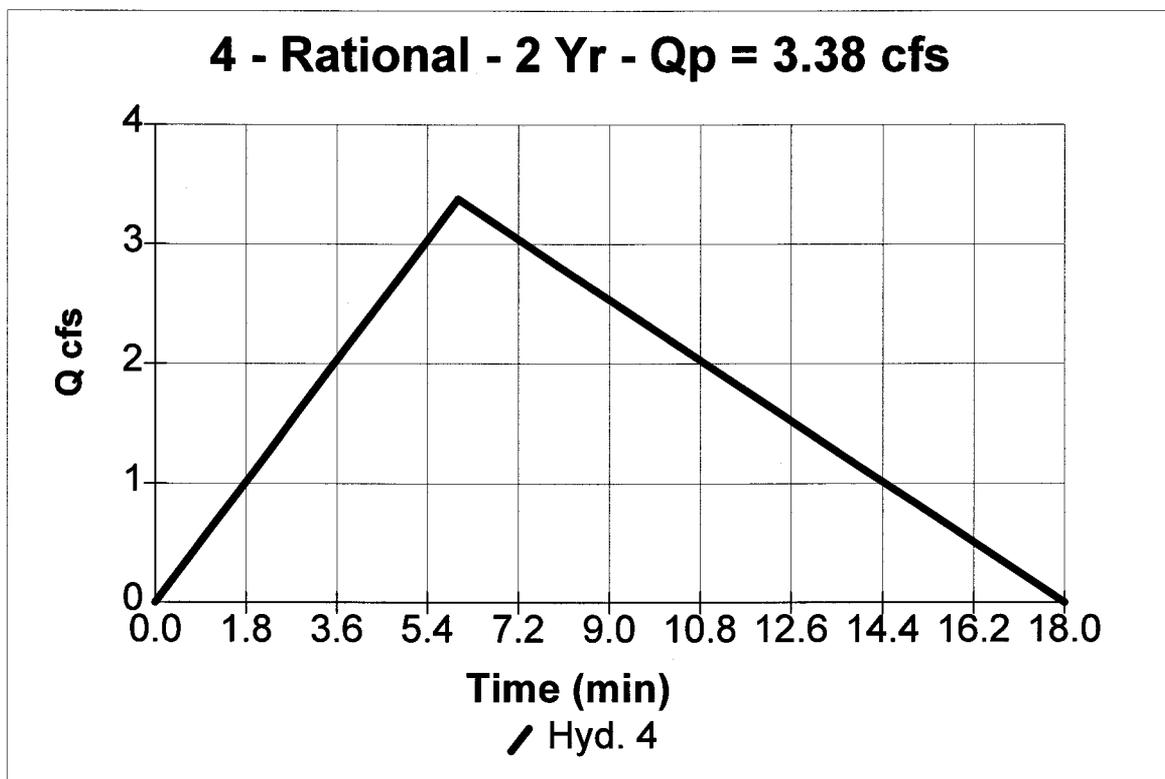

Hydrograph Plot

Hydraflow Hydrographs by Intelisolve


Hyd. No. 4

STORM SYSTEM 4

Hydrograph type = Rational
Storm frequency = 10 yrs
Drainage area = 0.8 ac
Intensity = 6.859 in/hr
IDF Curve = JCChydrographs.IDF

Peak discharge = 4.39 cfs
Time interval = 1 min
Runoff coeff. = 0.8
Time of conc. (Tc) = 6 min
Asc/Rec limb fact = 1/2

Hydrograph Volume = 2,370 cuft

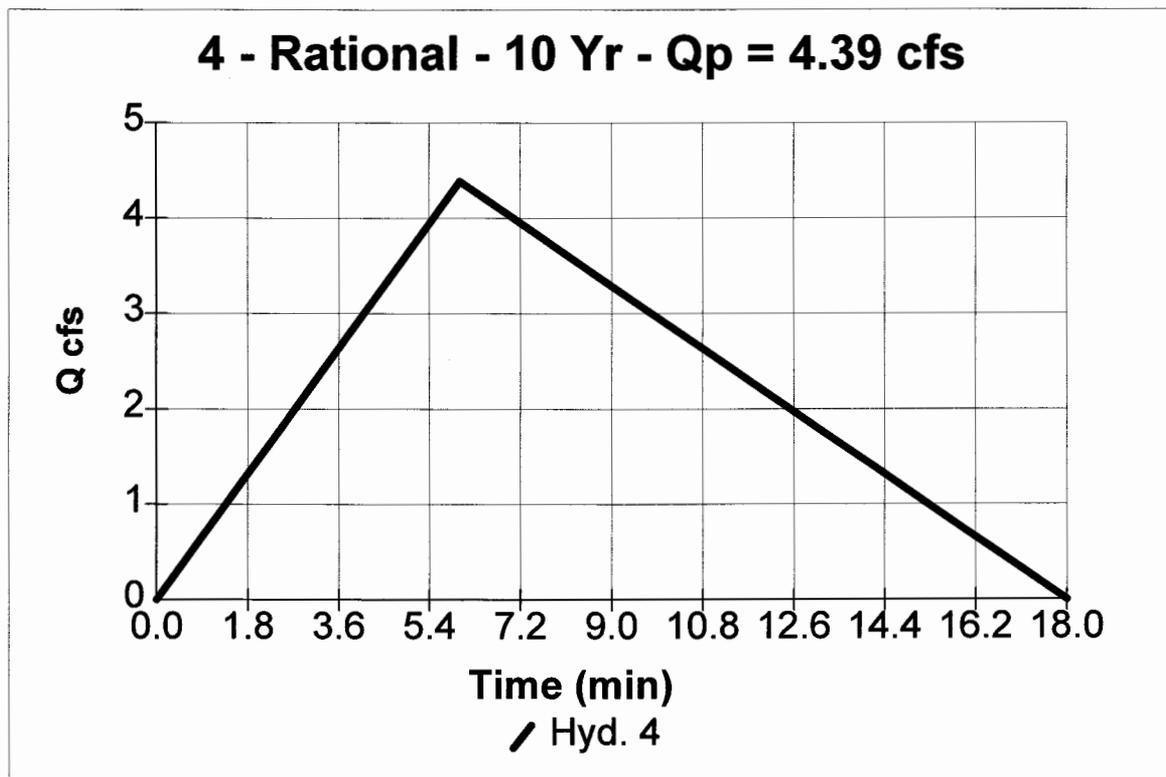

Given:

butt Diameter = 12 inches = 1 ft
 Spacing = 4 ft
 hw = 8.5 ft
 hs = 6 ft
 γ_w = 62.4 pcf

Assumptions:

γ_{soil} = 120 pcf
 e_{soil} = 50 %
 γ_{sat} = 131 pcf
 K_a = 0.31 (Rankine Active Coefficient)

Average Soil at Site (medium clay/compact sandy loam):

p = 200 PSF * From Table 4.8 in Timber
 S = 2500 PSF Construction Manual

Loads:

Assume total soil pressure acts horizontally on pole

Load due to Saturated Soil = 382.788 lb / LF

Load due to Water = 2254.2 lb / LF

Total Moment about toe, M_o = 7152.476 lb-ft / LF

Equivalent Load at top = 841.4678 lb / LF

Load at each pole = 3365.871 lbs


Calculate Pole Depth:

Calculations based on procedure outlined in Timber Construction Manual Section 4 on Pole-Type Framing.

Assume initial pole depth is same as height (pole is twice length of height)

iteration	d	S1	A	d
1	8.50	566.67	13.90	13.31
2	13.31	887.12	8.88	10.10
3	10.10	673.18	11.70	11.94
4	11.94	796.16	9.89	10.78
5	10.78	718.40	10.96	11.47
6	11.47	764.86	10.30	11.04
7	11.04	736.11	10.70	11.30
8	11.30	753.52	10.45	11.14
9	11.14	742.83	10.60	11.24
10	11.24	749.34	10.51	11.18
11	11.18	745.36	10.57	11.22
12	11.22	747.79	10.53	11.19
13	11.19	746.30	10.55	11.21
14	11.21	747.21	10.54	11.20
15	11.20	746.66	10.55	11.20

USE 20.0 FT MINIMUM LENGTH POLE

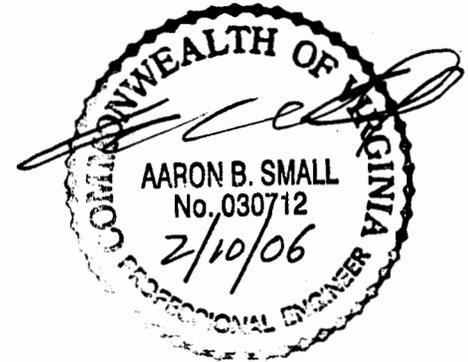

Scott Thomas

To: Mike Randall
Subject: RE: Timber Dam BMP Acceptance at Stonehouse

Mike

Hello and I hope all is well. I know this is an older email; however, I am just using it because it had your email address. Anyways, I am sending it to to let you know we have requests in now, as expected, for release of siltation bond associated with Stonehouse Phase (Area) 1, Section 7-A, Richardson Mill Section 1 (S-99-01:S-100-02) and Richardson Mill Section (S-64-02), which as you know contains the four timber walls.

- WC 075 BMP # 7.3 Timber Crib Wall End of Morning Mist Lane
- WC 076 BMP # 7.4 Timber Crib Wall South of Sawyer Way
- WC 077 BMP # 7.2 Timber Crib Wall End of Mill Pond Run cul-de-sac
- WC 078 BMP # 7.1 Timber Crib Wall West of Yarding Way

Scott J. Thomas, P.E.
Director
James City County Environmental Division

Visit:
www.protectedwithpride.org
www.jccegov.com

From: Mike Randall [mailto:mhrandall@cox.net]
Sent: Thursday, July 31, 2008 7:52 PM
To: Scott Thomas; Michael Majdeski
Cc: Ellen Clark; Dave Lehnertz
Subject: Timber Dam BMP Acceptance at Stonehouse

Scott,
After walking all four BMPs, it looks like the developer is at or near finalizing work on BMPs WC075, 76, 77, & 78 for acceptance by JCCED and turn over to the Stonehouse HOA for continuing maintenance. Please let me know if/when we can expect a final acceptance inspection. As we have previously discussed, I would like to accompany your staff on the final inspection(s) if at all possible.

Thanks,
Mike Randall
Stonehouse Grounds & Maintenance
Tel 757-566-3405
Cell 757-293-8205
Email mhrandall@cox.net


10/29/08 10:30am

- CALLED MIKE RANDALL
- Association is ok w/ release of siltation bond
- Was happy with staffs reaction and resolve
- Mike Majdeski worked closely with HOA in conversion of BMPs to dry pond.
- Scott & Mike did joint insp. on 10/23/08. No issues.

THE ASSOCIATION AT STONEHOUSE, INC.

June 4, 2008

Mr. Scott Thomas
Environmental Director
101E Mounts Bay Road
P. O. Box 8784
Williamsburg, VA 23287

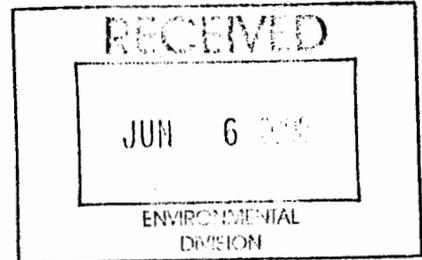

Dear Mr. Thomas:

The Association at Stonehouse, Inc. appreciates the decision of your office to require that Dominion be compelled to restore the four BMPs for which it is responsible to a dry condition, as originally envisioned in the plan for Stonehouse.

We now have a concern about two BMPs located in the Lisburn section of Stonehouse that are presently owned by GCR, Inc. We have received a letter from D. Wayne Moore, the attorney for GCR, Inc., which appears to indicate that GCR wants to convey the common property it owns, including the BMPs, to Stonehouse. It must be made clear to GCR that the BMPs must be left in a dry condition.

We would appreciate it if you could advise me if GCR contacts your office concerning the transfer of these two BMPs, and you insist that GCR have these two BMPs established as dry BMPs before they are transferred to us.

Very truly yours,

Robert W. Spencer
Robert W. Spencer
President Emeritus

SJT
Joe B
MIKE M
I am not aware of any
asbults or const cert coming in
for Lisburn yet to even start
to think about bond release
when they do come in + we do
our final inspection. I want to
"try" to include the HAA
in as a courtesy. I
committed to
try that
And

9701 MILL POND RUN TOANO, VA 23168 (757) 566-0128 PHONE (757) 566-1198 FAX

Return letter to me.

LETTER OF TRANSMITTAL

Phone: (757) 253-0040
Fax: (757) 220-8994

ATTN: **Mike Majdeski**


CO.: JCC Environmental Division

Address: 101-E Mounts Bay Road

Williamsburg, VA 23187

cc: file

DATE 10/16/08	JOB NO. 9028-17
FROM: Victoria Bains	
RE Stonehouse Richardson's Mill Section 1 & 2	

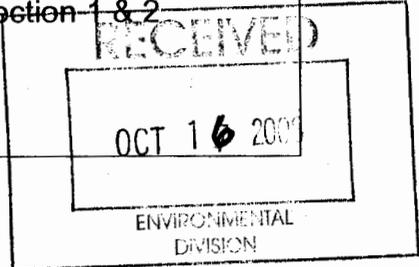

WE ARE SENDING YOU THE FOLLOWING ITEMS:

- Attached
 Under separate cover via
- Original(s) Print(s) Plan(s) Specification(s) Change Order
- Copy of letter(s) Other:

COPIES	DATE	No. of Pages	DESCRIPTION
1	10/16/08	16	4 - BMP Certification

THESE ARE TRANSMITTED as checked below:

- For your approval For your signature For review and comment
- For your use As you requested As requested by:
- Other:


REMARKS:

If enclosures are not as noted, kindly notify us at once.

AES CONSULTING ENGINEERS
Engineering, Surveying, and Planning
 5248 Olde Towne Road, Suite 1
 WILLIAMSBURG, VIRGINIA 23188

Phone: (757) 253-0040
Fax: (757) 220-8994

LETTER OF TRANSMITTAL

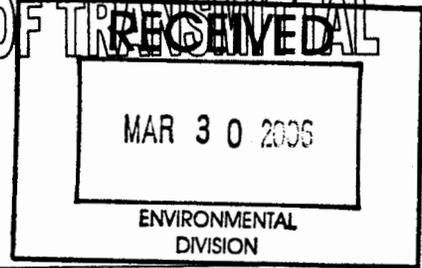

ATTN: **Scott Thomas**

CO.: **JCC Environmental**

Address:

cc:

DATE 03/30/06	JOB NO. 9028-08
FROM: Victoria Bains	
RE Stonehouse - Richardson's Mill Section 1 & 2 Timber Wall BMP's 7.1, 7.2, 7.3, 7.4	

WE ARE SENDING YOU THE FOLLOWING ITEMS:

- Attached
 Under separate cover via
 Original(s) Print(s) Plan(s) Specification(s) Change Order
 Copy of letter(s) Other:

COPIES	DATE	No. of Pages	DESCRIPTION
1	03/27/06	3	Letter & Calculations for Timber Walls
1	04/22/06	1	Letter certifying construction of BMP's in Richardson's Mill

THESE ARE TRANSMITTED as checked below:

- For your approval For your signature For review and comment
 For your use As you requested As requested by:
 Other:

REMARKS:

Scott,
 If you need anything else please let me know
 Thank you,
 Tory

If enclosures are not as noted, kindly notify us at once.

GET

Solutions, Inc.

Geotechnical · Environmental · Testing

April 22, 2005

To: **AES Consulting Engineers**
5248 Olde Towne Road
Suite 1
Williamsburg, VA 23188

Attn: Ms. Victoria A. Bains

Re: **Richardson's Mill Timber Walls (Sections 1 & 2)**
Stone House Development
James City County, Virginia
G E T Project No. VB02-302T

WC 075 7.3
076 7.4
077 7.2
078 7.1


Dear Ms. Bains:


The purpose of this correspondence is to indicate that **G E T Solutions, Inc.** performed QA/QC inspections during site and earthwork construction activities at Richardson's Mill subdivision Sections 1 & 2, of the Stonehouse development in James City County, Virginia. As part of our inspection services, the construction of the 4 BMP basins was monitored and associated field-testing was performed in accordance with the plans and specifications.

In this respect, it is determined that these 4 basins were constructed in general conformance with the plans and specifications. Additionally, it is our opinion that these basins should hold water, considering the relatively low-permeability characteristics of the fill soils used at these sites, and the design and installation of the timber detention structures.


We appreciate the opportunity to be of continuous service to you on this project, and trust that you will call this office with any questions that you may have.

Respectfully Submitted,
G E T Solutions, Inc.

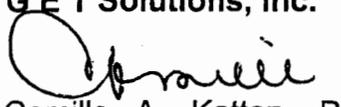
Camille A. Kattan, P.E.
Principal Engineer
VA Reg. # 018045

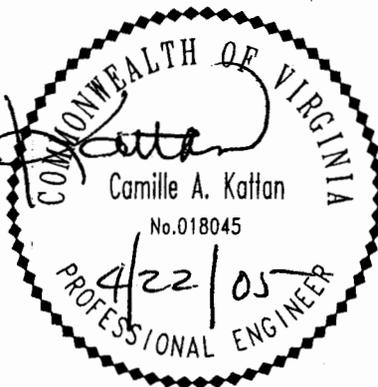

Copies: (3) Client

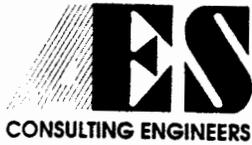

5248 Olde Towne Road • Suite 1 • Williamsburg, Virginia 23188
(757) 253-0040 • Fax (757) 220-8994 • E-mail aes@aesva.com

March 27, 2006

Mr. Scott J. Thomas, P.E.
James City County Environmental Division
101-E Mounts Bay Road
P.O. Box 8784
Williamsburg, VA 23187-8784

BMP 7.1 WC075
7.2 WC077
7.3 WC075
7.4 WC076

**RE: Stonehouse Richardson's Mill, Section 1
Timber Structure BMPs
AES Project No. 9028-08**

Dear Mr. Thomas:

Mr. Marc Bennett of my office has asked me to review my design for the timber structures being used as dams for the BMPs at the above referenced project. He has informed me that our client would like to forego conversion of the sediment basins to the permanent BMPs and simply let them operate as shallow marshes that would eventually silt in. The reason for this is that the contractor has indicated that "more damage than good" would result from his activities to fill in the wet pool portion of the sediment trap. This is the only activity required to convert the sediment basins to the permanent dry detention basins.

Attached for your reference are the calculations for the poles which carry the load for the structure and transfer it to the ground. The height of the wall, h_w , is shown in the calculations as 8.5 feet. This is the height of the structure above the existing grade at the maximum point. The exposed height of the wall is closer to 4.5 feet as soil was placed on both sides of the structure. The soil on the downstream side is ignored, even though some passive resistance is permitted. On the upstream side of the wall, the height of soil, h_s , is shown in the calculations as 6.0 feet. This takes into account sedimentation within 2.5 feet of the top of the wall. Both the sediment and the water load generate forces on the wall which is ultimately resisted by the poles. This resistance is dependent on the diameter of the pole, the depth of embedment, and the soil characteristics.

Soil values used are based upon conservative assumptions as well as soil borings performed throughout the subdivision. Pole diameter is 12 inches as designed and verified by as-builts. The only variable is the depth. Based upon design and the as-builts, 20 feet long poles were used in both structures. The original design calculations only used a height of wall of 8.0 feet and required a minimum 19.0 feet long pole. The as-builts show an increased height of the wall of 8.5 feet, a 20.0 feet long pole is required (the actual calculations require 19.7 feet which is then rounded up to 20.0 feet). Therefore the as-built structures are still adequate.

The structures are designed for the worst case condition which is the configuration where the dry detention facility is silted in over 2 feet above the proposed bottom elevation of the basin. As a result, leaving the sediment basins as is and allowing them to develop into shallow marshes will not adversely impact the structure but may actually increase the life of the BMPs by increasing the time before dredging of accumulated sediments would be required.

Mr. Scott J. Thomas
February 10, 2006
Page 2

I trust that I have satisfactorily alleviated your concerns over the stability of the structures. If you have any questions or require additional information regarding this matter, please do not hesitate to contact me at your earliest convenience.

Sincerely,

AES Consulting Engineers




Aaron B. Small, P.E.
Project Manager
asmall@aesva.com

Attachments: Timber Structure Calculations

February 15, 2005

Mr. Darryl E Cook, P.E.
Mr. Scott J Thomas, P.E.
James City County Environmental Division
101-E Mounts Bay Road
Williamsburg, Virginia 23187

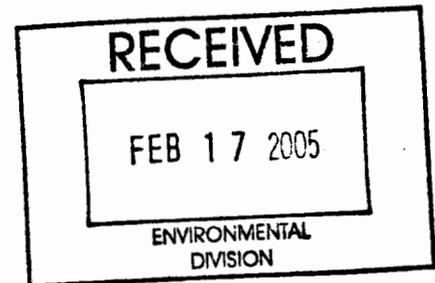

RE: Stonehouse, Richardson's Mill, Section 1
AES Project No. 9028-08
James City County Case Number S-99-01

And

Stonehouse, Richardson's Mill, Section 2
AES Project No. 9028-13
James City County Case Number S-25-03

Dear Mr. Cook and Mr. Thomas;

We would appreciate your consideration of the configuration of permanent SWM/BMP structures for the Stonehouse subdivisions referenced above.

Site improvements to the subdivisions of Richardson's Mill, Section 1 and 2 are substantially complete, and have been inspected by James City County Environmental Staff. There are four-timber structure SWM/BMP's between the two subdivisions: WC075, WC076, WC077, and WC078. These temporary sediment basins can be converted or completed to be permanent SWM/BMP facilities.

The design and construction of these facilities provided an excavated area for sediment accumulation during the construction period. Final conversion of the facilities, by design, involves the restoration of the existing ground contour, and altering the discharge to the final configuration. However, the current installations, after some repairs, meet the intent of the original design for erosion and sediment control facility, and storm water management needs. The question is whether the current installations need to be converted to the final design.

Under these conditions, we believe it is more beneficial to maintain the current configuration, and we offer the following supporting reasons:

Mr. Darryl E Cook, P.E.
Mr. Scott J Thomas, P.E.
February 17, 2005


- That, left in the current configuration, we fully expect that a wetland environment will naturally establish upland of the timber structure, within the remaining wet pool of the sediment basin.
- That with transition of the wet pool area to a shallow marsh, the timber structure BMP will have nutrient up-taking capability, removing more non-point source pollutants than a Timber Dry Detention Basin.
- That the developing shallow marsh component assists to slow the flow of runoff through the facility, which allows more runoff to infiltrate into the ground or evaporate.
- That further disturbances of the perimeter of the timber structure for the conversion would be eliminated, thereby eliminating the potential of sediment runoff, and erosion.
- And, that the remaining wet capacity of the pool can be used to capture any erosion and sediment runoff that any upland construction may cause in the future.

Given this information, we would appreciate a response from you to determine whether it is permissible to maintain the current configuration.

If you have any questions or concerns, feel free to contact me at any time.

Sincerely,

AES Consulting Engineers

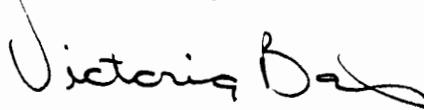

Victoria A. Bains
Project Engineer
vbains@aesva.com

cc: file

S:\Jobs\9028\13-Mill Pond Sub. Sect. 2\Wordproc\Document\902813110.vmb.doc

Scott Thomas

From: Scott Thomas
Sent: Wednesday, March 16, 2005 2:31 PM
To: 'Tory Bains'
Cc: Darryl Cook
Subject: RE: Richardson's Mill Section 1 & 2 Conversion of BMP's

Based on my recollection, the approved plan(s) allowed for an excavated micropool in front of the wall/mound area for temporary sediment basin purposes which would be restored to existing ground once the BMP was converted. Mainly are there any further geotechnical aspects for the wall and it's soil base (mound) that need to be considered due to a proposed permanent pool on the front sides of the wall/mound. For the approved design, this was only intended to be a temporary pooling condition, now it will be permanent. Secondly will having a permanent micropool result in addition maintenance burden (adjustments to the approved BMP maintenance plan) and would there be any mosquito-vector related issues involved.

Also, the request letter states a question whether the current installations need to be converted to the final approved design and lists lots of reasons to support leaving it alone, but the letter does not state the main reason why the applicant/contractor does not want to follow the approved plan.

Scott J. Thomas, P.E.
James City County
Environmental Division

Visit:
http://www.james-city.va.us/resources/devmgmt/div_devmgmt_environ.html
 and
www.protectedwithpride.org

-----Original Message-----

From: Tory Bains [mailto:vbains@aesva.com]
Sent: Wednesday, March 16, 2005 2:17 PM
To: Scott Thomas
Subject: RE: Richardson's Mill Section 1 & 2 Conversion of BMP's

Scott,

What are your concerns with the timber crib walls remaining in the current state?

Thanks,

Tory

Victoria (Tory) A. Bains
 Project Engineer
AES Consulting Engineers
 5248 Olde Towne Road, Suite 1
 Williamsburg, VA 23188
 Tele: (757) 253-0040
 Fax: (757) 220-8994
vbains@aesva.com
www.aesva.com

AES Consulting Engineers a Professional Corporation Confidentiality Note: This e-mail and any attachments are confidential and may be protected by legal privilege. If you are not the intended recipient, be aware that any disclosure, copying, distribution or use of this

3/16/2005

WC077_STONEHOUSE_SEC_7A_RICHARDSON_MILL_SEC_1_TIMBER_WALL - 075

e-mail or any attachment is prohibited. If you have received this e-mail in error, please notify us immediately by returning it to the sender and delete this copy from your system. Thank you for your cooperation.

From: Scott Thomas [mailto:SCOTTT@james-city.va.us]
Sent: Tuesday, March 15, 2005 9:22 AM
To: Bains, Victoria A.
Subject: RE: Richardson's Mill Section 1 & 2 Conversion of BMP's

I have read the request and do not want to render a decision until I look at these four timber crib walls (if time does not permit, maybe one that represents all of them).

Scott J. Thomas, P.E.
James City County
Environmental Division

Visit:
http://www.james-city.va.us/resources/devmgmt/div_devmgmt_environ.html
and
www.protectedwithpride.org

-----Original Message-----

From: Bains, Victoria A. [mailto:vbains@aesva.com]
Sent: Monday, March 14, 2005 4:53 PM
To: Scott Thomas
Cc: ccloughly@stonehouseva.com; ggoder@kaufcanconsulting.com
Subject: Richardson's Mill Section 1 & 2 Conversion of BMP's

Scott,

I sent you a letter dated February 15, 2005 requesting the county to allow these BMP's to remain in the current state. I wanted to check on the status of the review for not converting the BMP's in Richardson's Mill Section 1 & 2 to final design. Please let me know if you have any questions or concerns with the design.

If you are planning a site visit to these or any other facilities within Stonehouse please inform me of the time and I will schedule to meet you on site.

Thank you,

Tory

Victoria (Tory) A. Bains
Project Engineer
AES Consulting Engineers
5248 Olde Towne Road, Suite 1
Williamsburg, VA 23188
Tele: (757) 253-0040
Fax: (757) 220-8994
vbains@aesva.com
www.aesva.com

3/16/2005

Scott Thomas

From: Bains, Victoria A. [vbains@aesva.com]
Sent: Tuesday, May 23, 2006 4:30 PM
To: Scott Thomas
Cc: ggoder@kaufcanconsulting.com
Subject: Stonehouse - BMP Inspection List

Scott,

Here is the list of BMP's that need to be inspected.

Bent Tree:

AES No.	JCC No.	Notes
6-3-99 BMP 5.1	WC071	✓ REINSPECT 5/30/06. OK. WILL CLEAN LFO.
6-42-99 BMP 5.4	WC072	✓ REINSPECT 5/30/06. OK. " "
6-42-99 BMP 5.2	WC073	✓ REINSPECT 5/30/06. OK. " "
5-91-99 BMP 5.3	WC074	✓ REINSPECT 5/30/06. OK. " " + MOW DAM.

Richardson's Mill:

AES No.	JCC No.	Notes
BMP 7.3	WC075	✓ REINSPECT 5/30/06. OK. NO PROBLEMS. Deep Valley. PP
BMP 7.4	WC076	✓ REINSPECT 5/30/06. OK. NO " "
BMP 7.2	WC077	✓ REINSPECT 5/30/06. OK. " " "
BMP 7.1	WC078	Reinspect 5/30/06. BMP OK, Inflow pipe undercut. Process Letter.

Let me know if you cannot find any of the certifications or calculations and I can have copies sent to you before we meet. See you at the Sales Center next Tuesday May 30 at 1:00pm.

Thank you,

Tory

Victoria (Tory) A. Bains
 Project Engineer

AES Consulting Engineers

Williamsburg | Richmond | Gloucester
 (757) 253-0040
 www.aesva.com

AES Consulting Engineers Confidentiality Note: This e-mail and any attachments are confidential and may be protected by legal privilege. If you are not the intended recipient, be aware that any disclosure, copying, distribution or use of this e-mail or any attachment is prohibited. If you have received this e-mail in error, please notify us immediately by returning it to the sender and deleting this copy from your system. Thank you for your cooperation.



James City County Environmental Division Stormwater Management / BMP Inspection Report Detention and Retention Pond Facilities

County BMP ID Code (if known): WC078

Name of Facility: TIMBER STRUCTURE DRY POND BMP No.: 4 of 4 Date: 10/10/2008

Location: RICHARDSONS MILL SECTION 2 - STONEHOUSE (OFF YARDING WAY)

Name of Owner: STONEHOUSE DEVELOPMENT COMPANY, LLC.

Name of Inspector: M. MAJDESKI

Type of Facility: DETENTION BASIN

Weather Conditions: Partly Cloudy 75° Type: Final Inspection County BMP Inspection Program Owner Inspection

If an inspection item is not applicable, mark NA, otherwise mark the appropriate column.

O.K. - The item checked is in adequate condition and the maintenance program is currently satisfactory. No action required.


Routine - The item checked requires attention, but does not present an immediate threat to the function/integrity of the BMP.

Urgent - The item checked requires immediate attention to keep the BMP operational and to prevent damage to the facility.

Provide an explanation and details in the comment column, if routine or urgent are marked.

Facility Item	O.K.	Routine	Urgent	Comments
Embankments and Side Slopes:				
Grass Height		✓		
Vegetation Condition	✓			
Tree Growth	✓			
Erosion	✓			
Trash & Debris	✓			
Seepage	✓			
Fencing or Benches	✓			
Interior Landscaping/Planted Areas: <input type="checkbox"/> None <input type="checkbox"/> Constructed Wetland/Shallow Marsh <input type="checkbox"/> Naturally Established Vegetation				
Vegetated Conditions		✓		LET GRASS GROW UP
Trash & Debris	✓			
Floating Material	✓			
Erosion	✓			
Sediment	✓			
Dead Plant	✓			
Aesthetics	✓			
Other				
Notes:				

Facility Item	O.K.	Routine	Urgent	Comments
Water Pools: <input type="checkbox"/> Permanent Pool (Retention Basin) <input type="checkbox"/> Shallow Marsh (Detention Basin) <input checked="" type="checkbox"/> None, Dry (Detention Basin)				
Shoreline Erosion				
Algae				
Trash & Debris				
Sediment				
Aesthetics				
Other				
Inflows (Describe Types/Locations):				
Condition of Structure	✓			
Erosion	✓			
Trash and Debris	✓			
Sediment	✓			
Outlet Protection	✓			
Other				
Principal Flow Control Structure - Riser, Intake, etc. (Describe Type):				
Condition of Structure	✓			
Corrosion	✓			
Trash and Debris	✓			
Sediment	✓			
Vegetation	✓			
Other				
Principal Outlet Structure - Barrel, Conduit, etc. :				
Condition of Structure		✓		
Settlement	✓			
Trash & Debris	✓			
Erosion/Sediment	✓			
Outlet Protection	✓			
Other				
Emergency Spillway (Overflow):				
Vegetation	✓			
Lining	✓			
Erosion	✓			
Trash & Debris	✓			
Other				
Notes:				

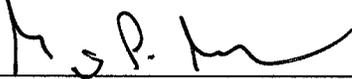Facility Item	O.K.	Routine	Urgent	Comments
Nuisance Type Conditions:				
Mosquito Breeding	✓			
Animal Burrows	✓			
Graffiti	✓			
Other				
Surrounding Perimeter Conditions:				
Land Uses	✓			
Vegetation	✓			
Trash & Debris	✓			
Aesthetics	✓			
Access /Maintenance Roads or Paths	✓			
Other				
Remarks:				
<p>Overall Environmental Division Internal Rating: <u>3/5</u></p> <p>Signature: <u></u> Date: <u>10/10/08</u></p> <p>Title: <u>ENV. INSPECTOR</u></p>				

SWMProg\BMP\CoInspProg\InspForms\DetRet.wpd



**James City County Environmental Division
Stormwater Management / BMP Inspection Report
Detention and Retention Pond Facilities**

County BMP ID Code (if known): WC077 SEC 7A RMP SEC 1
 Name of Facility: BMP #7.2 T.C.W BMP No.: _____ of _____ Date: 5/30/06
 Location: End Mill Pond Run Right @ Mill Pond Conservancy
 Name of Owner: _____
 Name of Inspector: SJ Thomas
 Type of Facility: _____
 Weather Conditions: _____ Type: Final Inspection County BMP Inspection Program Owner Inspection
REINSPELT

If an inspection item is not applicable, mark NA, otherwise mark the appropriate column.

- O.K. - The item checked is in adequate condition and the maintenance program is currently satisfactory. No action required.
- Routine - The item checked requires attention, but does not present an immediate threat to the function/integrity of the BMP.
- Urgent - The item checked requires immediate attention to keep the BMP operational and to prevent damage to the facility.

Provide an explanation and details in the comment column, if routine or urgent are marked.

Facility Item	O.K.	Routine	Urgent	Comments
Embankments and Side Slopes: <i>Timber crib wall in Deep Valley</i>				
Grass Height	✓			
Vegetation Condition	✓			
Tree Growth	✓			
Erosion	✓			
Trash & Debris	✓			
Seepage	✓			
Fencing or Benches	✓			
Interior Landscaping/Planted Areas: <input type="checkbox"/> None <input type="checkbox"/> Constructed Wetland/Shallow Marsh <input checked="" type="checkbox"/> Naturally Established Vegetation				
Vegetated Conditions	✓			
Trash & Debris	✓			
Floating Material	✓			
Erosion	✓			
Sediment	✓			
Dead Plant	✓			
Aesthetics	✓			
Other	✓			
Notes:				

Facility Item	O.K.	Routine	Urgent	Comments
Water Pools: <input checked="" type="checkbox"/> Permanent Pool (Retention Basin) <input type="checkbox"/> Shallow Marsh (Detention Basin) <input type="checkbox"/> None, Dry (Detention Basin)				
Shoreline Erosion	✓			<i>shallow perm pool see geotech report</i>
Algae	✓			
Trash & Debris	✓			
Sediment	✓			
Aesthetics	✓			
Other	✓			
Inflows (Describe Types/Locations):				
Condition of Structure	✓			
Erosion	✓			
Trash and Debris	✓			
Sediment	✓			
Outlet Protection	✓			
Other	✓			
Principal Flow Control Structure - Riser, Intake, etc. (Describe Type): <i>T.C.W w/ Riser + PVC</i>				
Condition of Structure	✓			
Corrosion	✓			
Trash and Debris	✓			
Sediment	✓			
Vegetation	✓			
Other	✓			
Principal Outlet Structure - Barrel, Conduit, etc. : <i>PVC</i>				
Condition of Structure	✓			
Settlement	✓			
Trash & Debris	✓			
Erosion/Sediment	✓			
Outlet Protection	✓			
Other	✓			
Emergency Spillway (Overflow): <i>None, over wall</i>				
Vegetation	✓			
Lining	✓			
Erosion	✓			
Trash & Debris	✓			
Other	✓			
Notes:				

Facility Item	O.K.	Routine	Urgent	Comments
Nuisance Type Conditions:				
Mosquito Breeding				
Animal Burrows				
Graffiti				
Other				
Surrounding Perimeter Conditions:				
Land Uses				
Vegetation				
Trash & Debris				
Aesthetics				
Access /Maintenance Roads or Paths				
Other				
Remarks:				
<i>Timber Crib Wall Design</i>				
Overall Environmental Division Internal Rating: <u> 3 </u>				
Signature: <u><i>Scott Thomas P.E.</i></u>		Date: <u> 5/30/06 </u>		
Title: <u> Chief Engineer </u>				

SWMPProg\BMP\CoInspProg\InspForms\DetRet.wpd

Date Record Created:

WS_BMPNO:

WC077

Print Form

Created By:

WATERSHED WC
BMP ID NO 077
PLAN NO S-99-01

TAX PARCEL
PIN NO
CONSTRUCTION DATE 8/16/2004

PROJECT NAME SH 7A Richardson Mill Pond Sec 1

FACILITY LOCATION End of Mill Pond Run

CITY-STATE Toano, VA 23168

CURRENT OWNER Stonehouse Development LLC

OWNER ADDRESS 9701 Mill Pond Run

OWNER ADDRESS 2

CITY-STATE-ZIP CODE Toano, VA 23168

OWNER PHONE 234-5000

MAINT AGREEMENT Yes

EMERG ACTION PLAN No

**PRINTED ON:
Friday, March 12, 2010
3:26:50 PM**

MAINTENANCE PLAN

Yes

SITE AREA acre

45.63

LAND USE

Planned Unit Dev

old BMP TYP

Timber Wall

JCC BMP CODE

F1 Timber Walls

POINT VALUE

0

SVC DRAIN AREA acres

7.93

SERVICE AREA DESCR

SF Lots & Road

IMPERV AREA acres

RECV STREAM

UT of Ware Creek

EXT DET-WQ-CTRL

No

WTR QUAL VOL acre-ft

0

CHAN PROT CTRL

Yes

CHAN PROT VOL acre-ft

0.72

SW/FLOOD CONTROL

Yes

GEOTECH REPORT

No

CTRL STRUC DESC

Timber Wall

CTRL STRUC SIZE inches

OTLT BARRL DESC

PVC Outlet

OTLT BARRL SIZE inch

3

EMERG SPILLWAY

Yes

DESIGN HW ELEV

30.42

PERM POOL ELEV

na

2-YR OUTFLOW cfs

1.65

10-YR OUTFLOW cfs

6.16

REC DRAWING

Yes

CONSTR CERTIF

Yes

LAST INSP DATE 5/30/2006

Inspected by:

INTERNAL RATING 3


MISC/COMMENTS

BMP # 7.2, amend S-100-02


Get Last BMP No

Return to Menu

Additional Comments:

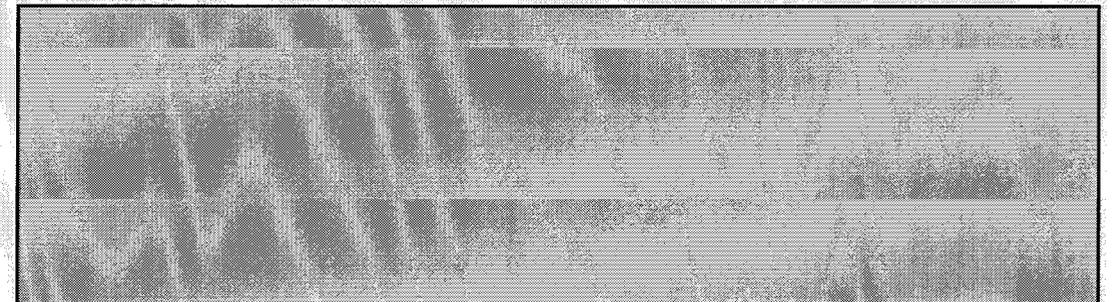

*JAMES CITY COUNTY
ENVIRONMENTAL DIVISION*

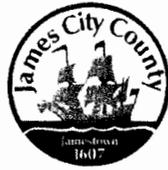

ENVIRONMENTAL DIVISION

STONEHOUSE AREA 1
SEC 7 RICHARDSON MILL POND SEC 1 & 2
TIMBER CRIB WALL ISSUE

101 MOUNTS BAY ROAD
P.O. BOX 8784
WILLIAMSBURG, VA 23185
757-253-6670
FAX 757-259-4032

This was a long-standing issue between the developer (Dominion), the Association at Stonehouse (HOA) and the County. In summary, plans for four timber crib walls WC075 (BMP 7.3), WC076 (BMP 7.4), WC077 (BMP 7.2), and WC078 (BMP 7.1) which are situated within Richardson Mill Section 1 (S-99-01; S-100-02) and Section 2 (S-64-02) were approved as dry ponds, quantity only, with a composite design (wall and embankment) which allowed the basins to serve as temporary sediment basins during construction. Given topography and anticipated erosion and sedimentation during Land-Disturbing activities, the most effective E&S control for these sites were determined to be temporary sediment basins. Around February 2005, the engineer for the project sent a letter to the County (February 15, 2005) requesting the County to consider allowing the structures to remain as wet pond features. The County entertained this request through investigation and knowledge of the plans and site features. From the County perspective, it was initially explored for six reasons 1) County RPA regulation changes in 2004 and disruption to what would now be RPA; 2) wet ponds are better for water quality than dry ponds; 3) base flows that were not disclosed during design but were clearly evident during construction; and 4) the basins were designed for temporary sediment basin wet pools thus could handle permanent pools; 5) function of dry versus wet and increased maintenance and hazards associated with dry ponds; and 6) the disruption to established neighborhoods and homes due to construction associated with backfilling the basins per the approved plans.

Without stating approval or disapproval of the request, the County required several issues to be addressed (March 16, 2005) including geotechnical, maintenance and mosquito-vector related. The engineer for the project provided various information to support these concerns. The County again requested additional information in March 16, 2006 and more information was provided by the engineer. Proper asbuilts and construction certifications were also received for the BMPs in a wet pool mode. Requests for information continued into early 2007.

The HOA got involved with the issue in July 2006 by specifically requesting that the HOA grounds and maintenance committee be allowed to accompany the County on all inspections of BMPs in Stonehouse. A response was provided by the County (August 2, 2006) as well as first contact BMP educational material. Around February of 2007, the HOA strongly began to insist that the four BMPs be installed per the plan in dry pond mode against the engineer and County's recommendation to allow the BMPs to be converted to wet pond mode, as they existed during construction. Emails from the HOA were received in early 2007 indicating opposition. The County's response at that time is that the developer was allowed a chance to present their case with supporting information before a decision was rendered.

A meeting with representatives of the developer occurred in April 2007. At this meeting the County and developer looked at status of the request and information provided. The County decided to play an intermediate role between the developer and HOA on the issue and would set a meeting with the HOA to present the position on allowing the four BMPs to remain with wet pools.

A second formal request to allow the BMPs to remain as wet pools was received from the engineer on May 21, 2007. The request did not address safety issues and long term effects to the wall as questioned by the County. An email was issued by the County on June 15, 2007. The County also performed a mosquito-vector analyses of the BMPs in their current wet pool (temporary sediment basin) condition.

Timber Crib Wall Issue in Stonehouse Richardson Mill

- Stonehouse Development Area One
- Site Location
- Brief History of Stormwater Management in Stonehouse
- Typical Process (Bond Release)
- Approved Plans

Stonehouse, Sec 7A, Richardson Mill Pond Section 1, (S-99-01, amended S-100-02)
Stonehouse Sec 7A, Richardson Mill Pond Section 2, (S-64-02, amended S-07-03)
Neither were DRC cases as lots were below 50

- Project & BMP Information

WC 075	BMP # 7.1	Section 1	Timber Crib Wall design
WC 076	BMP # 7.2	Section 1	Timber Crib Wall design
WC 077	BMP # 7.3	Section 2	Timber Crib Wall design
WC 078	BMP # 7.4	Section 2	Timber Crib Wall design

\$ 50,000	E&S Bond being held for Section 1;
\$130,000	E&S Bond being held for Section 2;
Released	Subdivision Bond being held for Section 1
Released	Subdivision Bond being held for Section 2

- Photographs: Note steep slopes and remote location

- Plan Approval

- Timber walls allowed in "intermittent" stream areas; followed prior Ches Bay regulations (USGS Blue Line)
- Unique Temporary Sediment Basin Design
- Staff review and approval
- Staff compliance inspections

Parties Involved:

SDC

Bill Mistr
Eng Heath
Glenn Oder (Representative of owner)
Tori Bains (Engineer)
Marc Bennett (Engineer)
Aaron Small (Engineer)
Ray Nice (Contractor)

Association at Stonehouse, Inc.

Robert Spencer, President
Mike Randall, Ground & Maint
Caroline Lott
Ken Kievit
Bob Wargo
Ken Hook
Bruce Lanton
Jim Haynes
Charlie Purcer
Roger Schmidt

Various office meetings with both parties
Full day meeting with HOA (office & field) on July 5, 2007
Various miscellaneous emails from citizens in Stonehouse

Variance Request

- During construction, in accordance with 4VAC50-30-50 (administrative, if not approved within 10 days, then disapproved
- Originally received February 15, 2005
- County staff performed inspections & had some questions, concerns
- Reports and information forwarded by owner/engineer to address County remarks on:

- Structural
- Water Quality
- Safety
- Mosquito-Vector
- Water Quality

- Final reports and documentation received on October 8, 2007

This was performed by the Mosquito Control Specialist for the County on June 28, 2007. A report was issued and provided to the HOA.

County staff (Chief Civil Engineer, Scott Thomas) and Inspection Supervisor (Joe Buchite) met with the representatives of the HOA on July 5, 2007. The purpose of the meeting was BMP education, review of the approved plan configurations, and site visits to each of the timber wall BMPs. As County staff was receiving mixed signals from HOA representatives about their desires for the BMPs, the Chief Engineer asked that the HOA provide a letter stating their preference, so that it could be included in the overall County's decision. This was provided by the Association President on July 26, 2007.

Meeting and correspondence on this situation continued throughout the rest of 2007. On February 1st 2008, the County met with representatives of the developer and informed them that the basins would need to be constructed in accordance with the approved plans as dry detention facilities and consistent with the preferences by the HOA, who would be responsible for long-term maintenance of the facilities in accordance with recorded Inspection/Maintenance agreements.

Work by the contractor finished around September /October 2008 and HOA representatives accompanied the County inspector of final inspections on the four BMPs. This occurred on October 10, 2008. Both parties appeared to be satisfied with the work. Asbuilt drawings were also received and reviewed by County staff for the final configurations and found to be satisfactory. The Division Director (Scott Thomas) accompanied the assigned County Inspector (Mike Majdeski) in the field for a brief inspection on October 23, 2008 to visit the final products. All appeared satisfactory.

The Director followed up with a call to the HOA Grounds and Maintenance member, Mike Randall on September 29, 2008 to ensure that the HOA was satisfied with the work. Although not part of the County's normal process, this courtesy was warranted given the history of the issue and established partnerships between the County and HOA.

Throughout this whole process, County staff kept the Stonehouse District supervisor(s) apprised of the situation that had developed and was ongoing with this issue.



Scott Thomas
10-29-08