



CERTIFICATE OF AUTHENTICITY

THIS IS TO CERTIFY THAT THE FOLLOWING ELECTRONIC RECORDS ARE TRUE AND ACCURATE REPRODUCTIONS OF THE ORIGINAL RECORDS OF JAMES CITY COUNTY GENERAL SERVICES DEPARTMENT- STORMWATER DIVISION; WERE SCANNED IN THE REGULAR COURSE OF BUSINESS PURSUANT TO GUIDELINES ESTABLISHED BY THE LIBRARY OF VIRGINIA AND ARCHIVES; AND HAVE BEEN VERIFIED IN THE CUSTODY OF THE INDIVIDUAL LISTED BELOW.


BMP NUMBER: YC030

DATE VERIFIED: January 14, 2013

QUALITY ASSURANCE TECHNICIAN: Leah Hardenbergh

Leah Hardenbergh

LOCATION: WILLIAMSBURG, VIRGINIA

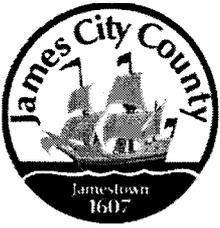

Stormwater Division

MEMORANDUM

DATE: March 12, 2010
TO: Michael J. Gillis, Virginia Correctional Enterprises Document Management Services
FROM: Jo Anna Ripley, Stormwater
PO: 270712
RE: Files Approved for Scanning

General File ID or BMP ID: YC030

PIN: 2320900001C

Subdivision, Tract, Business or Owner

Name (if known):

Colonial Heritage

Property Description:

Common Open Space #2 Phase 1 Section 2

Site Address:

(For internal use only)

Box 22

Drawer: 9

Agreements: (in file as of scan date)

Y

Book or Doc#:

030017308

Page:

030000331

Comments

COPY

COUNTY OF JAMES CITY, VIRGINIA

DECLARATION OF COVENANTS

INSPECTION/MAINTENANCE OF DRAINAGE SYSTEM

THIS DECLARATION, made this 4TH day of JUNE, 2003,
between COLONIAL HERITAGE LLC
and all successors in interest, ("COVENANTOR(S),") owner(s) of the following property: COLONIAL HERITAGE, PHASE 1 SECTION 3 & 3A
project name, COLONIAL HERITAGE
Document No. 030000331, Deed Book _____, Page No. _____; Instrument No. _____, and the County of James City, Virginia ("COUNTY.")

WITNESSETH:

We, the COVENANTOR(S), with full authority to execute deeds, mortgages, other covenants, and all rights, titles and interests in the property described above, do hereby covenant with the COUNTY as follows:

1. The COVENANTOR(S) shall provide maintenance for the drainage system including any runoff control facilities, conveyance systems and associated easements, hereinafter referred to as the "SYSTEM," located on and serving the above-described property to ensure that the SYSTEM is and remains in proper working condition in accordance with approved design standards, and with the law and applicable executive regulations. The SYSTEM shall not include any elements located within any Virginia Department of Transportation rights-of-way.
2. If necessary, the COVENANTOR(S) shall levy regular or special assessments against all present or subsequent owners of property served by the SYSTEM to ensure that the SYSTEM is properly maintained.
3. The COVENANTOR(S) shall provide and maintain perpetual access from public right-of-ways to the SYSTEM for the COUNTY, its agent and its contractor.
4. The COVENANTOR(S) shall grant the COUNTY, its agent and its contractor a right of entry to the SYSTEM for the purpose of inspecting, operating, installing, constructing, reconstructing, maintaining or repairing the SYSTEM.
5. If, after reasonable notice by the COUNTY, the COVENANTOR(S) shall fail to maintain the SYSTEM in accordance with the approved design standards and with the law and applicable executive regulations, the COUNTY may perform all necessary repair or maintenance work, and the COUNTY may assess the COVENANTOR(S) and/or all property served by the SYSTEM for the cost of the work and any applicable penalties.

Instrument # 030017308

Recorded on June 11, 2003

6. The COVENANTOR(S) shall indemnify and save the COUNTY harmless from any and all claims for damages to persons or property arising from the installation, construction, maintenance, repair, operation or use of the SYSTEM.


7. The COVENANTOR(s) shall promptly notify the COUNTY when the COVENANTOR(S) legally transfers any of the COVENANTOR(S)' responsibilities for the SYSTEM. The COVENANTOR(S)' shall supply the COUNTY with a copy of any document of transfer, executed by both parties.

8. The covenants contained herein shall run with the land and shall bind the COVENANTOR(S) and the COVENANTOR(S)' heirs, executors, administrators, successors and assignees, and shall bind all present and subsequent owners of property served by the SYSTEM.

9. This COVENANT shall be recorded in the County Land Records.

IN WITNESS WHEREOF, the COVENANTOR(S) have executed this DECLARATION OF COVENANTS as of the date first above written.

COVENANTOR(S)

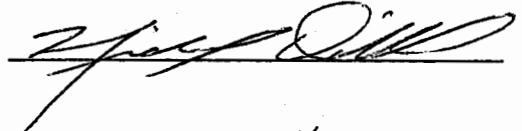

Print Name/Title

Michael O'Hara Vice President

ATTEST:



COVENANTOR(S)

Print Name/Title

ATTEST:

COMMONWEALTH OF VIRGINIA
CITY/COUNTY OF James City

I hereby certify that on this 4 day of June, 2003, before the subscribed, a Notary Public of the State of Virginia, and for the City/County of James City, aforesaid personally appeared Michael Dillard and did acknowledge the foregoing instrument to be their Act.


IN WITNESS WHEREOF, I have hereunto set my hand and official seal this 4 day of June, 2003.

Pamela D. Callis
Notary Public

My Commission expires: 8/31/06

Approved as to form:

Lee P. Rogers
County Attorney

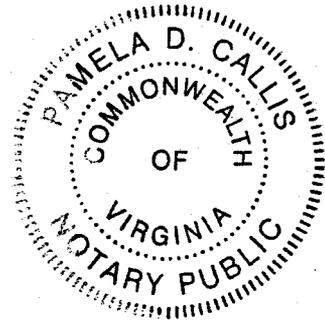

This Declaration of Covenants prepared by:

Brian J. Rettman
(Print Name)
Construction Manager
(Title)
6895 Richmond Road
(Address)
Williamsburg VA 23188
(City) (State) (Zip)

drainage.pre

Colonial Heritage
Phase 1, Section 3



Colonial Heritage

WILLIAMSBURG, VIRGINIA

BMP 3.1

As-Built Report

James City County Environmental
June 13, 2006

RECEIVED

OCT 3 2007

ENVIRONMENTAL
DIVISION



**James City County Environmental Division
Stormwater Management/BMP Record Drawing &
Construction Certification Review
Tracking Form**

Project Name: COLONIAL HERITAGE P1 S3 POND 3.1
County Plan No.: S-073-02
Stormwater Management Facility: DRY DETENTION BASIN
BMP Phase #: I II III
 Information Package Received. Date/By: 8/29/04 / SST
 Completeness Check:
 Record Drawing Date/By: 9/12/07 / MH
 Construction Certification Date/By: 9/20/07 / MH 10/3/07
 RD/CC Standard Forms (Required for all BMPs after Feb 1st 2001 Only)
 Insp/Maint Agreement # / Date: 03000031 / 6/4/2003
 BMP Maintenance Plan Location: ON ASBUILT DRAWINGS
 Other: _____
 Standard E&S Note on Approved Plan Requiring RD/CC or County comment in plan review
 Yes No Location: ASBUILT DRAWINGS / APPROVED PLAN
 Assign County BMP ID Code #: Code: YC-030
 Preliminary Input/Log into Division's "As-Built Tracking Log"
 Add Location to GIS Map. Obtain basic site information (GPIN, Owner, Address, etc.)
 Preliminary Log into Access Database (BMP ID #, Plan No., GPIN, Project Name, etc.)
 Active Project File Review (correspondence, H&H, design computations, etc.)
 Initial As-Built File setup (File label, folder, copy plan/details/design information, etc.)
 Inspector Check of RD/CC (forward to Inspector using transmittal for cursory review).
 Pre-Inspection Drawing Review of Approved Plan (Quick look prior to Field Inspection).
 Final Inspection (FI) Performed Date: 9/13/07
 Record Drawing (RD) Review Date: 9/12/07
 Construction Certification (CC) Review Date: 9/13/07
 Actions:
 No comments.
 Comments. Letter Forwarded. Date: 9/20/2007
 Record Drawing (RD)
 Construction Certification (CC) - NEEDS OFFICIAL SEALS - OK AS OF 10/5/07
 Construction-Related (CR)
 Site Issues (SI) - MINOR EMISSION ISSUES
 Other: _____
 Second Submission: _____
 Reinspection (if necessary): _____
 Acceptable for SWM Purposes (RD/CC/CR/Other). Ok to proceed with bond release.
 Complete "Surety Request Form".
 Check/Clean active file of any remaining material and finish "As-Built" file.
 Add to County BMP Inventory/Inspection schedule (Phase I, II or III).
 Copy Final Inspection Report into County BMP Inspection Program file.
 Obtain Digital Photographs of BMP and save into County BMP Inventory.
 Request mylar/reproducible from As-Built plan preparer. 10/16/07 OK
 Complete "As-built Tracking Log".
 Last check of BMP Access Database (County BMP Inventory).
 Add BMP to JCC Hydrology & Hydraulic database (optional).
 Add BMP to Municipal BMP list (if a County-owned facility)
 Add BMP to PRIDE BMP ratings database.

Final Sign-Off

Plan Reviewer: _____

Date: _____

*** See separate checklist, if needed.



**James City County, Virginia
Environmental Division**

**Stormwater Management / BMP Facilities
Record Drawing and Construction Certification**

Standard Forms & Instructions

| <u>Contents</u> | Page |
|--|------|
| Record Drawing and Construction Certification Forms | |
| Section 1 – Site Information | 1 |
| Section 2 – Construction Information | 2 |
| Section 3 – Owner / Designer / Contractor Information | 2 |
| Section 4 – Professional Certifications | 3 |
| Section 5 – Certification Requirements and Instructions | 4 |
| | |
| Record Drawing Checklist | |
| I. Methods and Presentation (Required for All Facilities) | 6 |
| II. Minimum Standards (Required for All Facilities) | 6 |
| III. Group A – Wet Ponds | 8 |
| IV. Group B – Wetlands | 9 |
| V. Group C – Infiltration Practices | 10 |
| VI. Group D – Filtering Systems | 11 |
| VII. Group E – Open Channel Systems | 12 |
| VIII. Group F – Extended Dry Detention | 13 |
| IX. Group G – Open Spaces | 14 |
| X. Storm Drainage Systems (Associated with BMP's Only) | 15 |
| XII. Other Systems | 15 |
| XIII. References | 16 |

*Issue Date
February 1, 2001*



James City County, Virginia
Environmental Division

Stormwater Management / BMP Facilities
Record Drawing and Construction Certification Forms

(Note: In accordance with the requirements of the Chesapeake Bay Preservation Ordinance, Chapter 23, Section 23-10(4), BMP's shall be designed and constructed in accordance with the manual entitled James City County Guidelines for Design and Construction of Stormwater Management BMP's. Erosion and sediment control policy and approved plans generally require that at the completion of the project and prior to release of surety, an "as-built" plan prepared by a registered Professional Engineer or Certified Land Surveyor must be provided for the drainage system for the project, including any Best Management Practice (BMP) facilities. In addition, for BMP facilities involving the construction of an impounding structure or dam embankment, certification is required by a Professional Engineer who has inspected the structure during its construction. Currently there are over 20 water quality type BMP's accepted by the County.)

Section 1 - Site Information:

Project Name: Colonial Heritage Phase 1 - Section 3
Structure/BMP Name: JCC# YC-030 (WEG SWMP #12 - AES BMP# 3.1)
Project Location: Colonial Heritage
BMP Location: Section 3
County Plan No.: S-73-02 - SP-104-02

Project Type: Residential Business Tax Map/Parcel No.: (24-3)(1-32)
 Commercial Office BMP ID Code (if known): JCC# YC-030
 Institutional Industrial Zoning District: Stonehouse District
 Public Roadway Land Use: Mixed Use (MU with proffers)
 Other Site Area (sf or acres): 6.9 Acres

Brief Description of Stormwater Management/BMP Facility: James City County Extended Dry Detention Type F-2

Nearest Visible Landmark to SWM/BMP Facility: Williamsburg Dodge 7277 Richmond Road / Williamsburg Pottery Factory P. O. Box 123 Lightfoot, Va 23090

Nearest Vertical Ground Control (if known):
 JCC Geodetic Ground Control USGS Temporary Arbitrary Other
Station Number or Name:
Datum or Reference Elevation:
Control Description:
Control Location from Subject Facility:

Section 2 – Stormwater Management / BMP Facility Construction Information:

PreConstruction Meeting Held for Construction of SWM/BMP Facility: Yes No Unknown

Approx. Construction Start Date for SWM/BMP Facility: _____

Facility Monitored by County Representative during Construction: Yes No Unknown

Name of Site Work Contractor Who Constructed Facility: Jack L. Massie Contractors

Name of Professional Firm Who Routinely Monitored Construction: ECS, Ltd.

Date of Completion for SWM/BMP Facility: 5/28/04

Date of Record Drawing/Construction Certification Submittal: 8/27/04

(Note: Record Drawing and Construction Certifications are required within thirty (30) days of the completion of Stormwater Management and/or BMP facility construction. Record Drawings and Construction Certifications must be reviewed and approved by the James City County Environmental Division prior to final inspection, acceptance and bond or surety release.)

Section 3 – Owner / Designer / Contractor Information:

Owner/Developer: *(Note: Site Owner or Applicant responsible for development of the project.)*

Name: U.S. Homes Corp.
Mailing Address: 6895 Richmond Road
Williamsburg, Virginia 23188
Business Phone: 757-258-2705 Fax: 757-258-0516
Contact Person: Mr. Don Fink Title: _____

Design Professional: *(Note: Professional Engineer or Certified Land Surveyor responsible for the design and preparation of plans and specifications for the Stormwater Management / BMP facility.)*

Firm Name: AES Consulting Engineers
Mailing Address: 5284 Olde Towne Road
Suite 1
Business Phone: 757-253-0040
Fax: 757-253-8994
Responsible Plan Preparer: George Archer Marston, III, P.E.
Title: Vice President
Plan Name: Colonial Heritage Phase 1- Section 3
Firm's Project No. 8881-09
Plan Date: 8/13/02
Sheet No.'s Applicable to SWM/BMP Facility: 19 / 24 / _____ / _____ / _____

BMP Contractor: *(Note: Site Work Contractor directly responsible for construction of the Stormwater Management / BMP facility.)*

Name: Jack L. Massie Contractors
Mailing Address: 3900 Cokes Lane
Williamsburg, VA 23188-7010
Business Phone: (757) 566-8643
Fax: (757) 566-8566
Contact Person: Mr. Steve Massie
Site Foreman/Supervisor: Mr. Scott Massie
Specialty Subcontractors & Purpose (for BMP Construction Only):


Section 4 – Professional Certifications:

Certifying Professionals: *(Note: A Registered Professional Engineer or Certified Land Surveyor is responsible for preparation of a Record Drawing, sometimes referred to as an As-Built plan, for the drainage system for the project including any Stormwater Management/BMP Facilities. A Registered Professional Engineer is responsible for the inspection, monitoring and certification of Stormwater Management / BMP facilities during its construction.)*

Record Drawing and Construction Certifications for Stormwater Management / BMP Facilities

Record Drawing Certification

Firm Name: AES Consulting Engineers
Mailing Address: 5248 Olde Towne Road, Suite 1
Williamsburg, VA 23188
Business Phone: (757) 253 0040
Fax: (757) 220 8994

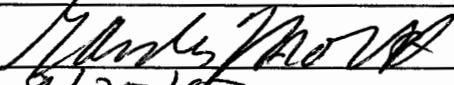Name: George Archer Marston, III, P.E.
Title: Vice President
Signature: 
Date: 9/25/07

I hereby certify to the best of my knowledge and belief that this record drawing represents the actual condition of the Stormwater Management / BMP facility. The facility appears to conform with the provisions of the approved design plan, specifications and stormwater management plan, except as specifically noted.




(Seal)


Virginia Registered Professional Engineer
Or Certified Land Surveyor

Construction Certification

Firm Name: ECS, Ltd.
Mailing Address: 108 Ingram Road, Unit 1
Williamsburg, VA 23188
Business Phone: (757) 229-6677
Fax: (757) 229-9978

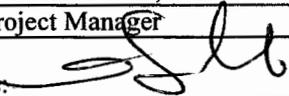Name: Michael J. Galli, P.E.
Title: Project Manager
Signature: 
Date: 9/28/07

I hereby certify to the best of my knowledge and belief that this Stormwater Management / BMP facility was monitored and constructed in accordance with the provisions of the approved design plan, specifications and stormwater management plan, except as specifically noted.

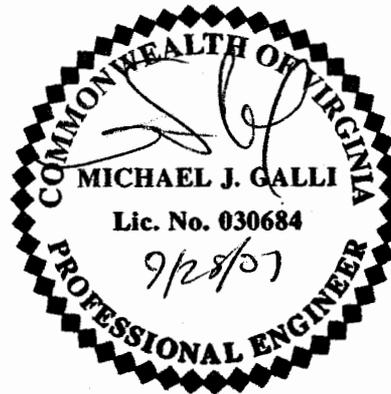

(Seal)

Virginia Registered
Professional Engineer

Section 5 – Record Drawing and Construction Certification Requirements and Instructions:

- ❑ PreConstruction Meeting – Provides an opportunity to review SWM / BMP facility construction, maintenance and operation plans and address any questions regarding construction and/or monitoring of the structure. The design engineer, certifying professionals (if different), Owner/Applicant, Contractor and County representative(s) are encouraged to attend the preconstruction meeting. Advanced notice to the Environmental Division is requested. Usually, this requirement can be met simultaneously with Erosion and Sediment Control preconstruction meetings held for the project.
- ❑ A fully completed ***STORMWATER MANAGEMENT / BMP FACILITIES, RECORD DRAWING and CONSTRUCTION CERTIFICATION FORM and RECORD DRAWING CHECKLIST***. All applicable sections shall be completed in their entirety and certification statements signed and sealed by the registered professional responsible for individual record drawing and/or construction certification.
- ❑ The Record Drawing shall be prepared by a Registered Professional Engineer or Certified Land Surveyor for the drainage system of the project including any Best Management Practices.
- ❑ Construction Certification. Construction of Stormwater Management / BMP facilities which contain impoundments, embankments and related engineered appurtenances including subgrade preparation, compacted soils, structural fills, liners, geosynthetics, filters, seepage controls, cutoffs, toe drains, hydraulic flow control structures, etc. shall be visually observed and monitored by a Registered Professional Engineer or his/her authorized representative. The Engineer must certify that the structure, embankment and associated appurtenances were built in accordance with the approved design plan, specifications and stormwater management plan and standard accepted construction practice and shall submit a written certification and/or drawings to the Environmental Division as required. Soil and compaction test reports, concrete test reports, inspection reports, logs and other required construction material or installation documentation may be required by the Environmental Division to substantiate the certification, if specifically requested. The Engineer shall have the authority and responsibility to make minor changes to the approved plan, in coordination with the assigned County inspector, in order to compensate for unsafe or unusual conditions encountered during construction such as those related to bedrock, soils, groundwater, topography, etc. as long as changes do not adversely affect the integrity of the structure(s). Major changes to the approved design plan or structure must be reviewed and approved by the original design professional and the James City County Environmental Division.
- ❑ Record Drawing and Construction Certifications are required within **thirty (30) days** of the completion of Stormwater Management / BMP facility construction. Submittals must be reviewed and accepted by James City County Environmental Division prior to final inspection, acceptance and bond/surety release.

Dual Purpose Facilities – Completion of construction also includes an interim stage for Stormwater Management / BMP facilities which serve dual purpose as temporary sediment basins during construction and as permanent stormwater management / BMP facilities following construction, once development and stabilization are substantially complete. For these dual purpose facilities, construction certification is required once the temporary sediment basin phase of construction is complete. Final record drawing and construction certification of additional permanent components is required once permanent facility construction is complete.

Interim Construction Certification is required for those dual purpose embankment-type facilities that are generally ten (10) feet or greater in dam height (*) and may not be converted, modified or begin function as a permanent SWM / BMP structure for a period generally ranging from six (6) to eighteen (18) months or more from issuance of a Land Disturbance permit for construction.

Interim or final record drawing and construction certifications are not required for temporary sediment basins which are designed and constructed in accordance with current minimum standards and specifications for temporary sediment basins per the Virginia Erosion and Sediment Control Handbook (VESCH); have a temporary service life of less than eighteen (18) months; and will be removed completely once associated disturbed areas are stabilized, unless a distinct hazard to the public's health, safety and welfare is determined by the Environmental Division due to the size or presence of the structure or due to evidence of improper construction.

(*Note: Dam Height as referenced above is generally defined as the vertical distance from the natural bed of the stream or waterway at the downstream toe of the embankment to the top of the embankment structure in accordance with 4VAC50-20-30, Virginia Impoundment Structure Regulations and the Virginia Dam Safety Program.)

- Record Drawings shall provide, at a minimum, all information as shown within these requirements and the attached **RECORD DRAWING CHECKLIST** specific to the type of SWM/BMP facility being constructed. Other additional record data may be formally requested by the James City County Environmental Division. *(Note: Refer to the current edition of the James City County Guidelines for Design and Construction of Stormwater Management BMP's manual for a complete list of acceptable BMP's. Currently there are over 20 acceptable water quality type BMP's accepted by the County.)*
- Record Drawings shall consist of blue/black line prints and a reproducible (mylar, sepia, diazo, etc.) set of the approved stormwater management plan including applicable plan views, profiles, sections, details, maintenance plans, etc. as related to the subject SWM / BMP facility. The set shall indicate "**RECORD DRAWING**" in large text in the lower right hand corner of each sheet with record elevations, dimensions and data drawn in a clearly annotated format and/or boxed beside design values. Approved design plan values, dimensions and data shall not be removed or erased. Drawing sheet revision blocks shall be modified as required to indicate record drawing status. Elevations to the nearest 0.1' are sufficiently accurate except where higher accuracy is needed to show positive drainage. Certification statements as shown in Section 4 of the Record Drawing and Construction Certification Form, *or similar forms thereof*, and professional signatures and seals, with dates matching that of the record drawing status in the revision or title block, are also required on all associated record drawing plans, prints or reproducible.
- Submission Requirements. Initial and subsequent submissions for review shall consist of a minimum of one (1) blue/black line set for record drawings and one copy of the construction certification documents with appropriate transmittal. Under certain circumstances, it is understood that the record drawing and construction certification submissions may be performed by different professional firms. Therefore, record drawing submission may be in advance of construction certification or vice versa. Upon approval and prior to release of bond/surety, final submission shall include one (1) reproducible set of the record drawings, one (1) blue/black line set of the record drawings and one (1) copy of the construction certification. Also for current and/or future incorporation into the County BMP database and GIS system, it is requested that the record drawings also be submitted to the Environmental Division on a diskette or CD-ROM in an acceptable electronic file format such as *.dxf, *.dwg, etc. or in a standard scanned and readable format. The electronic file requirement can be discussed and coordinated with Environmental Division staff at the time of final submission.

STORMWATER MANAGEMENT / BMP FACILITIES RECORD DRAWING CHECKLIST

(Key for Checklist is as follows: XX Acceptable N/A Not Applicable Inc Incomplete)

I. Methods and Presentation: (Required for all Stormwater Management / BMP facilities.)

- XX 1. All constructed facilities meet approved design plans, unless otherwise shown. Record information or deviations from approved design plan shown in clearly annotated format and/or boxed beside design values.
- XX 2. Elevations to the nearest 0.1' unless higher accuracy is needed to show positive drainage.
- XX 3. All plan sheets labeled with "RECORD DRAWING" in large text in lower right hand corner (Approved County Plan Number and BMP ID Code can be included if known).
- XX 4. All plans sheet revision blocks modified to indicate date and record drawing status.
- XX 5. All plan sheets have certification statements and certifying professional's signature and seal.

II. Minimum Standards: (Required for all Stormwater Management / BMP facilities, as applicable.)

- XX 1. All requirements of Section I (Methods and Presentation) apply to this section.
- XX 2. Plan Views: Show general location, arrangement and dimensions. Location and alignment shall generally match approved design plans.
- XX 3. Profile or elevations along top or berm of the facility. At a minimum, elevations are required at each end, at intervals not to exceed 50 feet and where low spots may be present. Top of embankment or berm elevations must be no less than design elevation plus any settlement allowances.
- XX 4. Top widths, berm widths and embankment side slopes.
- XX 5. Show length, width and depth of facility or grading, contours or spot elevations as required to verify permanent pool and design storage volumes were met or were reasonably close to the approved design. Evaluation of as-built grading, contours, spot elevations, or cross-sections, may be necessary by the professional to ensure approved design configurations, depths and volumes were closely maintained. If grading or elevations are significantly different from the approved plan, the Environmental Division shall be contacted immediately to determine whether the variation is acceptable or whether further evidence will be required. Facilities which do not closely resemble approved plan grades, elevations or configurations may require regrading by the Contractor; check volumetric computations; and/or a check hydraulic routing to ensure approved design water surface elevations, discharges or freeboard were closely maintained.
- XX 6. Cross-section of the embankment through the principal spillway or outlet barrel. Must extend at least 100 ft. downstream of the pipe outlet or to recorded site property line, whichever is closer. Proper correlation is required between principal spillway (control structure) crest, emergency spillway crest, orifice and weirs and the top of the dam or facility. All elevations and dimensions must reasonably match the design plan or be sequentially relative to each other and the facility must reflect the required design storage volume(s) and/or design depth.
- XX 7. Profile or elevations along the entire centerline of the emergency spillway. Emergency spillway may be steeper, but no flatter or narrower than design.
- XX 8. Elevation of the principal spillway crest or outlet crest of the structure.

- XX 9. Primary control structure (riser) diameter or dimensions, height, type of material and base size. Indicate provisions for access that are present such as steps, ladders, etc.
- XX 10. Dimensions, locations and elevations of outlet orifices, weirs, slots and drains.
- XX 11. Type and size of anti-vortex and trash rack device. Height, diameter, dimensions, bar spacings (if applicable) and elevations relative to the principal spillway crest. Indicate if lockable hatch is present or not.
- Inc 12. Type, location, size and number of anti-seep collars or documentation of other methods utilized for seepage control. **May need to obtain this information during construction.**
- Inc 13. Top of impervious core embankment, core trench limits and elevation of cut-off trench bottom. **May need to obtain this information during construction.**
- XX 14. Elevation of the principal spillway barrel (outlet pipe) inlet and outlet invert.
- XX 15. Outlet barrel diameter, length, slope, type and thickness class of material and type of flared end sections, headwall or endwall.
- XX 16. Outfall protection dimension, type and depth of rock and if underlain filter fabric is present.
- XX 17. BMP interior and periphery landscaping zones conform with arrangements and requirements of the approved design plan.
- XX 18. Maintenance plan taken from approved design plan transposed onto record drawing set.
- N/A 19. Fencing location and type, if applicable to facility.
- XX 20. BMP vicinity properly cleaned of stockpiles and construction debris.
- XX 21. No visual signs of erosion or channel degradation immediately downstream of facility.
- N/A 22. Any other information formally requested by the Environmental Division specific to the constructed SWM/BMP facility.

STORMWATER MANAGEMENT / BMP FACILITIES RECORD DRAWING CHECKLIST

(Key for Checklist is as follows: XX Acceptable N/A Not Applicable Inc Incomplete)

III. Group A – Wet Ponds (Includes A-1 Small Wet Ponds; A-2 Wet Ponds; A-3 Wet Ext Det Ponds.)

- N/A A1. All requirements of Section II, Minimum Standards, apply to Group A facilities.
- N/A A2. Principal spillway consists of reinforced concrete pipe with O-Ring gaskets for watertight joint construction.
- N/A A3. Sediment forebays or pretreatment devices provided at inlets to pond. Generally 4 to 6 ft. deep.
- N/A A4. Access for maintenance and equipment is provided to the forebay(s). Access corridors are at least 12 ft. wide, have a maximum slope of 15 percent and are adequately stabilized to withstand heavy equipment or vehicle use.
- N/A A5. Adequate fixed vertical sediment depth markers installed in the forebay(s) for future sediment monitoring purposes.
- N/A A6. Pond liner (if required) provided. Either clay liners, polyliners, bentonite liners or use of chemical soil additives based on requirements of the approved plan.
- N/A A7. Minimum 6 percent slope safety bench extending a minimum of 15 feet outward from normal pool edge and/or an aquatic bench extending a minimum of 10 feet inward from the normal shoreline with a maximum depth of 12 inches below the normal pool elevation, if applicable, per the approved design plans. (Note: Safety benches may be waived if pond side slopes are no steeper than 4H:1V).
- N/A A8. No trees are present within a zone 15 feet around the embankment toe and 25 feet from the principal spillway structure.
- N/A A9. Wet permanent pool, typically 3 to 6 feet deep, is provided and maintains level within facility.
- N/A A10. Low flow orifice has a non-clogging mechanism.
- N/A A11. A pond drain pipe with valve was provided.
- N/A A12. Pond side slopes are not steeper than 3H:1V, unless approved plan allowed for steeper slope.
- N/A A13. End walls above barrels (outlet pipe) greater than 48 inch in diameter are fenced to prevent a fall hazard.

STORMWATER MANAGEMENT / BMP FACILITIES RECORD DRAWING CHECKLIST

(Key for Checklist is as follows: XX Acceptable N/A Not Applicable Inc Incomplete)

- IV. **Group B – Wetlands:** (Includes B-1 Shallow Marsh; B-2 Ext Det Shallow Wetlands; B-3 Pond Wetland System and B-4 Pocket Wetland).
- N/A B1. Same requirements as Group A Wet Ponds.
- N/A B2. Minimum 2:1 length to width flow path provided across the facility.
- N/A B3. Micropool provided at or around outlet from BMP (generally 3 to 6 ft. deep).
- N/A B4. Wetland type landscaping provided in accordance with approved plan. Includes correct pondscaping zones, plant species, planting arrangements, wetland beds, etc. Wetland plants include 5 to 7 emergent wetland species. Individual plants at 18 inches on center in clumps.
- N/A B5. Adequate wetland buffer provided (Typically 25 ft. outward from maximum design water surface elevation and 15 ft. setback to structures).
- N/A B6. No more than one-half (½) of the wetland surface area is planted.
- N/A B7. Topsoil or wetland mulch provided to support vigorous growth of wetland plants.
- N/A B8. Planting zones staked or flagged in field and locations subsequently established by appropriate field surveying methods for record drawing presentation.

**STORMWATER MANAGEMENT / BMP FACILITIES
RECORD DRAWING CHECKLIST**

(Key for Checklist is as follows: XX Acceptable N/A Not Applicable Inc Incomplete)

- V. **Group C – Infiltration Practices** (Includes C-1 Infiltration Trench; C-2 Infiltration Trench; C-3 Infiltration Basin; and C-4 Infiltration Basin)
- N/A C1. All requirements of Section II, Minimum Standards, apply to Group C facilities as applicable.
- N/A C2. Facility is not located on fill slopes or on natural ground in excess of six (6) percent.
- N/A C3. Pretreatment devices provided prior to entry into the infiltration facility. Acceptable pretreatment devices include sediment forebays, sediment basins, sediment traps, sump pits or inlets, grass channels, plunge pools or other acceptable measures.
- N/A C4. Three (3) or more of the following pretreatment devices provided to protect long term integrity of structure: grass channel; grass filter strip; bottom sand layer; upper filter fabric layer; use of washed bank run gravel aggregate.
- N/A C5. Sides of infiltration practice lined with filter fabric.
- N/A C6. Facility was not used for erosion and sediment control purposes and sediment was prevented from entering the facility to the greatest extent possible during construction.
- N/A C7. Stabilization and acceptable vegetative cover established over contributing drainage area prior to conveyance of stormwater to the facility.
- N/A C8. Minimum one hundred (100) foot separation horizontally from any known water supply well and minimum one hundred (100) foot separation upslope from any building.
- N/A C9. Minimum twenty-five (25) foot separation down gradient from any structure.
- N/A C10. Stormwater outfalls provided for overflow associated with larger design storms.
- N/A C11. No visual signs of erosion or channel degradation immediately downstream of facility.
- N/A C12. Facility does not currently cause any apparent surface or subsurface water problems to downgrade properties.
- N/A C13. Observation well provided.
- N/A C14. Adequate, direct access provided to the facility for future maintenance, operation and inspection.

STORMWATER MANAGEMENT / BMP FACILITIES RECORD DRAWING CHECKLIST

(Key for Checklist is as follows: XX Acceptable N/A Not Applicable Inc Incomplete)

VI. Group D – Filtering Systems *Includes D-1 Bioretention Cells; D-2 Surface Sand Filters; D-3 Underground Sand Filters; D-4 Perimeter Sand Filters; D-5 Organic Filters; and D-6 Pocket Sand Filters)*

- N/A D1. All requirements of Section II, Minimum Standards, apply to Group D facilities.
- N/A D2. Sediment pretreatment devices provided.
- N/A D3. For D-1 BMPs (Bioretention Cells), pretreatment consisting of a grass filter strip below level spreader (deflector); a gravel diaphragm; and mulch and planting soil layers were provided.
- N/A D4. For D-1 BMPs (Bioretention Cells), plantings consist of native plant species; vegetation provided was based on zones of hydric tolerances; trees and understory of shrubs and herbaceous materials were provided; woody vegetation is absent from inflow locations; and trees are located around facility perimeter.
- N/A D5. Facility was not used for erosion and sediment control purposes and sediment was prevented from entering the facility to the greatest extent possible during construction.
- N/A D6. No visible signs of accumulated silt/sediment were present in the facility following construction or alternately, accumulated silt/sediment was properly removed.
- N/A D7. Filtering system is off-line from storm drainage conveyance system.
- N/A D8. Overflow outlet has adequate erosion protection.
- N/A D9. Deflector, diversion, flow splitter or regulator structure provided to divert the water quality volume to the filtering structure.
- N/A D10. Minimum four (4) inch perforated underdrain provided in a clean aggregate envelope layer beneath the facility.
- N/A D11. Minimum fifty (50) foot separation from any slope fifteen (15) percent or greater. Minimum one hundred (100) foot separation horizontally from any known water supply well. Minimum one hundred (100) foot separation upslope and twenty-five (25) foot separation downslope from any building.
- N/A D12. Stabilization and acceptable vegetative cover established over contributing drainage area prior to conveyance of stormwater to the facility.
- N/A D13. No visual signs of erosion or channel degradation immediately downstream of facility.
- N/A D14. Adequate, direct access provided to the pretreatment area and/or filter bed for future maintenance.

**STORMWATER MANAGEMENT / BMP FACILITIES
RECORD DRAWING CHECKLIST**

(Key for Checklist is as follows: **XX** Acceptable **N/A** Not Applicable **Inc** Incomplete)

- VII. Group E – Open Channel Systems** *(Includes E-1 Wet Swales (Check Dams); E-2 Dry Swales; and E-3 Biofilters)*
- N/A E1. All requirements of Section II, Minimum Standards, apply to Group E facilities as applicable.
 - N/A E2. Open channel system has constructed longitudinal slope of less than four (4) percent.
 - N/A E3. No visual signs of erosion in the open channel system's soil and/or vegetative cover.
 - N/A E4. Open channel side slopes are no steeper than 2H:1V at any location. Preferred channel sideslope is 3H:1V or flatter.
 - N/A E5. No visual signs of ponding are present at any location in the open channel system, except at rock check dam locations for E-1 systems (Wet Swales).
 - N/A E6. For E-2 BMPs (Dry Swales), an underdrain system was provided.
 - N/A E7. Treated timber or rock check dams provided as pretreatment devices for the open channel system.
 - N/A E8. Gravel diaphragm provided in areas where lateral sheet flow from impervious surfaces are directly connected to the open channel system.
 - N/A E9. Grass cover/stabilization in the open channel system appears adaptable to the specific soils and hydric conditions for the site and along the channel system.
 - N/A E10. Open channel system areas with grass covers higher than four (4) to six (6) inches were properly mowed.
 - N/A E11. Facility was not used for erosion and sediment control purposes and sediment was prevented from entering the facility to the greatest extent possible during construction.
 - N/A E12. No visible signs of accumulated silt/sediment were present in the facility following construction or alternately, accumulated silt/sediment was properly removed and no adverse affects to the function of the facility are anticipated.
 - N/A E13. For E-3 BMPs (Biofilters), the bottom width is six (6) feet maximum at any location.
 - N/A E14. For E-3 BMPs (Biofilters), sideslopes are 3H:1V maximum at any location.
 - N/A E15. For E-3 BMPs (Biofilters), the constructed channel slope is less than or equal to three (3) percent at any location.
 - N/A E16. For E-3 BMPs (Biofilters), the constructed grass channel is approximately equivalent to the constructed roadway length.

STORMWATER MANAGEMENT / BMP FACILITIES RECORD DRAWING CHECKLIST

(Key for Checklist is as follows: XX Acceptable N/A Not Applicable Inc Incomplete)

- VIII. Group F – Extended Dry Detention** *(Includes F-1 Timber Walls; and F-2 Dry Extended Detention with Forebay)*
- XX F1. All requirements of Section II, Minimum Standards, apply to Group F facilities.
 - XX F2. Basin bottom has positive slope and drainage from all basin inflow points to the riser (or outflow) location.
 - N/A F3. Timber wall BMP used in intermittent stream only. (ie. Prohibited in perennial streams.)
 - XX F4. Forebay provided approximately 20 ft. upstream of the facility. Forebays generally 4 to 6 feet in depth.
 - XX F5. A reverse slope pipe, vertical stand pipe or mini-barrel and riser was provided to prevent clogging
 - XX F6. Principal spillway and outlet barrel provided consisting of reinforced concrete pipe with O-Ring gaskets for watertight joint construction.
 - N/A F7. Mini-barrel and riser, if used, contains a removable trash rack to reduce clogging.
 - XX F8. Low flow orifice, if used, has a minimum diameter of three (3) inches or two (2) inches if internal orifice control was utilized and a small, cage type external trash rack.
 - N/A F9. Timbers properly reinforced or concrete footing provided if soil conditions were prohibitive.
 - N/A F10. Timber wall cross members extended to a minimum depth of two (2) feet below ground elevation.
 - XX F11. Protection against erosion and scour from the low flow orifice and weir-flow trajectory provided.
 - XX F12. Stilling basin or standard outlet protection provided at principal spillway outlet.
 - XX F13. Adequate, direct access provided to the facility. Access corridor to facility is at least ten (10) feet wide, slope is less than twenty (20) percent and appropriate stabilization provided for equipment and vehicle use. Access extends to forebay, standpipe and timber wall, as applicable.
 - N/A F14. No visual signs of undercutting of timber walls or clogging of the low orifice were present.
 - XX F15. No visual signs of erosion or channel degradation immediately downstream of facility.
 - XX F16. No visible signs of accumulated silt/sediment were present in the facility following construction or alternately, accumulated silt/sediment was properly removed and no adverse affects to the function of the facility are anticipated.

STORMWATER MANAGEMENT / BMP FACILITIES RECORD DRAWING CHECKLIST

(Key for Checklist is as follows: XX Acceptable N/A Not Applicable Inc Incomplete)

IX. Group G – Open Spaces (Includes All Open Space Types G-1; G-2; and G-3)

- XX G1. All requirements of Section II, Minimum Standards, apply to Group G facilities as applicable.
- XX G2. Constructed impervious areas appear to conform with locations indicated on the approved plan and appear less than sixty (60) percent impervious in accordance with the requirements of the James City County Chesapeake Bay Preservation Ordinance.
- XX G3. Dedicated open space areas are in undisturbed common areas, conservation easements or are protected by other enforceable instruments that ensures perpetual protection.
- XX G4. Provisions included to clearly specify how the natural vegetated areas utilized as dedicated open space will be managed and field identified (marked).
- XX G5. Adequate protection measures were implemented during construction to protect the defined dedicated open space areas.
- XX G6. Dedicated open space areas were not disturbed during construction (ie. cleared, grubbed or graded).

STORMWATER MANAGEMENT / BMP FACILITIES RECORD DRAWING CHECKLIST

(Key for Checklist is as follows: XX Acceptable N/A Not Applicable Inc Incomplete)

X. Storm Drainage Systems (Associated with BMP's Only)

(Includes all incidental stormwater drainage conveyance systems associated with SWM/BMP facilities such as onsite or offsite storm drains, open channels, inlets, manholes, junctions, outlet protections, deflectors, etc. These facilities are external to the treatment function of, but are directly associated with drainage to and/or from a constructed SWM/BMP facility. The intent of this portion of the certification is to accurately identify the type and quantity of inflow or outflow points associated with the facility for future reference. The Professional may use his/her own discretion to determine inclusive facilities to meet the intent of this section. As a general rule, storm drainage systems would include incidental facilities to the nearest access structure upslope or downslope from the normal physical limits of the facility or 800 feet of storm drainage conveyance system length, whichever is less.)

- XX SD1. All requirements of Section II, Minimum Standards, apply to Storm Drainage Systems.
- XX SD2. Horizontal location of all pipe and structures relative to the SWM/BMP facility.
- XX SD3. Type, top elevation and invert elevation of all access type structures (inlets, manholes, etc.).
- XX SD4. Material type, size or diameter, class, invert elevations, lengths and slopes for all pipe segments.
- XX SD5. Class, length, width and depth of riprap and outlet protections or dimensions of special energy dissipation structures.

XII. Other Systems

(Includes any non-typical, specialty, manufactured or innovative stormwater management/BMP practices or systems generally accepted for use as or in conjunction with other acceptable stormwater management / BMP practices. Requires evidence of prior satisfactory industry use and prior Environmental Division approval, waiver or exception.)

- N/A O1. All requirements of Section II, Minimum Standards, apply to this section.
- N/A O2. Certification criteria to be determined on a case-by-case basis by the Environmental Division specific to the proposed SWM/BMP facility.

STORMWATER MANAGEMENT / BMP FACILITIES RECORD DRAWING CHECKLIST

XIII. References

(The James City County Record Drawing and Construction Certification Forms and Checklists for Stormwater Management / BMP facilities were developed using the following sources and references.)

- Baltimore County, Maryland Soil Conservation District, As-Built Stormwater Management Pond Checklist.
- James City County, Virginia, Guidelines for Design and Construction of Stormwater Management BMP's (October 1999.)
- James City County, Virginia, Stormwater Detention/Retention Basin Design Checklist and Erosion and Sediment Control and Stormwater Management Design Plan Checklists.
- James City County Stormwater Policy Framework, Final Report of the James City County BMP Policy Project, October 1998, The Center for Watershed Protection.
- Prince Georges County, Maryland, As-Built Requirements Retention or Detention Pond/Basin.
- Prince William County, Virginia, Stormwater Management Fact Sheet.
- Stafford County, Virginia As-Built Plan Checklist.
- Stormwater Management Design Manual, NRCS Maryland Code No. 378, Pond Standards and Specifications.
- USEPA/Watershed Management Institute, Stormwater Management Inspection Forms.
- Virginia Impounding Structure Regulations (Dam Safety), Department of Conservation & Recreation, 1997.
- Virginia Erosion and Sediment Control Handbook, Third Edition 1992, Virginia Department of Conservation and Recreation, Division of Soil and Water Conservation.
- Virginia Stormwater Management Handbook, 1999 edition, Virginia Department of Conservation and Recreation, Division of Soil and Water Conservation.

I HEREBY CERTIFY TO THE BEST OF MY JUDGEMENT, KNOWLEDGE, AND BELIEF THAT THIS RECORD DRAWING REPRESENTS THE CONDITIONS OF THE SITE ON THE DATE IT WAS SURVEYED. THE SITE APPEARS TO CONFORM WITH THE PROVISIONS OF THE APPROVED DESIGN PLAN.



COLONIAL HERITAGE
PHASE I, SECTION 2
JCC# S-63-02/SP-88-02
YC030

20' MAINTENANCE AND ACCESS EASEMENT BASED UPON 100 YEAR FLOOD ELEV. (TO BE DEDICATED TO THE COLONIAL HERITAGE HOMEOWNERS ASSOCIATION)
25' BUFFER BASED UPON 100 YEAR FLOOD ELEV. (TO BE DEDICATED TO THE COLONIAL HERITAGE HOMEOWNERS ASSOCIATION)

OUTLET PROTECTION PROVIDE RIPRAP-APRON CONSISTING OF CLASS 1 EROSION CONTROL STONE L=10', W=12', CLASS 1 EMBED 18" DEEP OVER FILTER FABRIC APPROX. 13 S.Y. OF RIP-RAP

SS #14-2
DI=3A, L=15'
STA B2+26.41 R
TOP=86.49
INV.=79.39-D

STORM SYSTEM No. 14

| | | |
|----------|------|----|
| RECEIVED | DATE | BY |
| | | |
| | | |



5248 Olde Towne Road, Suite 1
Williamsburg, Virginia 23188
(757) 253-0040
Fax (757) 220-8994



DRAINAGE, GRADING AND EROSION-
SEDIMENT CONTROL PLAN
PHASE I, SECTION 3 & 3A
COLONIAL HERITAGE
OWNER/DEVELOPER: COLONIAL HERITAGE LLC

| | |
|------------------|---------------|
| Designed HWP/RDS | Drawn RMS/HEB |
| Scale | Date |
| 1" = 30' | 8/13/02 |
| Project No. | 8851-09 |
| Drawing No. | 18 |



STORM SYSTEM No. 13

SS #13-16
DI=7,
TYPE III GRATE
STA 40+39.49 L
TOP=86.00
INV.=81.40

SS #13-3
DI=3CC, L=6'
STA 40+48.80 L
TOP=86.75
INV.=81.00

SS #13-11
DI=7,
TYPE III GRATE
TOP=92.55
INV.=89.55

SS #13-10
DI=3B, L=6'
STA 39+91.97
TOP=91.24
INV.=85.00

SS #13-11
DI=7,
TYPE III GRATE
TOP=92.55
INV.=89.55

SS #13-10
DI=3B, L=6'
STA 39+91.97
TOP=91.24
INV.=85.00

SS #13-11
DI=7,
TYPE III GRATE
TOP=92.55
INV.=89.55

SS #13-10
DI=3B, L=6'
STA 39+91.97
TOP=91.24
INV.=85.00


SS #13-11
DI=7,
TYPE III GRATE
TOP=92.55
INV.=89.55

SS #13-10
DI=3B, L=6'
STA 39+91.97
TOP=91.24
INV.=85.00

SS #13-11
DI=7,
TYPE III GRATE
TOP=92.55
INV.=89.55

SS #13-10
DI=3B, L=6'
STA 39+91.97
TOP=91.24
INV.=85.00

SS #13-11
DI=7,
TYPE III GRATE
TOP=92.55
INV.=89.55

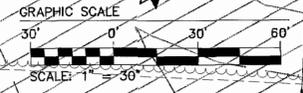

| | | | |
|----------------------|-----------------------|---------------------------|-----------------------|
| DESIGNED | HWP/RDS | DRAWN | RMS/HEB |
| SCALE | 1" = 30' | DATE | 8/13/02 |
| PROJECT NO. | 8881-09 | DRAWING NO. | 19 |
| OWNER/DEVELOPER | COLONIAL HERITAGE LLC | OWNER/DEVELOPER | COLONIAL HERITAGE LLC |
| RECORD DRAWING (BMS) | 7/5/21/04 | REVISION / COMMENT / NOTE | |
| NO. | | | |









5248 Old Towne Road, Suite 1
 Williamsburg, Virginia 23188
 (757) 253-0040
 Fax (757) 220-8994



CONSULTING ENGINEERS
 JAMES CITY COUNTY, VIRGINIA

**DRAINAGE, GRADING AND EROSION-
 SEDIMENT CONTROL PLAN
 PHASE I, SECTION 3 & 3A
 COLONIAL HERITAGE
 OWNER/DEVELOPER: COLONIAL HERITAGE LLC**

| | | | |
|-------------|----------|-------------|---------|
| DESIGNED | HWP/RDS | DRAWN | RMS/HEB |
| SCALE | 1" = 30' | DATE | 8/13/02 |
| PROJECT NO. | 8881-09 | DRAWING NO. | 19 |

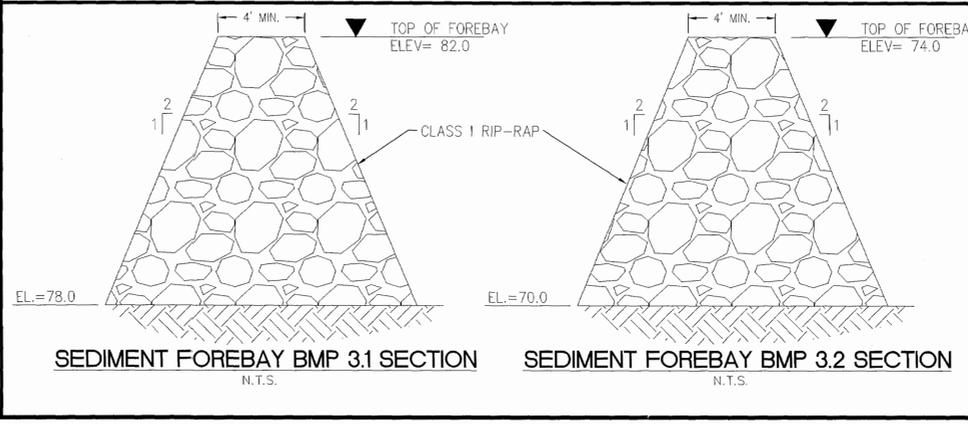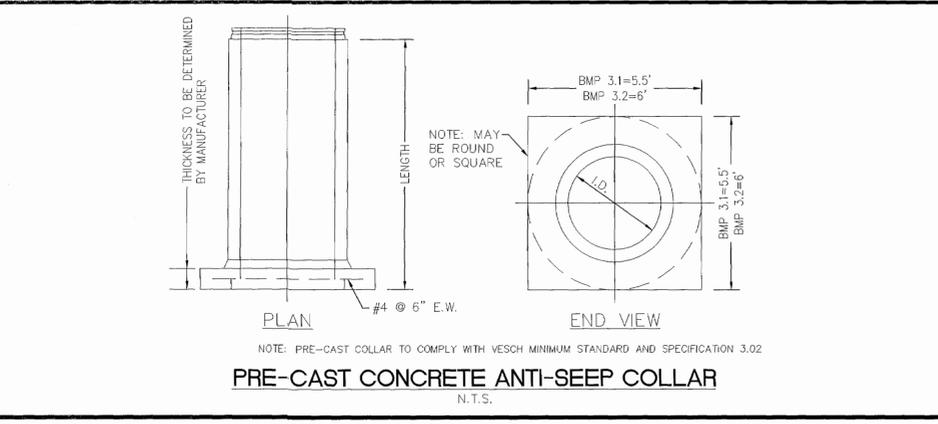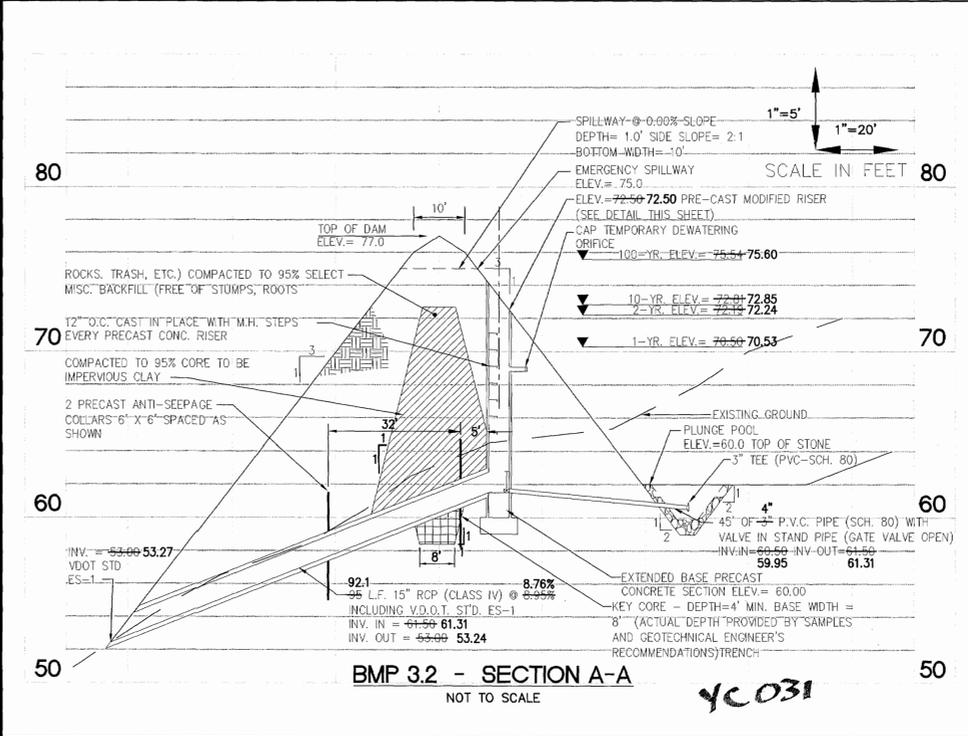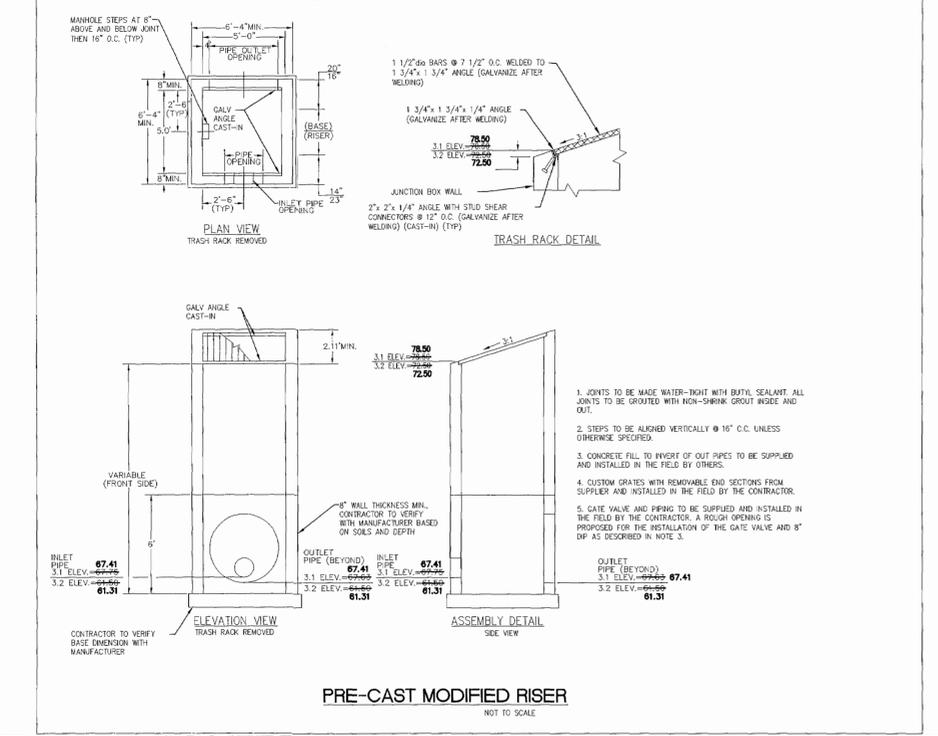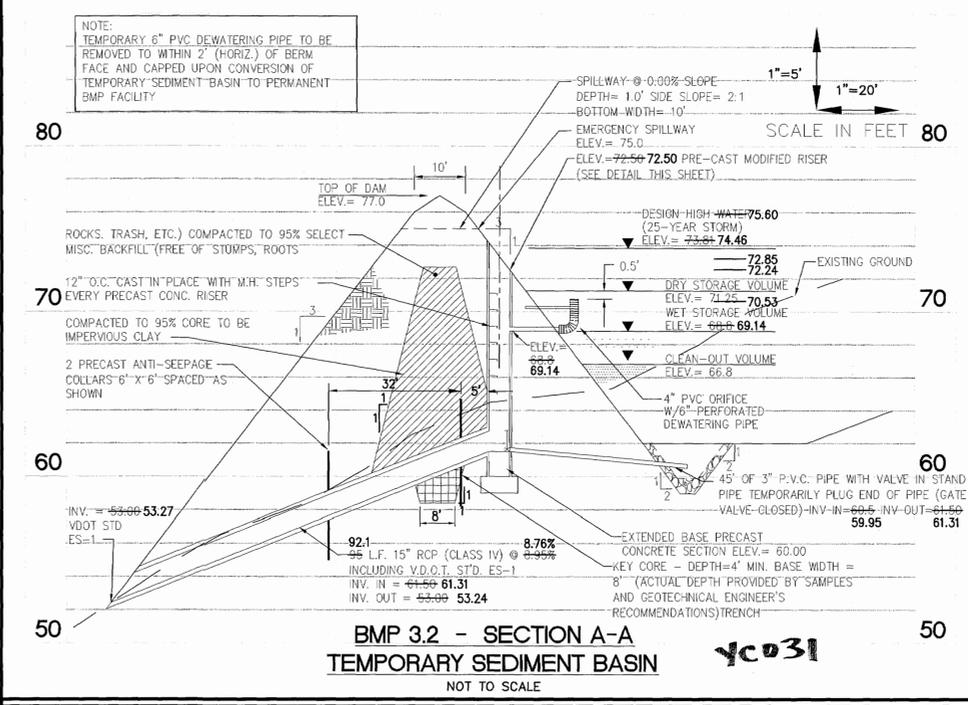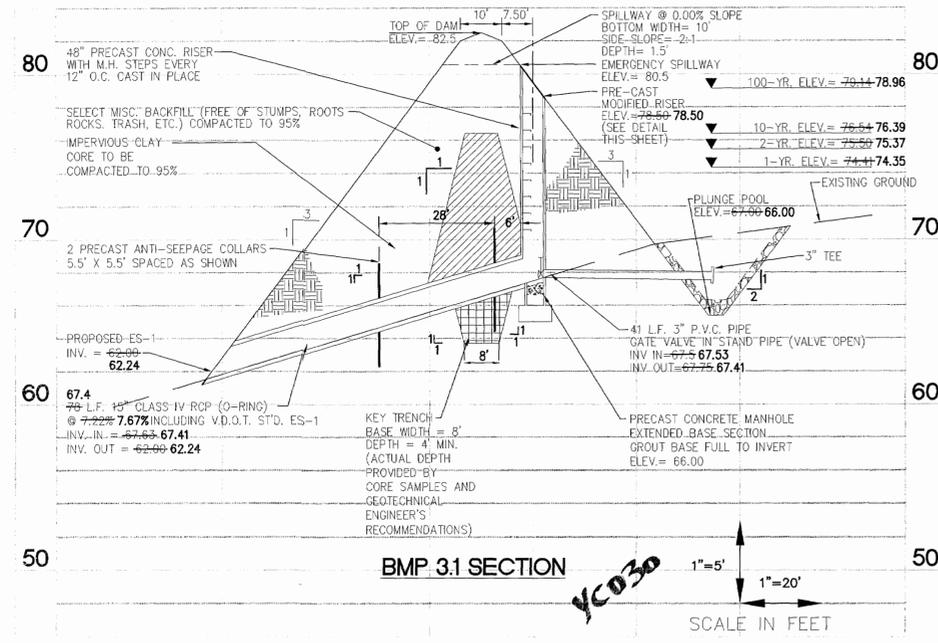

STORMWATER MANAGEMENT/ BMP FACILITY MAINTENANCE PLAN

PROPER MAINTENANCE OF THIS FACILITY IS ENCOURAGED TO PREVENT THE INTRODUCTION OF DEBRIS AND SEDIMENT INTO THE FACILITY, SPILLWAY(S) AND DOWNSTREAM WATERWAYS. FOLLOWING INSTALLATION OF THE FACILITY AND ESTABLISHMENT OF VEGETATION IN DISTURBED AREAS, INSPECTIONS FOR SEDIMENT BUILDUP SHALL BE PERFORMED AT LEAST QUARTERLY. IT IS ANTICIPATED THAT UNDER NORMAL CONDITIONS, SEDIMENT REMOVAL FROM THE FACILITY WILL BE REQUIRED ONCE EVERY YEAR. IF OTHER CONSTRUCTION OR RELATED ACTIVITIES ARE PERFORMED ON UP-SLOPE PARCELS, ADEQUATE PROTECTION SHOULD BE PROVIDED AND INSPECTIONS PERFORMED AT LEAST ONCE WEEKLY OF THESE NEWLY DISTRIBUTED AREAS AS WELL AS INSPECTIONS FOR ACCUMULATED SEDIMENTS AT TWO BMP FACILITIES.

A DESIGNATED REPRESENTATIVE OF THE OWNER SHALL INSPECT THE BMP STRUCTURE AFTER EACH SIGNIFICANT RAINFALL EVENT OR THE FOLLOWING WORKING DAY IF A WEEKEND OR HOLIDAY OCCURS. A SIGNIFICANT RAINFALL FOR THIS STRUCTURE IS DEFINED AS ONE (1) INCH OR MORE OF GAUGED RAINFALL WITHIN A 24 HOUR PERIOD. ONCE PER YEAR, A REPRESENTATIVE OF THE COUNTY MAY JOINTLY INSPECT THE STRUCTURE TO OBTAIN ACTION PERFORMED AT THE COST OF THE OWNER. WILL BE TAKEN TO ENSURE APPROPRIATE MAINTENANCE KEYS TO LOOKED ACCESS POINTS SHALL BE MADE AVAILABLE TO COUNTY INSPECTION PERSONNEL UPON REQUEST.

INSPECTION AND MAINTENANCE OF THE FACILITY WILL CONSIST OF THE FOLLOWING ADDITIONAL MEASURES:

1. THE INSPECTION FOR SEDIMENT BUILDUP WILL BE PERFORMED BY VISUAL INSPECTION AND A PHYSICAL DETERMINATION OF SEDIMENT DEPTH WITHIN THE STORAGE AREA. SEDIMENT REMOVAL IS REQUIRED USING A RUBBER-WHEELED BACKHOE. AT THE SAME TIME, OR AT LEAST ONCE PER YEAR, THE RISER BOTTOM AND OUTLET PIPE SHALL BE CLEANED OF ACCUMULATED SEDIMENTS. DISPOSE OF SEDIMENTS REMOVED FROM THE FACILITY AT AN ACCEPTABLE DISPOSAL AREA. SEDIMENT SHALL NOT BE ALLOWED TO ACCUMULATE IN DEPTHS GREATER THAN 1-FOOT. NO SEDIMENT SHALL BE ALLOWED TO ACCUMULATE TO PREVENT THE PROPER FUNCTION OF ANY PIPE OR CULVERT.
2. PERFORM MAINTENANCE MOWING OF GRASSES AFTER AT LEAST TWICE EACH YEAR. GRASSES SUCH AS TALL FESCUE SHOULD BE MOVED IN EARLY SUMMER AFTER EMERGENCE OF THE HEADS ON COOL SEASON GRASSES AND IN LATE FALL TO PREVENT SEEDS OF ANNUAL WEEDS FROM MATURING. MOWING OF LEGUMES CAN BE LESS FREQUENT TREES AND SHRUBS SHOULD NOT BE PERMITTED TO GROW ON ANY PART OF THE GRADED EMBANKMENT.
3. PERFORM SOIL SAMPLING ON STABILIZED BMP SOIL AREAS ONCE EVERY FOUR (4) YEARS. SOIL SAMPLING AND TESTING SHOULD BE PERFORMED BY A QUALIFIED INDEPENDENT TESTING LABORATORY. APPLY ADDITIONAL LIME AND FERTILIZER IN ACCORDANCE WITH TEST RECOMMENDATIONS.
4. IN STABILIZED BMP AREAS, IF VEGETATION COVERS LESS THAN 40% OF SOIL SURFACES, LIME, FERTILIZER AND SEED IN ACCORDANCE WITH RECOMMENDATIONS FOR NEW SEEDINGS, AS LISTED IN DAM CONSTRUCTION NOTES. IF VEGETATION COVERS MORE THAN 40% BUT LESS THAN 70% OF SOIL SURFACES, LIME FERTILIZE AND OVERSEED IN ACCORDANCE WITH CURRENT SEDDING RECOMMENDATIONS.
5. PERFORM QUARTERLY INSPECTIONS OF THE RELEASE STRUCTURES, RISER SECTION AND CREST OF SPILLWAY FOR THE OBSERVANCE OF COLLECTED DEBRIS. IMMEDIATELY REMOVE ANY DEBRIS TO MAINTAIN THE INTEGRITY OF THE STRUCTURE AND PROVIDE AN ATTRACTIVE APPEARANCE. DURING QUARTERLY INSPECTIONS, THE POND BRIM VALVE, USUALLY LEFT IN THE VALVE "CLOSED" POSITION, SHALL BE INSPECTED AND OPERATED THROUGH TWO COMPLETE FULL-OPEN TO FULL-CLOSE TO FULL-OPEN CYCLES.
6. PERFORM "YEARLY" STRUCTURAL INSPECTIONS OF THE FACILITY FOR DAMAGE. STRUCTURAL INSPECTION SHALL BE IN ACCORDANCE WITH THE CONCRETE RISER, ANTI-VORTEX DEVICE, TRASH RACK, ORIFICE/WEIR(S), OUTLET BARREL AND POND EMBANKMENT. DAMAGE IF ANY, FURTHER INVESTIGATION BY A PROFESSIONAL ENGINEER MAY BE REQUIRED TO ASSESS THE CONTINUED INTEGRITY OF THE STRUCTURE.
7. PERFORM QUARTERLY INSPECTIONS OF THE GRADED SIDE SLOPES OF THE FACILITY FOR SIGNS OF ANNUAL/PROBENT BORROWING OR SLOPE EROSION. IMMEDIATELY PERFORM NECESSARY REPAIRS, REFILLING OR RESEEDING AS APPROPRIATE.
8. RECORD KEEPING: THE LANDOWNER OR DESIGNATED REPRESENTATIVE SHALL KEEP REASONABLE, ACCURATE WRITTEN RECORDS OF INSPECTIONS PERFORMED ON THE STRUCTURE. RECORDS SHALL DOCUMENT ROUTINE MAINTENANCE AND/OR REPAIRS PERFORMED. COPIES SHALL BE PROVIDED TO THE COUNTY UPON REQUEST.
9. THE FACILITY SHALL NOT BE MODIFIED IN ANY WAY WITHOUT PRIOR CONSENT/ APPROVAL OF THE COUNTY.

GENERAL NOTES FOR CONSTRUCTION OF STORMWATER BASINS

1. THE CONTRACTOR SHALL PROVIDE ALL WORK AND MATERIALS NEEDED TO CONSTRUCT THE STORMWATER BASIN, STORMWATER MANAGEMENT POND, BEST MANAGEMENT PRACTICES, SEDIMENT BASINS AND SEDIMENT TRAPS. THE WORK SHALL INCLUDE ALL LABOR, MATERIALS, EQUIPMENT AND MATERIALS NEEDED FOR THE COMPLETION OF GRADING AND EARTHWORK ASSOCIATED WITH THE CONSTRUCTION.
2. THE CONTRACTOR SHALL CONSULT AND PROVIDE FOR THE SERVICES OF A GEOTECHNICAL ENGINEER. THE GEOTECHNICAL ENGINEER SHALL PROVIDE TEST RESULTS ON PLACED DAM MATERIALS, IDENTIFYING SOIL CLASSIFICATION, PERMEABILITY, PLASTICITY INDEX, AND COMPACTION. ALL TESTS SHALL BE IN CONFORMANCE WITH ASTM STANDARDS. THE COST OF THE SERVICES OF THE GEOTECHNICAL ENGINEER SHALL BE THE RESPONSIBILITY OF THE CONTRACTOR. SATISFACTORY GEOTECHNICAL RESULTS ARE NEEDED PRIOR TO FINAL APPROVAL.
3. ALL INSPECTIONS REQUIRED FOR THE WORK SHALL BE PERFORMED BY A GEOTECHNICAL ENGINEER AT THE EXPENSE OF THE GENERAL CONTRACTOR.
4. ON-SITE EXCAVATED MATERIAL, IF DETERMINED SUITABLE FOR USE IN DAM CONSTRUCTION, SHOULD ADDITIONAL MATERIAL BE REQUIRED, THE CONTRACTOR SHALL IDENTIFY THE NEED FOR MATERIAL TO THE OWNER. AS ADDITIONAL BORROW MATERIAL MAY BE AVAILABLE ON THE PROPERTY, ALL EXCAVATED MATERIAL DETERMINED BY THE GEOTECHNICAL ENGINEER TO BE UNSUITABLE SHALL BE DISPOSED OF PROPERLY AT THE CONTRACTOR'S EXPENSE. AN EXCAVATED MATERIAL NOT REQUIRED FOR BACKFILLING SHALL EITHER BE DEPOSITED ON SITE AND SPREAD BY THE CONTRACTOR, OR SHALL BE DEPOSITED IN AN AREA ON THE PROPERTY AS DIRECTED BY THE OWNER. THE CONTRACTOR SHALL PROVIDE PROPER STABILIZATION, AND EROSION AND SEDIMENT CONTROL MEASURES NEEDED TO CONTROL AS PER THE VESCH THIRD EDITION.
5. UNDERCUT FOR THE FOUNDATION OF THE DAM EMBANKMENT SHALL BE IN ACCORDANCE WITH THE GEOTECHNICAL ENGINEER'S RECOMMENDATION. THE FOUNDATION SHALL BE BACKFILLED WITH SOILS CLASSIFIED AS SM, SC, OR CL UNDER THE UNIFIED SOIL CLASSIFICATION SYSTEM. SOILS SHALL HAVE A MINIMUM OF 15% BY WEIGHT FINES, HAVING A PLASTICITY INDEX OF 30% AND A PERMEABILITY OF 0.0004 IN./SEC. OR LESS. FILL SHALL BE COMPACTED IN 12-INCH LIFTS, OR AS DIRECTED BY THE GEOTECHNICAL ENGINEER, TO A DRY DENSITY OF 95% OF THE STANDARD PROCTOR MAXIMUM DRY DENSITY (ASTM D-698). EXCAVATION FOR THE DAM KEY SHALL BE IN ACCORDANCE TO THE GEOTECHNICAL ENGINEER'S RECOMMENDATION. HEIGHT, DEPTH, AND WIDTH OF THE KEY SHALL BE IN ACCORDANCE WITH THE GEOTECHNICAL ENGINEER'S RECOMMENDATIONS. THE KEY SHALL BE FORMED USING SOILS CLASSIFIED AS SC OR CL, WITH A PERMEABILITY OF 0.0004 IN./SEC. OR LESS.
6. THE DAM CORE SHALL BE AS CONSTRUCTED WITH NON-EXPANSIVE SC OR CL CLAYEY MATERIAL WITH PERMEABILITY OF 0.0004 IN./SEC. OR LESS. THE FILL OF THE CORE SHALL BE MADE IN 12-INCH LIFTS, OR AS DIRECTED BY THE GEOTECHNICAL ENGINEER, TO AT LEAST 95% OF THE STANDARD PROCTOR MAXIMUM DRY DENSITY (ASTM D-698). SIZE, SHAPE, WIDTH, DEPTH, AND HEIGHT OF THE DAM CORE SHALL BE IN ACCORDANCE WITH THE GEOTECHNICAL ENGINEER'S RECOMMENDATIONS TO COVER THE DAM CORE, A SILTY FINE SAND OR CLAYEY SOIL (SM, SC, OR CL) SHALL BE PLACED. A VEGETATIVE COVER USING VDOT EC-2 EROSION CONTROL BLANKETS SHALL BE PLACED ON DAM SLOPES AND CREST TO PREVENT EROSION.
7. THE STORMWATER MANAGEMENT / BMP FACILITIES SHOWN ON THESE PLANS REQUIRE THE SUBMISSION, REVIEW AND APPROVAL OF RECORD DRAWING(S) AND CONSTRUCTION CERTIFICATION PRIOR TO RELEASE OF THE POSTED BOND / SURETY. THE GEOTECHNICAL ENGINEER IS TO ENSURE THAT HIS / HER INSPECTION OF THE SWM / BMP CONSTRUCTION ACTIVITY IS PERFORMED DURING AND FOLLOWING CONSTRUCTION OF THE SWM / BMP IN ACCORDANCE WITH THE JAMES CITY COUNTY ENVIRONMENTAL DIVISION STORMWATER MANAGEMENT / BMP FACILITIES, RECORD DRAWING AND CONSTRUCTION CERTIFICATION, STANDARD FORMS AND INSTRUCTIONS.
8. THE CONTRACTOR SHALL PROVIDE INTERIM CERTIFICATION OF TEMPORARY SEDIMENT BASIN IN ACCORDANCE WITH SECTION 5 OF THE JAMES CITY COUNTY ENVIRONMENTAL DIVISION STORMWATER MANAGEMENT / BMP FACILITIES, RECORD DRAWING AND CONSTRUCTION CERTIFICATION, STANDARD FORMS AND INSTRUCTIONS.

| NO. | DATE | REVISION / COMMENT | BY |
|-----|---------|--------------------|-----|
| 7 | 5/21/04 | | JFS |
| | | | |
| | | | |
5248 Olde Towne Road, Suite 1
Williamsburg, Virginia 23188
(757) 253-0040
Fax (757) 220-8994



STORMWATER MANAGEMENT SECTIONS AND NOTES
PHASE I, SECTION 3 & 3A
COLONIAL HERITAGE
 OWNER/DEVELOPER: COLONIAL HERITAGE LLC
 JAMES CITY COUNTY, VIRGINIA

| | | | |
|-------------|---------|-------|---------|
| Designed | JAG | Drawn | ARH |
| Scale | NONE | Date | 8/13/02 |
| Project No. | 8881-09 | | |
| Drawing No. | 24 | | |

S:\Subs\888109-Phase 1\Section 3\dwg\Cad\AS-BUILD\TS\BMP As-built\888109P24.dwg, 7/19/2006 1:20:32 PM, hdb
 RUS 06.02.04-1347 888109P24.dwg

Hydrograph Return Period Recap

| Hyd. No. | Hydrograph type (origin) | Inflow Hyd(s) | Peak Outflow (cfs) | | | | | | | | Hydrograph description |
|----------|--------------------------|---------------|--------------------|-------|-------|-------|-------|-------|-------|--------|------------------------|
| | | | 1-Yr | 2-Yr | 3-Yr | 5-Yr | 10-Yr | 25-Yr | 50-Yr | 100-Yr | |
| 1 | SCS Runoff | ----- | 0.54 | 1.30 | ----- | ----- | 2.30 | 4.68 | ----- | 8.66 | BMP 3.1 - PRE-DEV |
| 3 | SCS Runoff | ----- | 15.59 | 21.62 | ----- | ----- | 28.16 | 41.49 | ----- | 60.49 | BMP 3.1 - POST-DEV |
| 10 | Reservoir | 3 | 0.55 | 0.60 | ----- | ----- | 0.64 | 0.71 | ----- | 5.11 | BMP 3.1 POST-DEV. RTD. |

Hydrograph Summary Report

| Hyd. No. | Hydrograph type (origin) | Peak flow (cfs) | Time interval (min) | Time to peak (min) | Volume (cuft) | Inflow hyd(s) | Maximum elevation (ft) | Maximum storage (cuft) | Hydrograph description |
|------------------------------|--------------------------|-----------------|---------------------|--------------------|-----------------------|---------------|-------------------------------|------------------------|------------------------|
| 1 | SCS Runoff | 0.54 | 2 | 726 | 2,368 | --- | --- | --- | BMP 3.1 - PRE-DEV |
| 3 | SCS Runoff | 15.59 | 2 | 720 | 40,443 | --- | --- | --- | BMP 3.1 - POST-DEV |
| 10 | Reservoir | 0.55 | 2 | 882 | 40,442 | 3 | 74.35 | 23,310 | BMP 3.1 POST-DEV. RTD. |
| BMP-3.1 AS-BUILT 6-13-06.gpw | | | | | Return Period: 1 Year | | Tuesday, Jun 13 2006, 1:48 PM | | |

Hydrograph Summary Report

| Hyd. No. | Hydrograph type (origin) | Peak flow (cfs) | Time interval (min) | Time to peak (min) | Volume (cuft) | Inflow hyd(s) | Maximum elevation (ft) | Maximum storage (cuft) | Hydrograph description |
|----------|--------------------------|-----------------|---------------------|--------------------|---------------|---------------|------------------------|------------------------|------------------------|
| 1 | SCS Runoff | 1.30 | 2 | 724 | 4,435 | --- | --- | --- | BMP 3.1 - PRE-DEV |
| 3 | SCS Runoff | 21.62 | 2 | 720 | 56,371 | --- | --- | --- | BMP 3.1 - POST-DEV |
| 10 | Reservoir | 0.60 | 2 | 934 | 56,371 | 3 | 75.37 | 34,860 | BMP 3.1 POST-DEV. RTD. |

BMP-3.1 AS-BUILT 6-13-06.gpw

Return Period: 2 Year

Tuesday, Jun 13 2006, 1:48 PM

Hydrograph Summary Report

| Hyd. No. | Hydrograph type (origin) | Peak flow (cfs) | Time interval (min) | Time to peak (min) | Volume (cuft) | Inflow hyd(s) | Maximum elevation (ft) | Maximum storage (cuft) | Hydrograph description |
|------------------------------|--------------------------|-----------------|---------------------|--------------------|------------------------|---------------|-------------------------------|------------------------|------------------------|
| 1 | SCS Runoff | 2.30 | 2 | 724 | 7,108 | --- | --- | --- | BMP 3.1 - PRE-DEV |
| 3 | SCS Runoff | 28.16 | 2 | 720 | 74,052 | --- | --- | --- | BMP 3.1 - POST-DEV |
| 10 | Reservoir | 0.64 | 2 | 968 | 74,051 | 3 | 76.39 | 48,240 | BMP 3.1 POST-DEV. RTD. |
| BMP-3.1 AS-BUILT 6-13-06.gpw | | | | | Return Period: 10 Year | | Tuesday, Jun 13 2006, 1:48 PM | | |

Hydrograph Summary Report

| Hyd. No. | Hydrograph type (origin) | Peak flow (cfs) | Time interval (min) | Time to peak (min) | Volume (cuft) | Inflow hyd(s) | Maximum elevation (ft) | Maximum storage (cuft) | Hydrograph description |
|----------|--------------------------|-----------------|---------------------|--------------------|---------------|---------------|------------------------|------------------------|------------------------|
| 1 | SCS Runoff | 8.66 | 2 | 722 | 24,406 | --- | ---- | ---- | BMP 3.1 - PRE-DEV |
| 3 | SCS Runoff | 60.49 | 2 | 720 | 165,337 | --- | ---- | ---- | BMP 3.1 - POST-DEV |
| 10 | Reservoir | 5.11 | 2 | 758 | 165,336 | 3 | 78.96 | 96,420 | BMP 3.1 POST-DEV. RTD. |

BMP-3.1 AS-BUILT 6-13-06.gpw Return Period: 100 Year Tuesday, Jun 13 2006, 1:48 PM

Pond Report

Hydraflow Hydrographs by Intelisolve

Tuesday, Jun 13 2006, 1:47 PM

Pond No. 1 - BMP 3.1

Pond Data

Pond storage is based on known contour areas. Average end area method used.

Stage / Storage Table

| Stage (ft) | Elevation (ft) | Contour area (sqft) | Incr. Storage (cuft) | Total storage (cuft) |
|------------|----------------|---------------------|----------------------|----------------------|
| 0.00 | 69.00 | 222 | 0 | 0 |
| 1.00 | 70.00 | 861 | 542 | 542 |
| 2.00 | 71.00 | 2,602 | 1,732 | 2,273 |
| 3.00 | 72.00 | 4,499 | 3,551 | 5,824 |
| 4.00 | 73.00 | 6,762 | 5,631 | 11,454 |
| 5.00 | 74.00 | 9,573 | 8,168 | 19,622 |
| 6.00 | 75.00 | 11,569 | 10,571 | 30,193 |
| 7.00 | 76.00 | 13,430 | 12,500 | 42,692 |
| 8.00 | 77.00 | 15,311 | 14,371 | 57,063 |
| 9.00 | 78.00 | 20,789 | 18,050 | 75,113 |
| 10.00 | 79.00 | 23,426 | 22,108 | 97,220 |
| 11.00 | 80.00 | 26,219 | 24,823 | 122,043 |

Culvert / Orifice Structures

| | [A] | [B] | [C] | [D] |
|-----------------|---------|-------|------|------|
| Rise (in) | = 15.00 | 3.00 | 0.00 | 0.00 |
| Span (in) | = 15.00 | 3.00 | 0.00 | 0.00 |
| No. Barrels | = 1 | 1 | 0 | 0 |
| Invert El. (ft) | = 67.41 | 67.41 | 0.00 | 0.00 |
| Length (ft) | = 67.40 | 41.00 | 0.00 | 0.00 |
| Slope (%) | = 7.67 | 0.29 | 0.00 | 0.00 |
| N-Value | = .013 | .013 | .000 | .000 |
| Orif. Coeff. | = 0.60 | 0.60 | 0.00 | 0.00 |
| Multi-Stage | = n/a | Yes | No | No |

Weir Structures

| | [A] | [B] | [C] | [D] |
|----------------|---------|-------|------|------|
| Crest Len (ft) | = 4.13 | 10.00 | 0.00 | 0.00 |
| Crest El. (ft) | = 78.50 | 80.50 | 0.00 | 0.00 |
| Weir Coeff. | = 3.33 | 2.60 | 0.00 | 0.00 |
| Weir Type | = Riser | Broad | --- | --- |
| Multi-Stage | = Yes | No | No | No |

Exfiltration = 0.000 in/hr (Contour) Tailwater Elev. = 0.00 ft

Note: Culvert/Orifice outflows have been analyzed under inlet and outlet control.

Stage / Storage / Discharge Table

| Stage ft | Storage cuft | Elevation ft | Civ A cfs | Civ B cfs | Civ C cfs | Civ D cfs | Wr A cfs | Wr B cfs | Wr C cfs | Wr D cfs | Exfil cfs | Total cfs |
|----------|--------------|--------------|-----------|-----------|-----------|-----------|----------|----------|----------|----------|-----------|-----------|
| 0.00 | 0 | 69.00 | 0.00 | 0.00 | --- | --- | 0.00 | 0.00 | --- | --- | --- | 0.00 |
| 1.00 | 542 | 70.00 | 5.80 | 0.24 | --- | --- | 0.00 | 0.00 | --- | --- | --- | 0.24 |
| 2.00 | 2,273 | 71.00 | 5.80 | 0.33 | --- | --- | 0.00 | 0.00 | --- | --- | --- | 0.33 |
| 3.00 | 5,824 | 72.00 | 5.80 | 0.41 | --- | --- | 0.00 | 0.00 | --- | --- | --- | 0.41 |
| 4.00 | 11,454 | 73.00 | 5.80 | 0.47 | --- | --- | 0.00 | 0.00 | --- | --- | --- | 0.47 |
| 5.00 | 19,622 | 74.00 | 5.80 | 0.53 | --- | --- | 0.00 | 0.00 | --- | --- | --- | 0.53 |
| 6.00 | 30,193 | 75.00 | 5.80 | 0.58 | --- | --- | 0.00 | 0.00 | --- | --- | --- | 0.58 |
| 7.00 | 42,692 | 76.00 | 5.80 | 0.63 | --- | --- | 0.00 | 0.00 | --- | --- | --- | 0.63 |
| 8.00 | 57,063 | 77.00 | 5.80 | 0.67 | --- | --- | 0.00 | 0.00 | --- | --- | --- | 0.67 |
| 9.00 | 75,113 | 78.00 | 5.80 | 0.71 | --- | --- | 0.00 | 0.00 | --- | --- | --- | 0.71 |
| 10.00 | 97,220 | 79.00 | 5.80 | 0.75 | --- | --- | 4.86 | 0.00 | --- | --- | --- | 5.61 |
| 11.00 | 122,043 | 80.00 | 19.93 | 0.18 | --- | --- | 19.75 | 0.00 | --- | --- | --- | 19.93 |

Hydrograph Plot

Hydraflow Hydrographs by Intelisolve

Tuesday, Jun 13 2006, 1:47 PM


Hyd. No. 1

BMP 3.1 - PRE-DEV

Hydrograph type = SCS Runoff
Storm frequency = 1 yrs
Drainage area = 1.90 ac
Basin Slope = 8.0 %
Tc method = USER
Total precip. = 2.80 in
Storm duration = 24 hrs

Peak discharge = 0.54 cfs
Time interval = 2 min
Curve number = 63
Hydraulic length = 300 ft
Time of conc. (Tc) = 15 min
Distribution = Type II
Shape factor = 484

Hydrograph Volume = 2,368 cuft

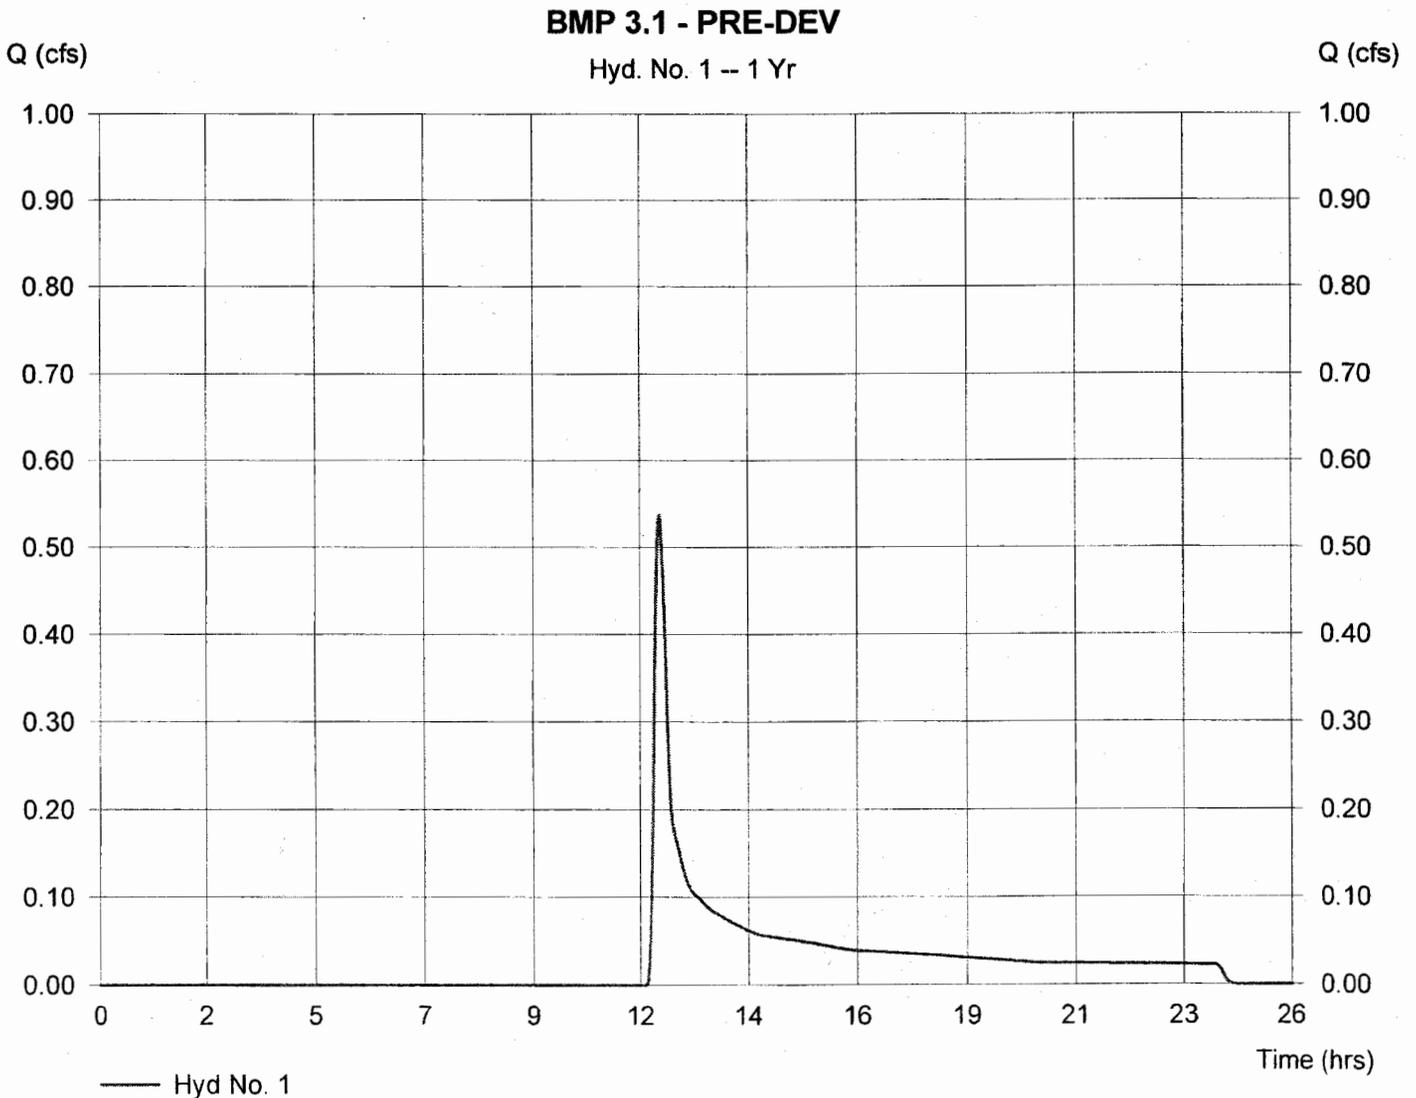

Hydrograph Plot

Hydraflow Hydrographs by Intelisolve

Tuesday, Jun 13 2006, 1:47 PM


Hyd. No. 1

BMP 3.1 - PRE-DEV

Hydrograph type = SCS Runoff
Storm frequency = 2 yrs
Drainage area = 1.90 ac
Basin Slope = 8.0 %
Tc method = USER
Total precip. = 3.50 in
Storm duration = 24 hrs

Peak discharge = 1.30 cfs
Time interval = 2 min
Curve number = 63
Hydraulic length = 300 ft
Time of conc. (Tc) = 15 min
Distribution = Type II
Shape factor = 484

Hydrograph Volume = 4,435 cuft

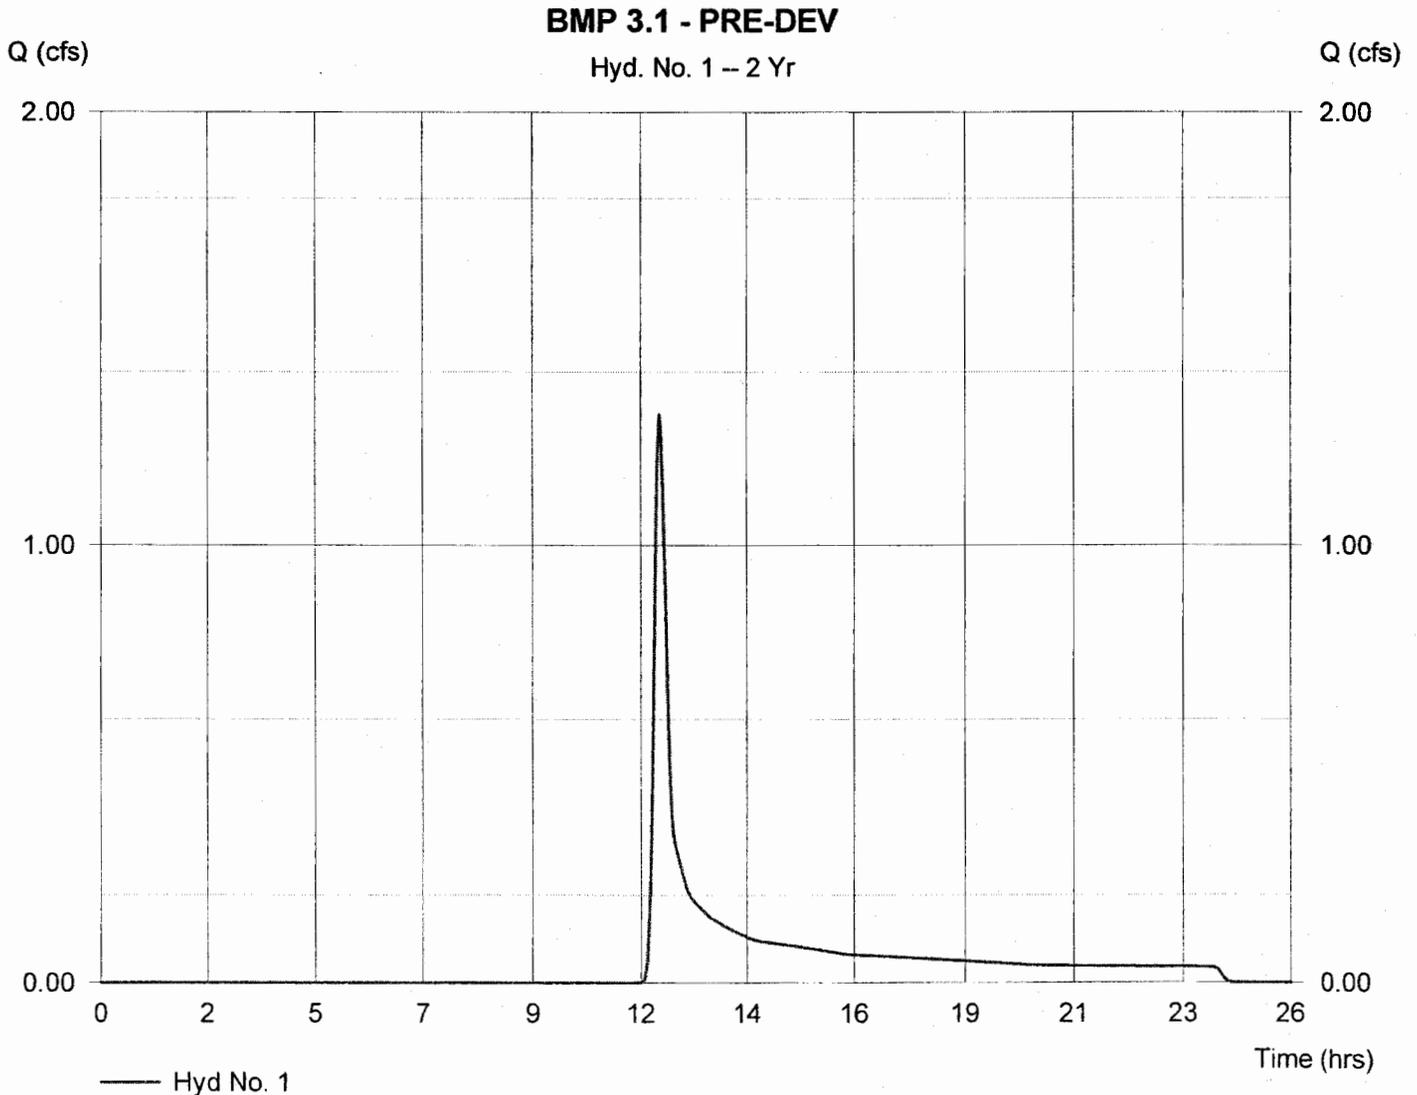

Hydrograph Plot


Hyd. No. 1

BMP 3.1 - PRE-DEV

Hydrograph type = SCS Runoff
Storm frequency = 10 yrs
Drainage area = 1.90 ac
Basin Slope = 8.0 %
Tc method = USER
Total precip. = 4.25 in
Storm duration = 24 hrs

Peak discharge = 2.30 cfs
Time interval = 2 min
Curve number = 63
Hydraulic length = 300 ft
Time of conc. (Tc) = 15 min
Distribution = Type II
Shape factor = 484

Hydrograph Volume = 7,108 cuft

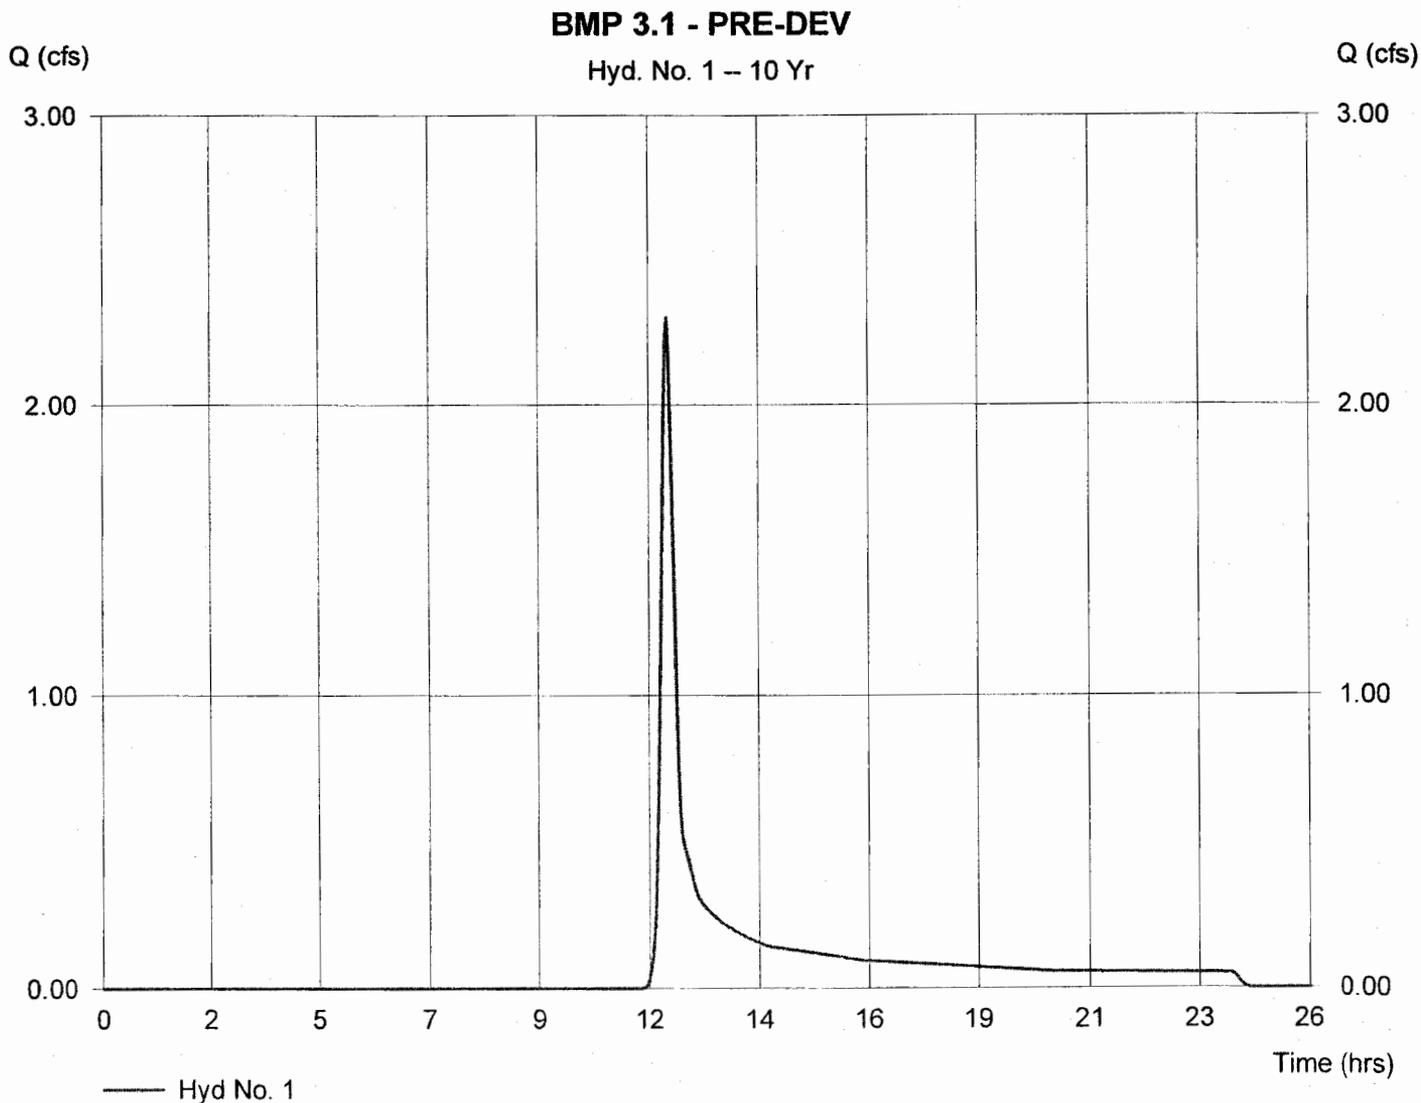

Hydrograph Plot

Hydraflow Hydrographs by Intelisolve

Tuesday, Jun 13 2006, 1:47 PM


Hyd. No. 1

BMP 3.1 - PRE-DEV

Hydrograph type = SCS Runoff
Storm frequency = 100 yrs
Drainage area = 1.90 ac
Basin Slope = 8.0 %
Tc method = USER
Total precip. = 7.95 in
Storm duration = 24 hrs

Peak discharge = 8.66 cfs
Time interval = 2 min
Curve number = 63
Hydraulic length = 300 ft
Time of conc. (Tc) = 15 min
Distribution = Type II
Shape factor = 484

Hydrograph Volume = 24,406 cuft

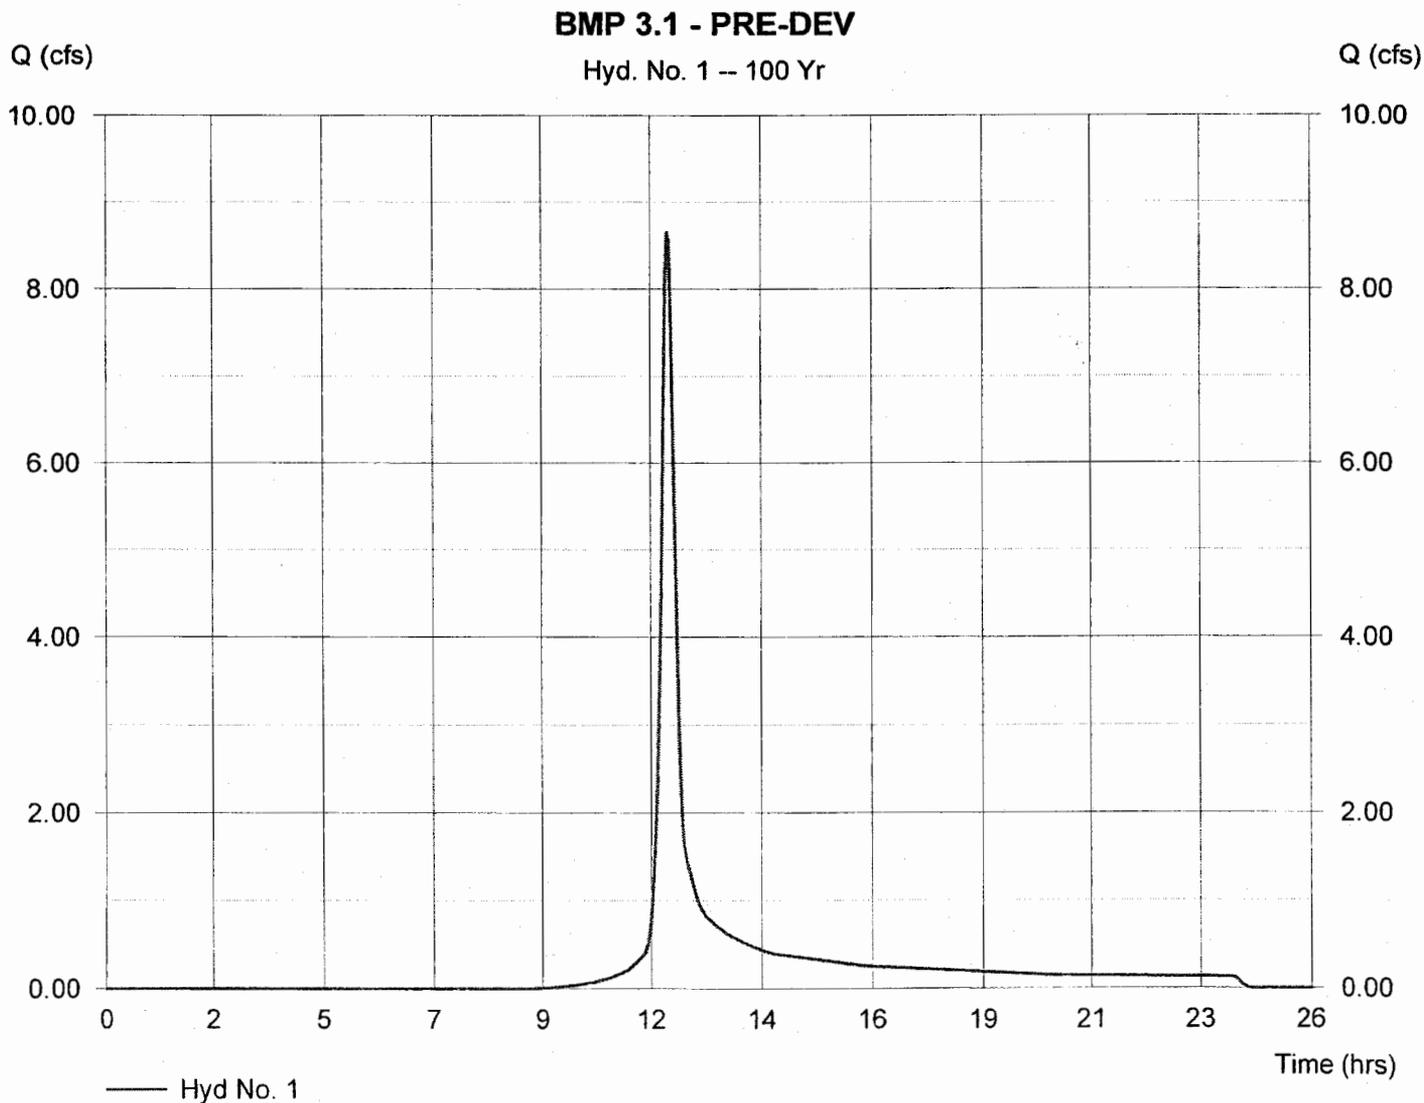

Hydrograph Plot

Hydraflow Hydrographs by Intelisolve

Tuesday, Jun 13 2006, 1:47 PM


Hyd. No. 3

BMP 3.1 - POST-DEV

Hydrograph type = SCS Runoff
Storm frequency = 1 yrs
Drainage area = 6.90 ac
Basin Slope = 8.0 %
Tc method = USER
Total precip. = 2.80 in
Storm duration = 24 hrs

Peak discharge = 15.59 cfs
Time interval = 2 min
Curve number = 87
Hydraulic length = 300 ft
Time of conc. (Tc) = 12 min
Distribution = Type II
Shape factor = 484

Hydrograph Volume = 40,443 cuft

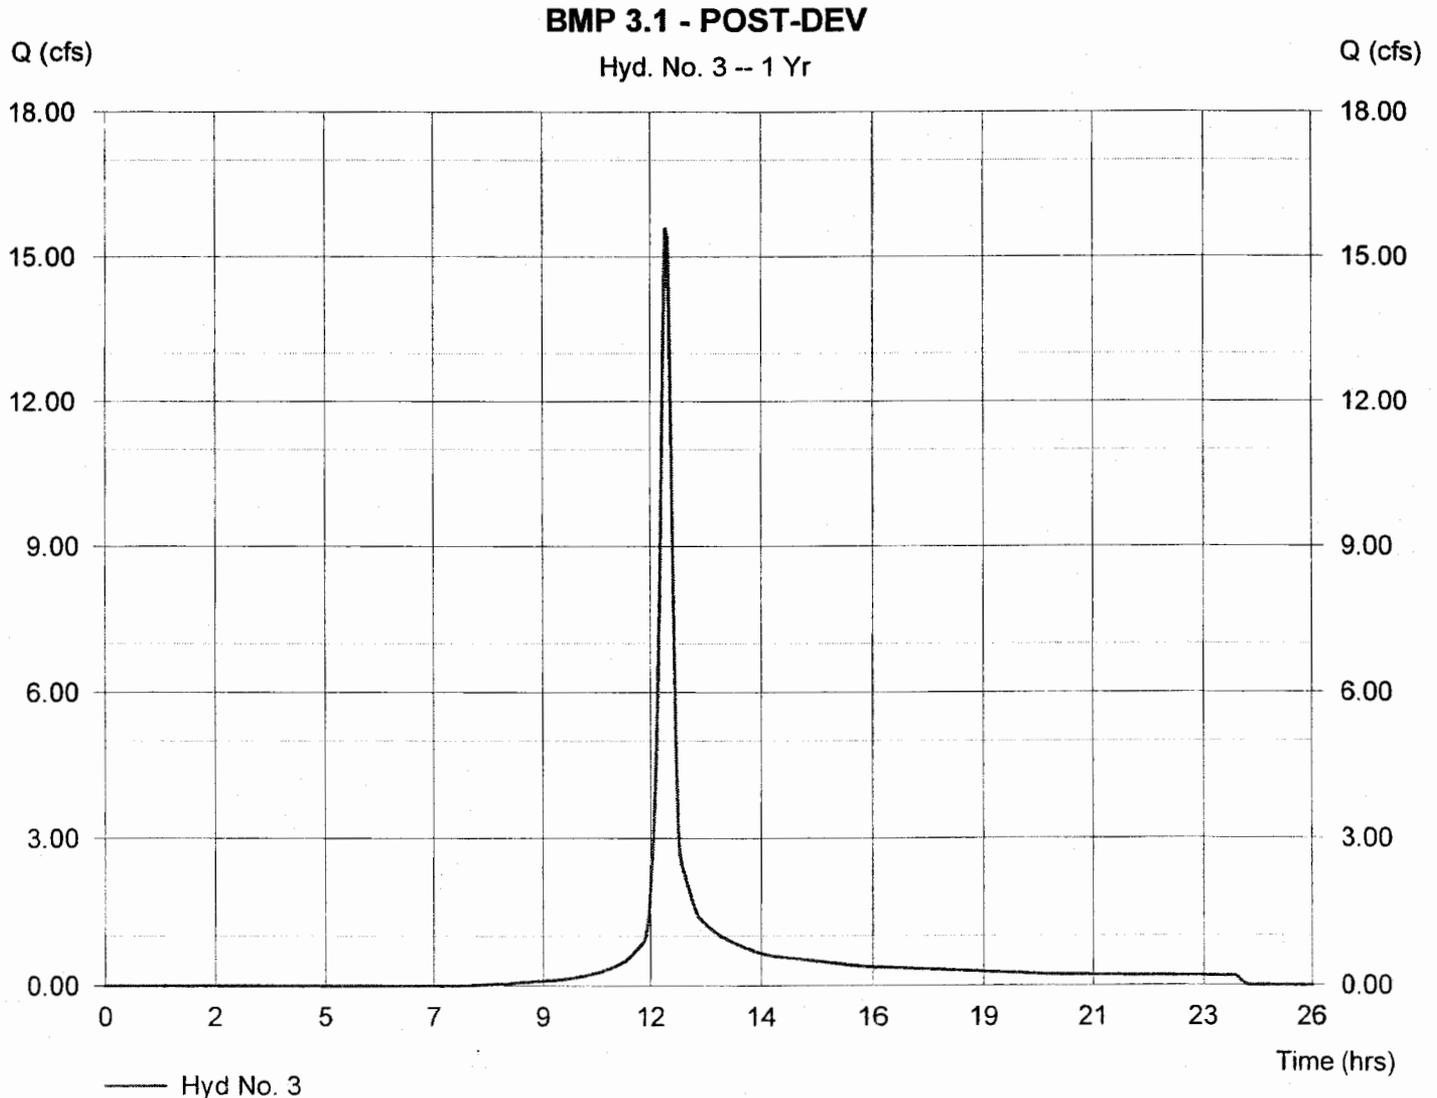

Hydrograph Plot

Hydraflow Hydrographs by Intelisolve

Tuesday, Jun 13 2006, 1:47 PM


Hyd. No. 3

BMP 3.1 - POST-DEV

Hydrograph type = SCS Runoff
Storm frequency = 2 yrs
Drainage area = 6.90 ac
Basin Slope = 8.0 %
Tc method = USER
Total precip. = 3.50 in
Storm duration = 24 hrs

Peak discharge = 21.62 cfs
Time interval = 2 min
Curve number = 87
Hydraulic length = 300 ft
Time of conc. (Tc) = 12 min
Distribution = Type II
Shape factor = 484

Hydrograph Volume = 56,371 cuft

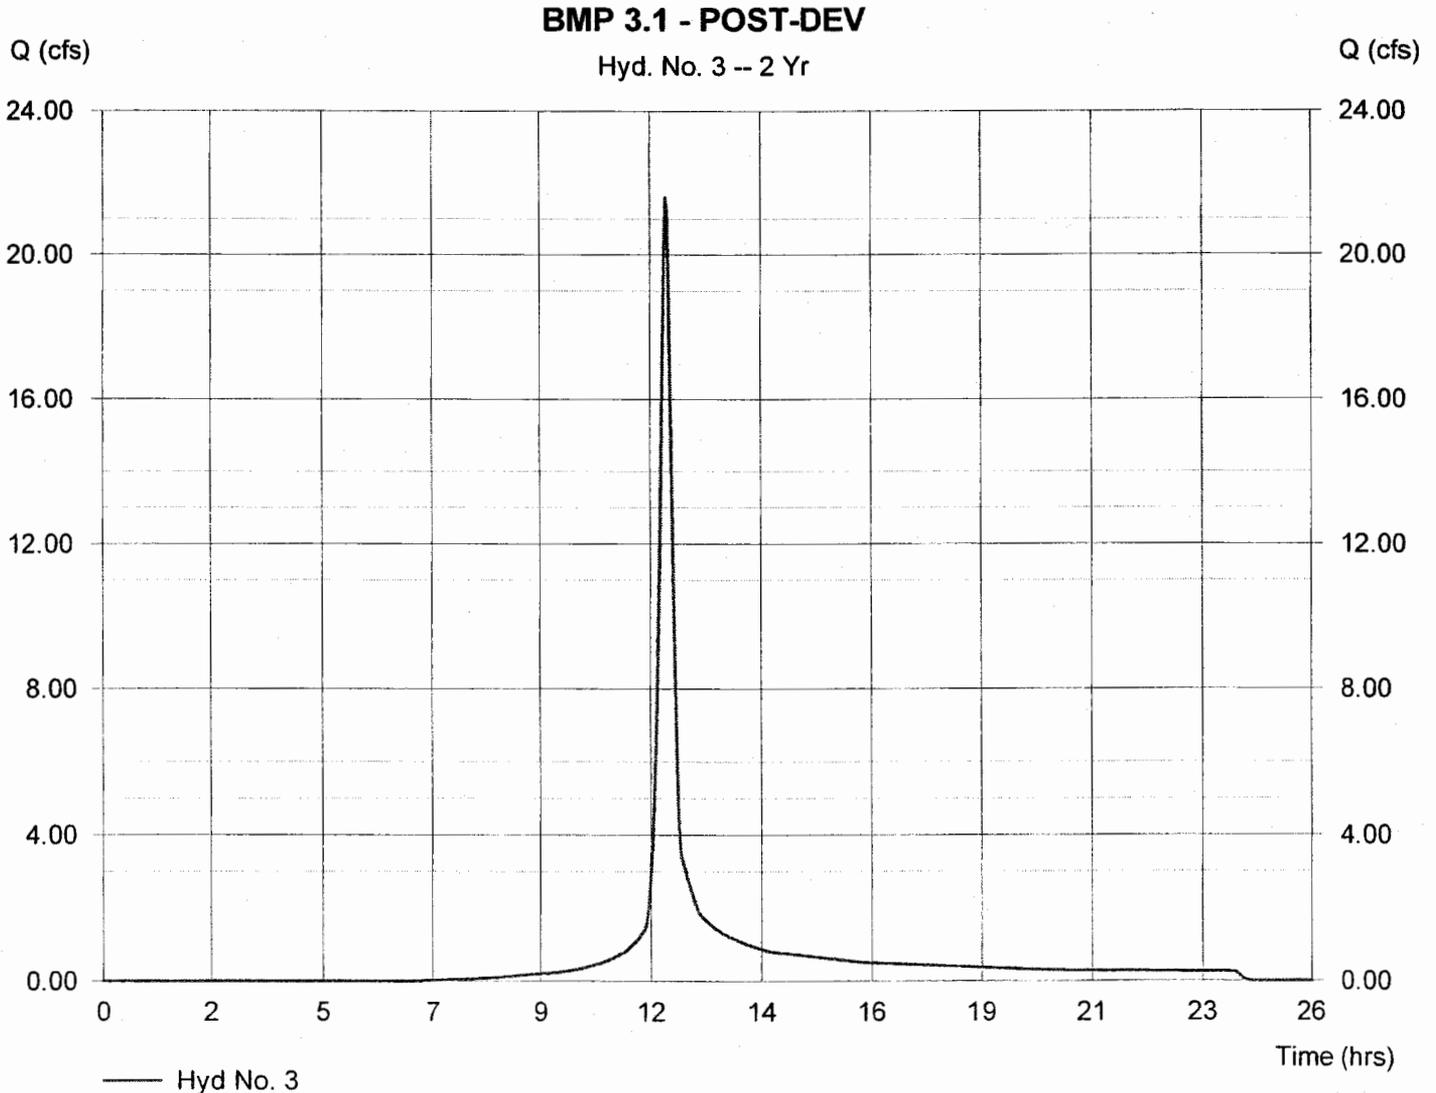

Hydrograph Plot

Hydraflow Hydrographs by Intelisolve

Tuesday, Jun 13 2006, 1:47 PM


Hyd. No. 3

BMP 3.1 - POST-DEV

Hydrograph type = SCS Runoff
Storm frequency = 10 yrs
Drainage area = 6.90 ac
Basin Slope = 8.0 %
Tc method = USER
Total precip. = 4.25 in
Storm duration = 24 hrs

Peak discharge = 28.16 cfs
Time interval = 2 min
Curve number = 87
Hydraulic length = 300 ft
Time of conc. (Tc) = 12 min
Distribution = Type II
Shape factor = 484

Hydrograph Volume = 74,052 cuft

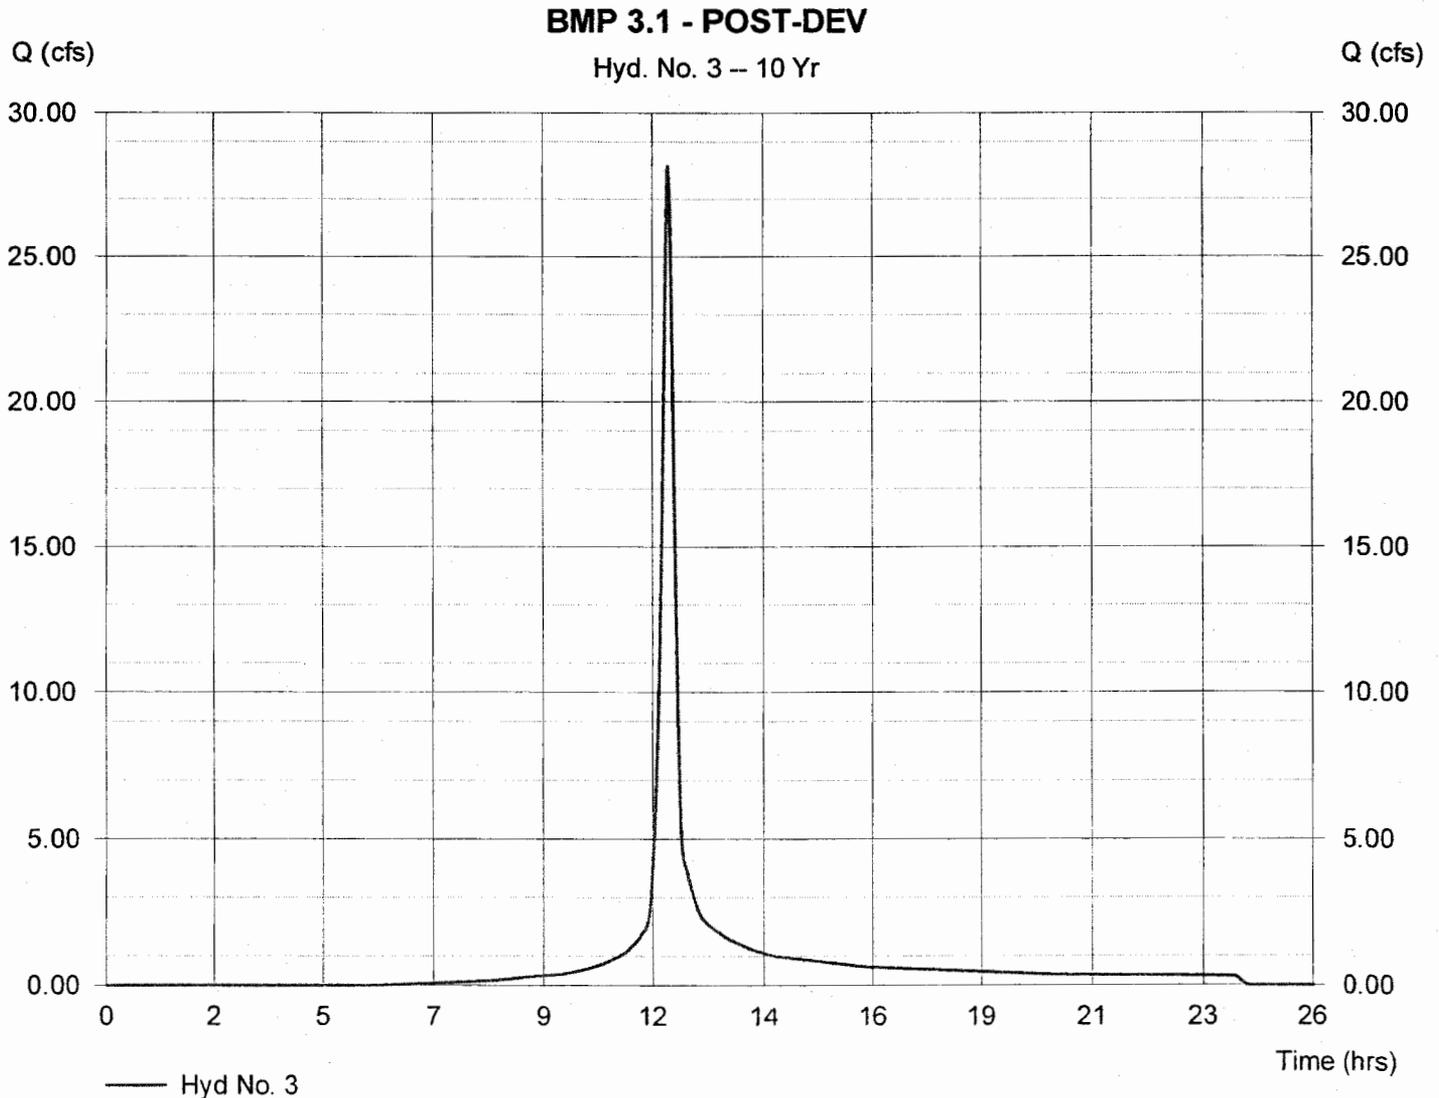

Hydrograph Plot

Hydraflow Hydrographs by Intelisolve

Tuesday, Jun 13 2006, 1:48 PM


Hyd. No. 3

BMP 3.1 - POST-DEV

Hydrograph type = SCS Runoff
Storm frequency = 100 yrs
Drainage area = 6.90 ac
Basin Slope = 8.0 %
Tc method = USER
Total precip. = 7.95 in
Storm duration = 24 hrs

Peak discharge = 60.49 cfs
Time interval = 2 min
Curve number = 87
Hydraulic length = 300 ft
Time of conc. (Tc) = 12 min
Distribution = Type II
Shape factor = 484

Hydrograph Volume = 165,337 cuft

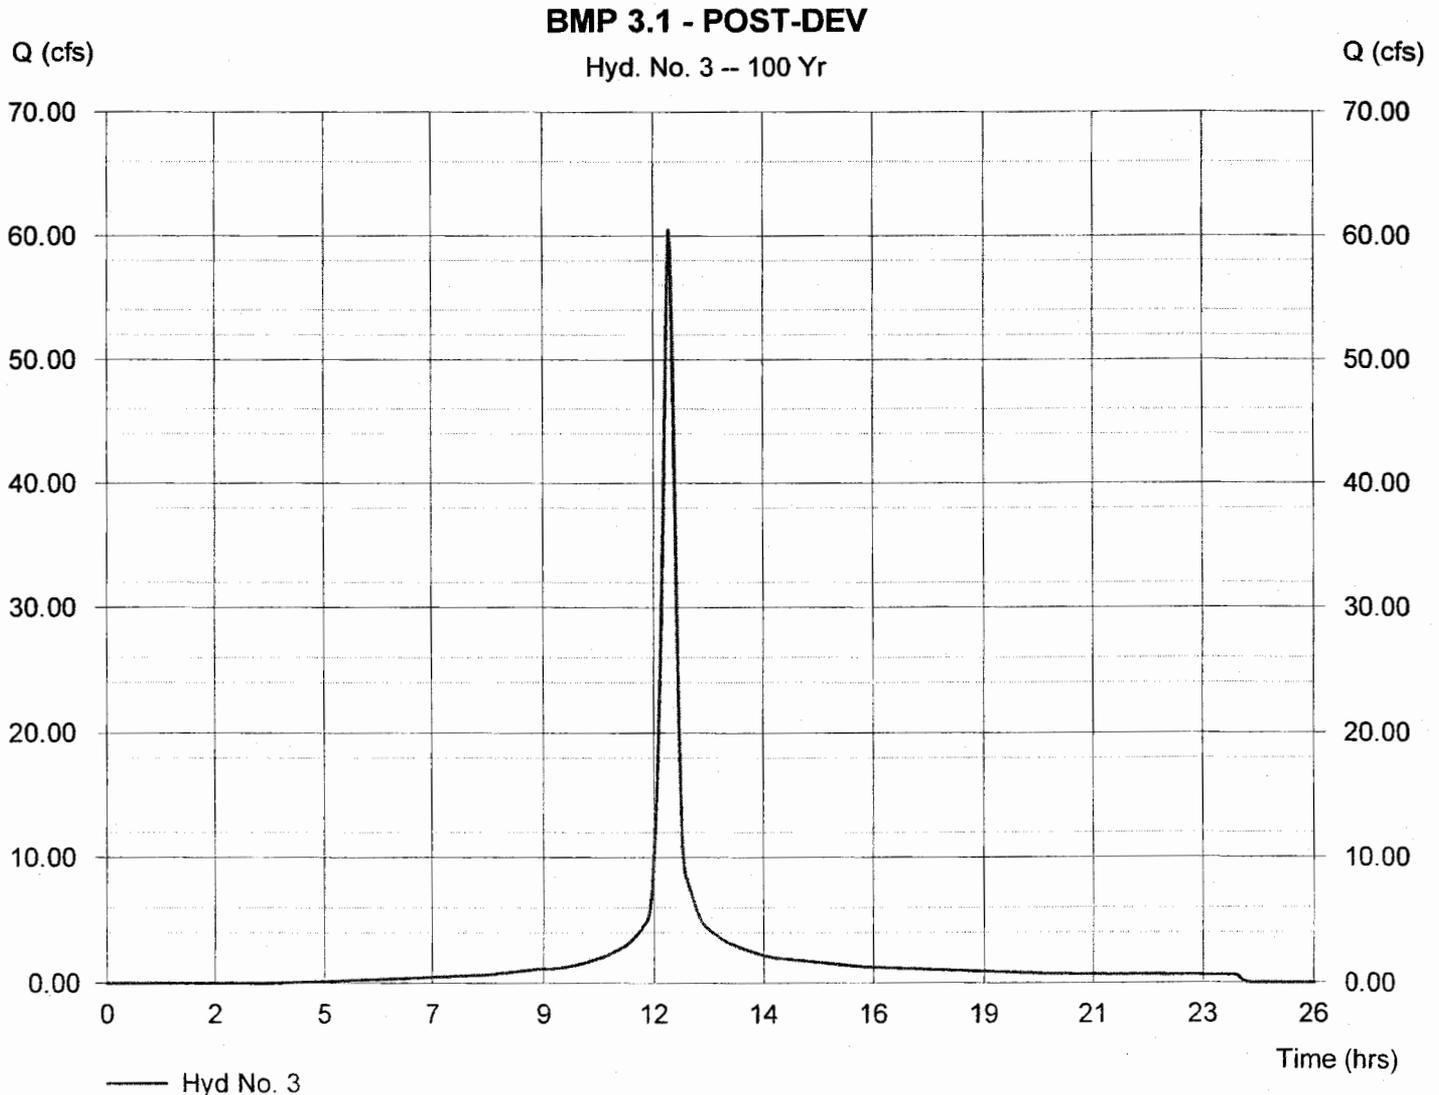

Hydrograph Plot

Hydraflow Hydrographs by Intelisolve

Tuesday, Jun 13 2006, 1:48 PM

Hyd. No. 10


BMP 3.1 POST-DEV. RTD.

Hydrograph type = Reservoir
Storm frequency = 1 yrs
Inflow hyd. No. = 3
Reservoir name = BMP 3.1

Peak discharge = 0.55 cfs
Time interval = 2 min
Max. Elevation = 74.35 ft
Max. Storage = 23,310 cuft

Storage Indication method used.

Hydrograph Volume = 40,442 cuft

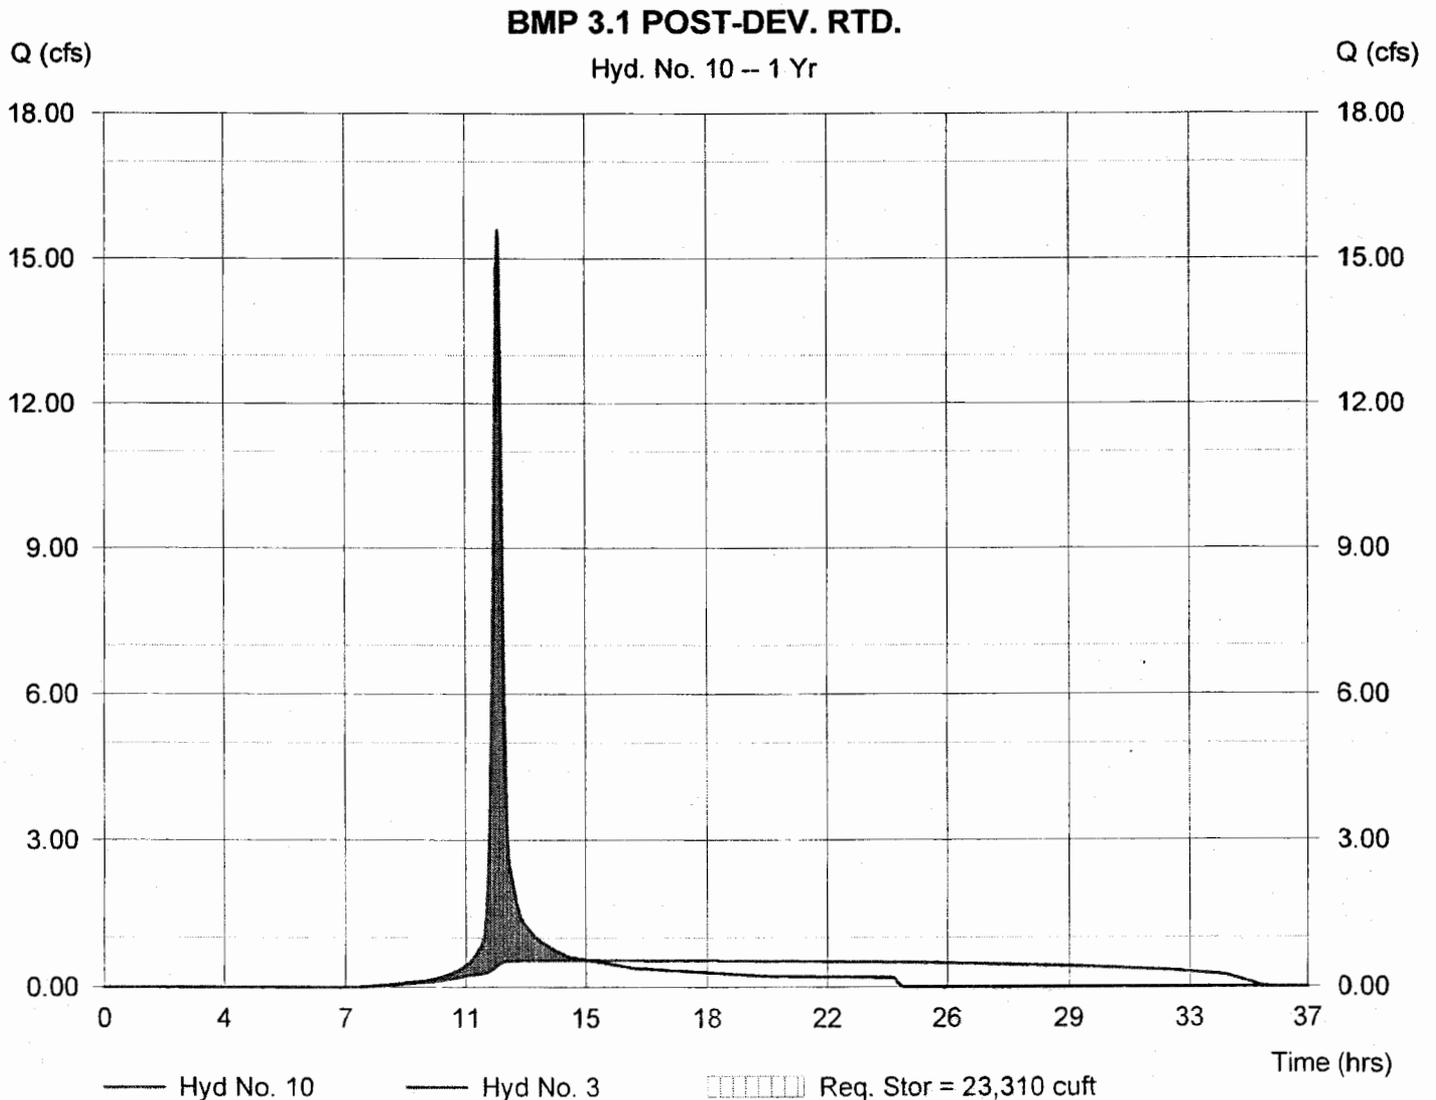

Hydrograph Plot

Hydraflow Hydrographs by Intelisolve

Tuesday, Jun 13 2006, 1:48 PM

Hyd. No. 10


BMP 3.1 POST-DEV. RTD.

Hydrograph type = Reservoir
Storm frequency = 1 yrs
Inflow hyd. No. = 3
Reservoir name = BMP 3.1

Peak discharge = 0.55 cfs
Time interval = 2 min
Max. Elevation = 74.35 ft
Max. Storage = 23,310 cuft

Storage Indication method used.

Hydrograph Volume = 40,442 cuft

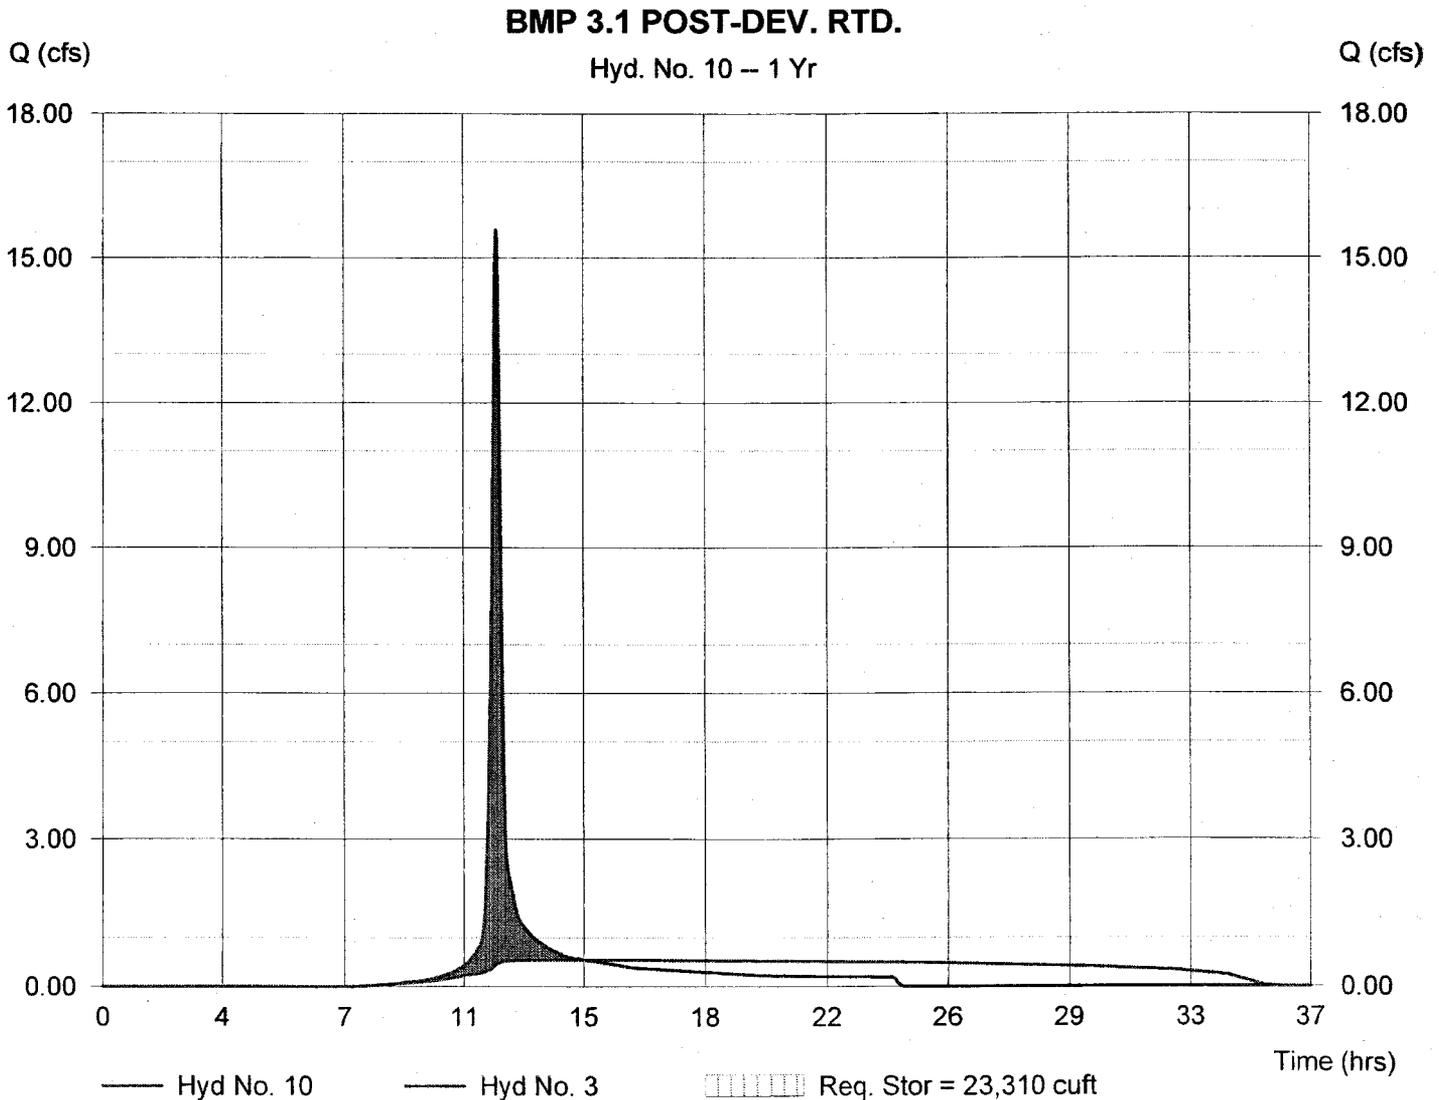

Hydrograph Plot

Hydraflow Hydrographs by Intelisolve

Tuesday, Jun 13 2006, 1:48 PM

Hyd. No. 10


BMP 3.1 POST-DEV. RTD.

Hydrograph type = Reservoir
Storm frequency = 2 yrs
Inflow hyd. No. = 3
Reservoir name = BMP 3.1

Peak discharge = 0.60 cfs
Time interval = 2 min
Max. Elevation = 75.37 ft
Max. Storage = 34,860 cuft

Storage Indication method used.

Hydrograph Volume = 56,371 cuft

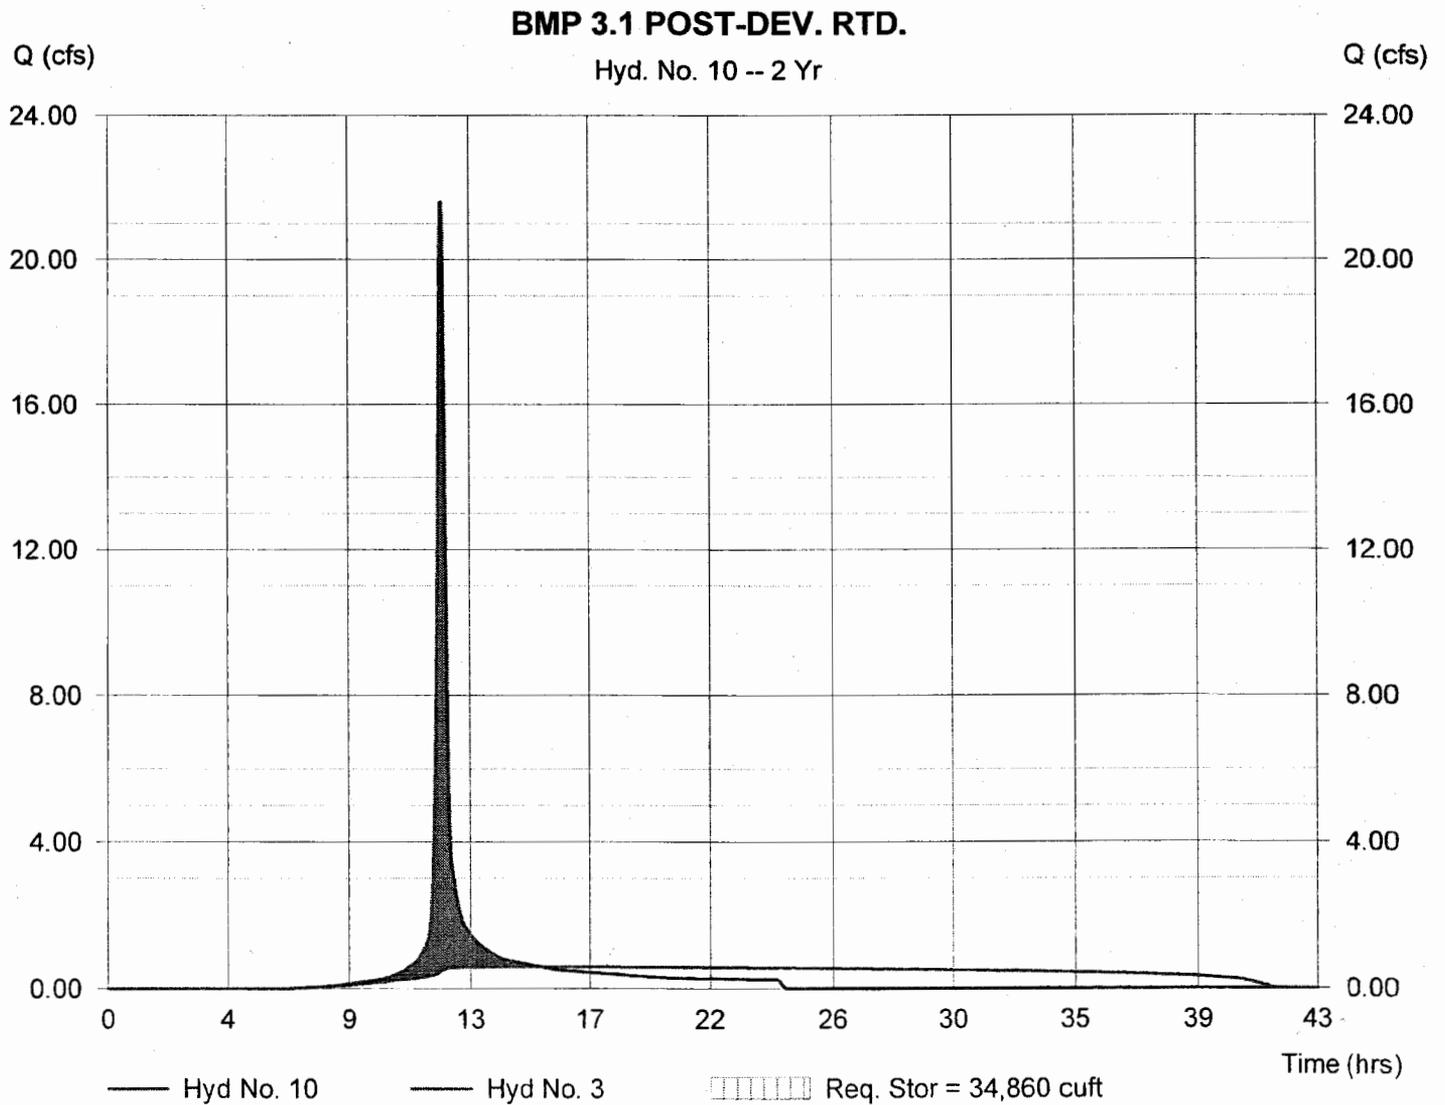

Hydrograph Plot

Hydraflow Hydrographs by Intelisolve

Tuesday, Jun 13 2006, 1:48 PM

Hyd. No. 10


BMP 3.1 POST-DEV. RTD.

Hydrograph type = Reservoir
Storm frequency = 10 yrs
Inflow hyd. No. = 3
Reservoir name = BMP 3.1

Peak discharge = 0.64 cfs
Time interval = 2 min
Max. Elevation = 76.39 ft
Max. Storage = 48,240 cuft

Storage Indication method used.

Hydrograph Volume = 74,051 cuft

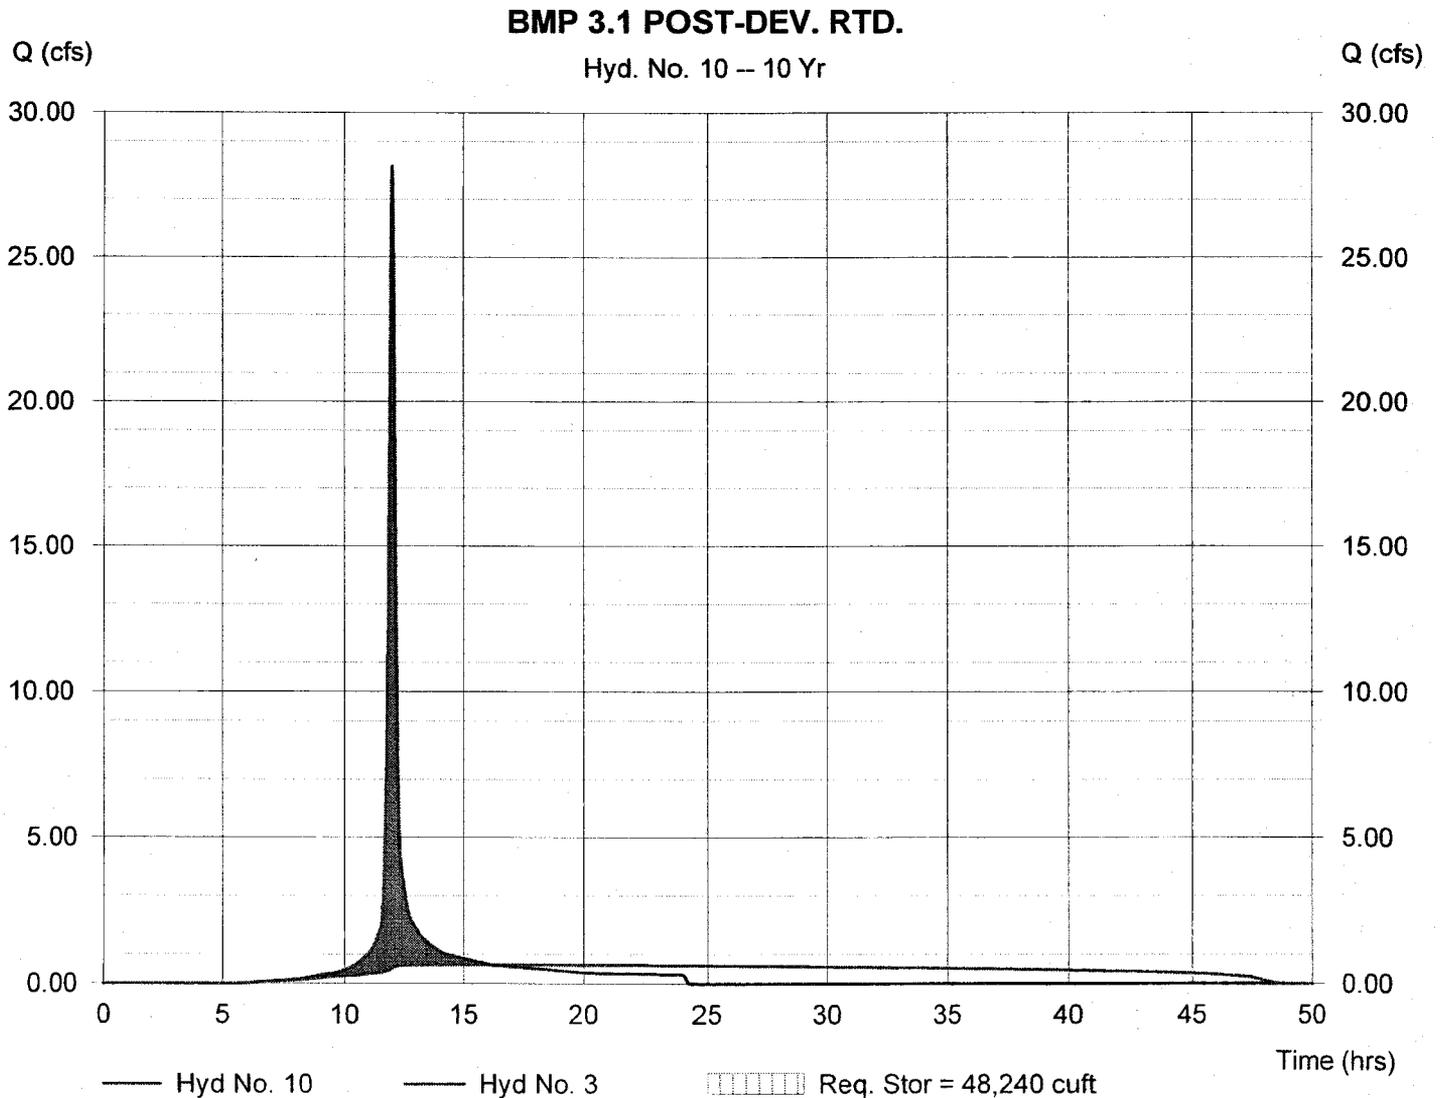

Hydrograph Plot

Hydraflow Hydrographs by Intelisolve

Tuesday, Jun 13 2006, 1:48 PM

Hyd. No. 10


BMP 3.1 POST-DEV. RTD.

Hydrograph type = Reservoir
Storm frequency = 100 yrs
Inflow hyd. No. = 3
Reservoir name = BMP 3.1

Peak discharge = 5.11 cfs
Time interval = 2 min
Max. Elevation = 78.96 ft
Max. Storage = 96,420 cuft

Storage Indication method used.

Hydrograph Volume = 165,336 cuft

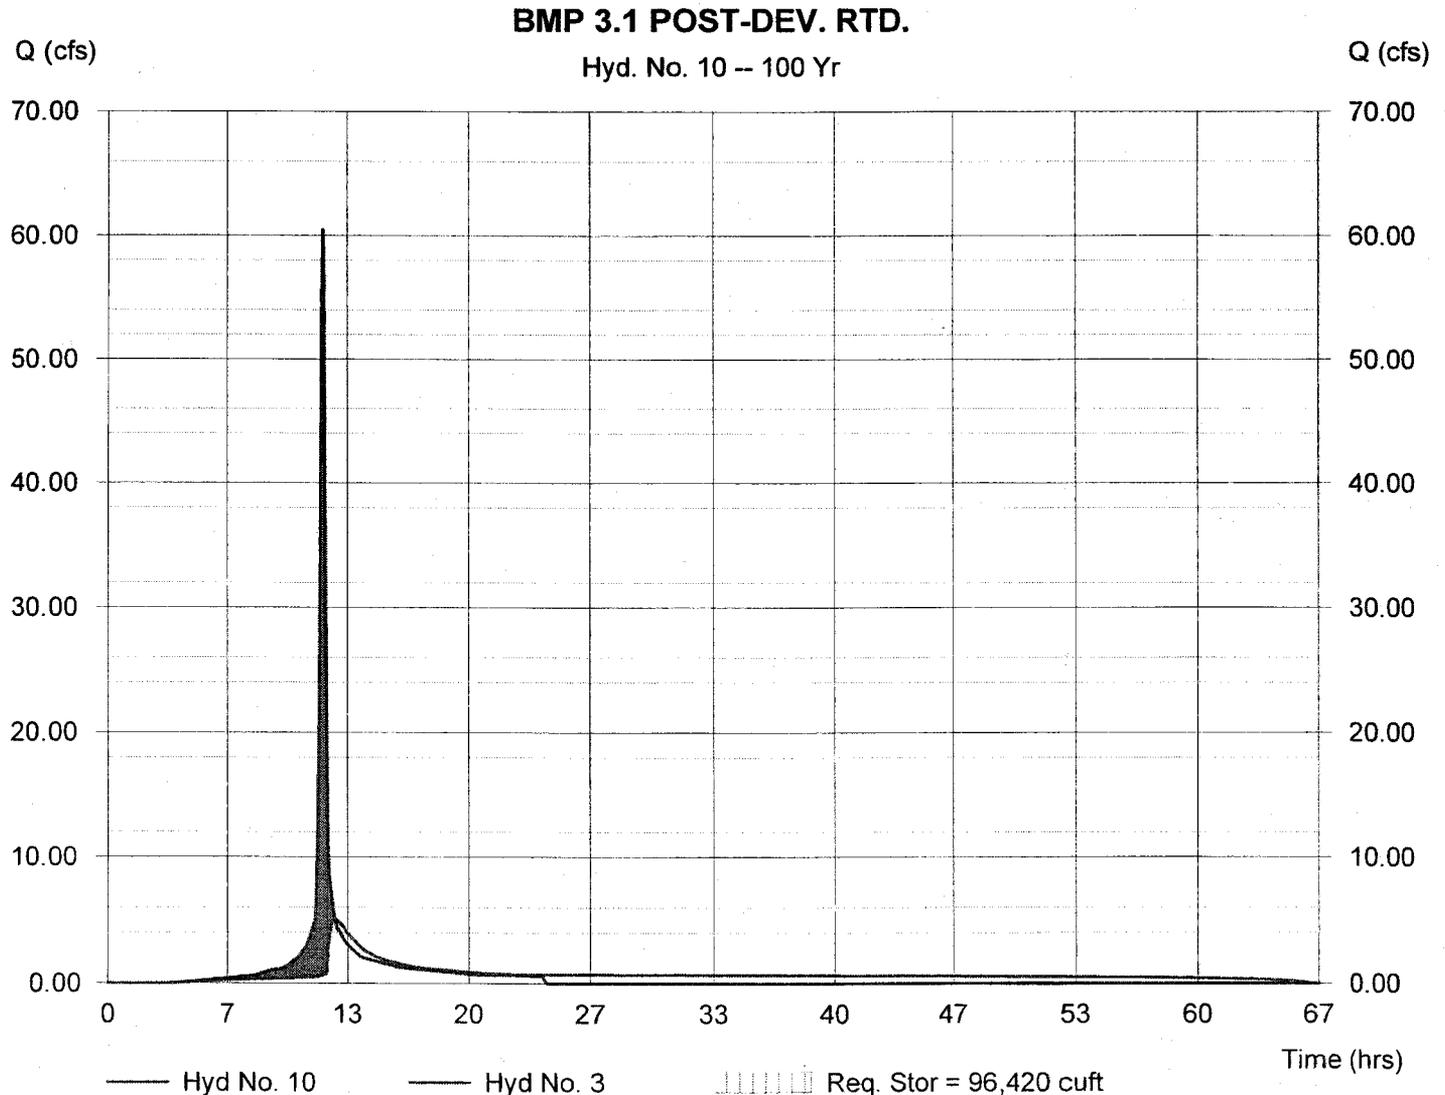



James City County Environmental Division Stormwater Management / BMP Inspection Report Detention and Retention Pond Facilities

County BMP ID Code (if known): YC-030

Name of Facility: COLONIAL HERITAGE DRY POND - P1S3 BMP No.: 2 of 2 Date: 9/13/09

Location: COLONIAL HERITAGE - ADJACENT TO SPRUCEMONT AND SANFORD ARMS DR.

Name of Owner: COLONIAL HERITAGE - LENNAR

Name of Inspector: M. MADDESKI

Type of Facility: DRY POND

Weather Conditions: SUNNY 71° Type: Final Inspection County BMP Inspection Program Owner Inspection

If an inspection item is not applicable, mark NA, otherwise mark the appropriate column.

O.K. - The item checked is in adequate condition and the maintenance program is currently satisfactory. No action required.

Routine - The item checked requires attention, but does not present an immediate threat to the function/integrity of the BMP.

Urgent - The item checked requires immediate attention to keep the BMP operational and to prevent damage to the facility.

Provide an explanation and details in the comment column, if routine or urgent are marked.

| Facility Item | O.K. | Routine | Urgent | Comments |
|--|------|---------|--------|---|
| Embankments and Side Slopes: | | | | |
| Grass Height | ✓ | | | |
| Vegetation Condition | ✓ | | | |
| Tree Growth | ✓ | | | |
| Erosion | | ✓ | | REPAIR MINOR EROSION UPSLOPE OF SEDIMENT FOREBAY ADJACENT TO ARTHUR HILLS DR. |
| Trash & Debris | | ✓ | | |
| Seepage | ✓ | | | |
| Fencing or Benches | | | | |
| Interior Landscaping/Planted Areas: <input type="checkbox"/> None <input type="checkbox"/> Constructed Wetland/Shallow Marsh <input checked="" type="checkbox"/> Naturally Established Vegetation | | | | |
| Vegetated Conditions | ✓ | | | |
| Trash & Debris | | ✓ | | REMOVE DEBRIS FROM SS-12-1 OUTFALL AREA |
| Floating Material | N/A | | | |
| Erosion | ✓ | | | |
| Sediment | ✓ | | | |
| Dead Plant | ✓ | | | |
| Aesthetics | ✓ | | | |
| Other | | | | |
| Notes: | | | | |

| Facility Item | O.K. | Routine | Urgent | Comments |
|--|------|---------|--------|---|
| Water Pools: <input type="checkbox"/> Permanent Pool (Retention Basin) <input type="checkbox"/> Shallow Marsh (Detention Basin) <input checked="" type="checkbox"/> None, Dry (Detention Basin) | | | | |
| Shoreline Erosion | ✓ | | | |
| Algae | ✓ | | | |
| Trash & Debris | | ✓ | | REMOVE DEBRIS FROM SS 12-1-1 OUTFALL AREA |
| Sediment | ✓ | | | |
| Aesthetics | ✓ | | | |
| Other | | | | |
| Inflows (Describe Types/Locations): | | | | |
| Condition of Structure | ✓ | | | |
| Erosion | ✓ | | | |
| Trash and Debris | ✓ | | | |
| Sediment | ✓ | | | |
| Outlet Protection | ✓ | | | |
| Other | | | | |
| Principal Flow Control Structure - Riser, Intake, etc. (Describe Type): | | | | |
| Condition of Structure | ✓ | | | |
| Corrosion | ✓ | | | |
| Trash and Debris | ✓ | | | |
| Sediment | ✓ | | | |
| Vegetation | ✓ | | | |
| Other | ✓ | —————→ | | CHECK LFD IS OPEN |
| Principal Outlet Structure - Barrel, Conduit, etc. : | | | | |
| Condition of Structure | ✓ | | | |
| Settlement | ✓ | | | |
| Trash & Debris | | ✓ | | SEE BELOW |
| Erosion/Sediment | ✓ | | | |
| Outlet Protection | | ✓ | | REMOVE VEGETATION FOR OUTLET PROTECTION AREA |
| Other | | | | |
| Emergency Spillway (Overflow): | | | | |
| Vegetation | ✓ | | | |
| Lining | ✓ | | | |
| Erosion | ✗ | ✓ | | REPAIR EROSION LEFT SIDE OF SPILLWAY + HEAR OUTFALL |
| Trash & Debris | ✓ | | | |
| Other | | | | |
| Notes: | | | | |
| | | | | |

| Facility Item | O.K. | Routine | Urgent | Comments |
|---|------|---------|------------------------|----------|
| Nuisance Type Conditions: | | | | |
| Mosquito Breeding | ✓ | | | |
| Animal Burrows | ✓ | | | |
| Graffiti | ✓ | | | |
| Other | | | | |
| Surrounding Perimeter Conditions: | | | | |
| Land Uses | ✓ | | | |
| Vegetation | ✓ | | | |
| Trash & Debris | ✓ | | | |
| Aesthetics | ✓ | | | |
| Access /Maintenance Roads or Paths | ✓ | | | |
| Other | | | | |
| Remarks: | | | | |
| <p>- MINOR EROSION ISSUES (SEC. FOREBAY, EMERG. SPILLWAY, OTHER AREAS)</p> <p>- OIL NEEDS TO BE CLEANED OUT</p> | | | | |
| Overall Environmental Division Internal Rating: <u>3/5</u> | | | | |
| Signature: <u>M.P. [Signature]</u> | | | Date: <u>9/13/2007</u> | |
| Title: <u>ENV. INSPECTOR</u> | | | | |

SWMProg\BMP\CoInspProg\InspForms\DetRet.wpd

Date Record Created:

WS BMPNO:

Print Form

Created By:

YC030

**PRINTED ON:
Friday, March 12, 2010
4:14:16 PM**

WATERSHED YC
BMP ID NO 030
PLAN NO S-73-02

TAX PARCEL
PIN NO
CONSTRUCTION DATE

PROJECT NAME Colonial Heritage Ph 1 Sec 3/3a

FACILITY LOCATION

CITY-STATE

CURRENT OWNER

OWNER ADDRESS

OWNER ADDRESS 2

CITY-STATE-ZIP CODE

OWNER PHONE

MAINT AGREEMENT No

EMERG ACTION PLAN No

Get Last BMP No

Return to Menu

MAINTENANCE PLAN No

SITE AREA acre

LAND USE

old BMP TYP Dry Pond

JCC BMP CODE F2 Dry ED with forebay

POINT VALUE 4

SVC DRAIN AREA acres 9.1

SERVICE AREA DESCRI

IMPERV AREA acres 0.00

RECV STREAM

EXT DET-WQ-CTRL No

WTR QUAL VOL acre-ft

CHAN PROT CTRL No

CHAN PROT VOL acre-ft

SW/FLOOD CONTROL No

GEOTECH REPORT No

CTRL STRUC DESC

CTRL STRUC SIZE inches

OTLT BARRL DESC

OTLT BARRL SIZE inch

EMERG SPILLWAY No

DESIGN HW ELEV

PERM POOL ELEV

2-YR OUTFLOW cfs 0.00

10-YR OUTFLOW cfs 0.00

REC DRAWING No

CONSTR CERTIF No


LAST INSP DATE Inspected by:

INTERNAL RATING

MISC/COMMENTS

Master plan pond # 12

Additional Comments:

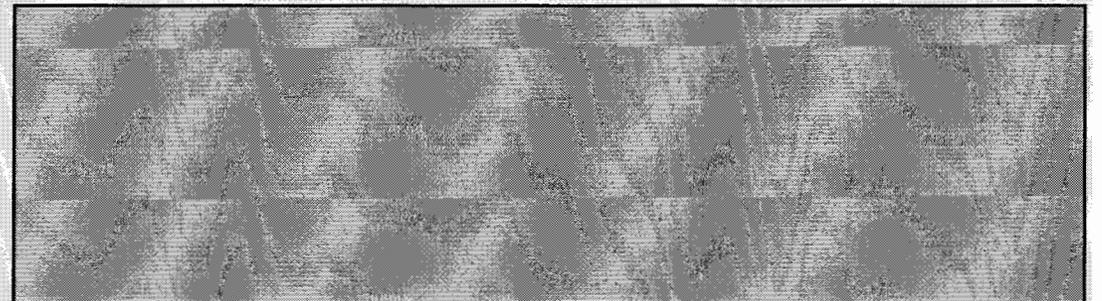

PH 3+3A

S-73-02

YC 030; #12; 3.1

YC 031; #13; 3.2