



CERTIFICATE OF AUTHENTICITY

THIS IS TO CERTIFY THAT THE FOLLOWING ELECTRONIC RECORDS ARE TRUE AND ACCURATE REPRODUCTIONS OF THE ORIGINAL RECORDS OF JAMES CITY COUNTY GENERAL SERVICES DEPARTMENT- STORMWATER DIVISION; WERE SCANNED IN THE REGULAR COURSE OF BUSINESS PURSUANT TO GUIDELINES ESTABLISHED BY THE LIBRARY OF VIRGINIA AND ARCHIVES; AND HAVE BEEN VERIFIED IN THE CUSTODY OF THE INDIVIDUAL LISTED BELOW.

BMP NUMBER: 66016

DATE VERIFIED: January 17, 2023

QUALITY ASSURANCE TECHNICIAN: Audrey Ramey

LOCATION: WILLIAMSBURG, VIRGINIA

1. Maintenance Agreement

2. Deeds/Easements/ Agreements/Property Records

MEMORANDUM

DATE: December 09, 2008

TO: Terri Salnoske, JCSA Customer Services
Laurie Fuith, Post Office (Monticello Branch)
Planning Dept.
Tal Luton, Fire Dept.
Emmett Harmon, Police Dept.
Randall Pingley, School Transportation
Jane Townsend, Satellite Services
Doug Murrow, Code Compliance
Alan Cole, Sr, Voter Registration
Kim Carter, Environmental Health
Jennifer Privette, Recycling
Mitzi Holley, JCSA
Charlie Hardy, Cox Communications
Yong Lee, Virginia Power
Fred Pleasants, Verizon
Susan Daniel, Virginia Natural Gas

FROM: M. Melinda Sikora, Real Estate Information Specialist 

SUBJECT: Final Addresses and Parcel Identification Numbers for
**WHITE HALL, S-2 P-A LOTS 222, 224,
COMMON AREA, ROW & FUTURE
DEVELOPMENT. (S-0098-06)**

This information is available at Real Estate Assessments Division and the Planning Office.

	<u>Parcel ID #</u>	<u>Address</u>
222	1220900222	3309 Hickory Neck Blvd
224	1220900224	3312 Hickory Neck Blvd

Common Area	1220900001B	3290 Hickory Neck Blvd
ROW-Private	1220900001C	
Future Develop.	1220100014A	
		Toano VA 23168

Deleted Parcel(s):

Out of Parcel(s) 1220100014A
/Parent Parcel(s):

Notes:


MMS/jrs

3. Construction Certificate

4. Record Drawing (as-built plan)

5. Construction Drawings

TRANSMITTAL

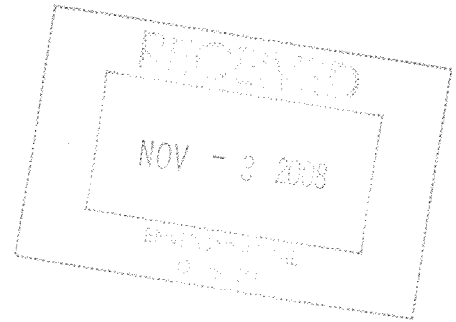

DATE: October 31, 2008

TO:

JCSA
~~Environmental~~
County Engineer
Fire
VDOT
Health Department

FROM: Luke Vinciguerra, Planner

SUBJECT: SP-144-2006/ S-98-2006, White Hall Sec 2 (again)
ITEMS

ATTACHED: Construction drawings

ACTION: Applicant is proposing changes to lot widths (read blurb on front page) to the approved White Hall site plan. Please review and return comments in two weeks.

Plan amendment is approved by the Environmental Division. Work under this amendment is covered under existing Land-Disturbing Permit #08-43 as issued under S-98-06/SP-144-06. Applicable proffers and Chesapeake Bay Exceptions apply.

Scott J. Thorne
11-26-08

ALLEY RECORD DRAWINGS

FOR SECTION 2

GENERAL NOTES


Engineering & Resource Protection
NOV 9 2016
RECEIVED

INDEX OF SHEETS

SHEET NUMBER	DESCRIPTION
1.	COVER SHEET
2.	ENVIRONMENTAL INVENTORY
3.	OVERALL PLAN OF DEVELOPMENT
4.	PRELIMINARY PLAT
5.	PRELIMINARY PLAT
6.	PRELIMINARY PLAT
7.	PRELIMINARY PLAT
8.	PRELIMINARY PLAT
9.	PRELIMINARY PLAT
10.	ROAD AND UTILITY PLAN
11.	ROAD AND UTILITY PLAN
12.	ROAD AND UTILITY PLAN
13.	ROAD AND UTILITY PLAN
14.	ROAD AND UTILITY PLAN
15.	ROAD AND UTILITY PLAN
16.	PHASE I EROSION AND SEDIMENT CONTROL PLAN
17.	OVERALL BMP DRAINAGE PLAN
18.	OVERALL DRAINAGE PLAN
19.	GRADING, DRAINAGE, EROSION AND SEDIMENT CONTROL PLAN
20.	GRADING, DRAINAGE, EROSION AND SEDIMENT CONTROL PLAN
21.	GRADING, DRAINAGE, EROSION AND SEDIMENT CONTROL PLAN
22.	GRADING, DRAINAGE, EROSION AND SEDIMENT CONTROL PLAN
23.	GRADING, DRAINAGE, EROSION AND SEDIMENT CONTROL PLAN
24.	GRADING, DRAINAGE, EROSION AND SEDIMENT CONTROL PLAN
25.	ROAD AND UTILITY PROFILES
26.	ROAD AND UTILITY PROFILES
27.	ROAD AND UTILITY PROFILES
28.	ROAD AND UTILITY PROFILES
29.	ROAD AND UTILITY PROFILES
30.	ROAD AND UTILITY PROFILES AND OFFSITE SANITARY SEWER PROFILE
31.	ROAD AND UTILITY PROFILES
32.	ROAD AND UTILITY PROFILES
33.	ROAD AND UTILITY PROFILES
34.	NOTES AND DETAILS
35.	NOTES AND DETAILS
35A.	NOTES AND DETAILS
36.	BMP PLAN, NOTES AND DETAILS
37.	BMP SECTIONS
38.	EROSION AND SEDIMENT CONTROL NOTES AND DETAILS
39.	LID STORM SEWER DETAILS
L100.	LANDSCAPE PLAN
L101.	LANDSCAPE PLAN
L102.	LANDSCAPE PLAN
L103.	LANDSCAPE PLAN
L104.	LANDSCAPE PLAN
L105.	LANDSCAPE PLAN
L106.	LANDSCAPE PLAN
L107.	LANDSCAPE PLAN
L108.	LANDSCAPE PLAN
L109.	LANDSCAPE PLAN
L110.	LANDSCAPE PLAN
L111.	ENTRY SIGN DETAILS

White Hall
JAMES CITY COUNTY

STONEHOUSE DISTRICT JAMES CITY COUNTY, VIRGINIA

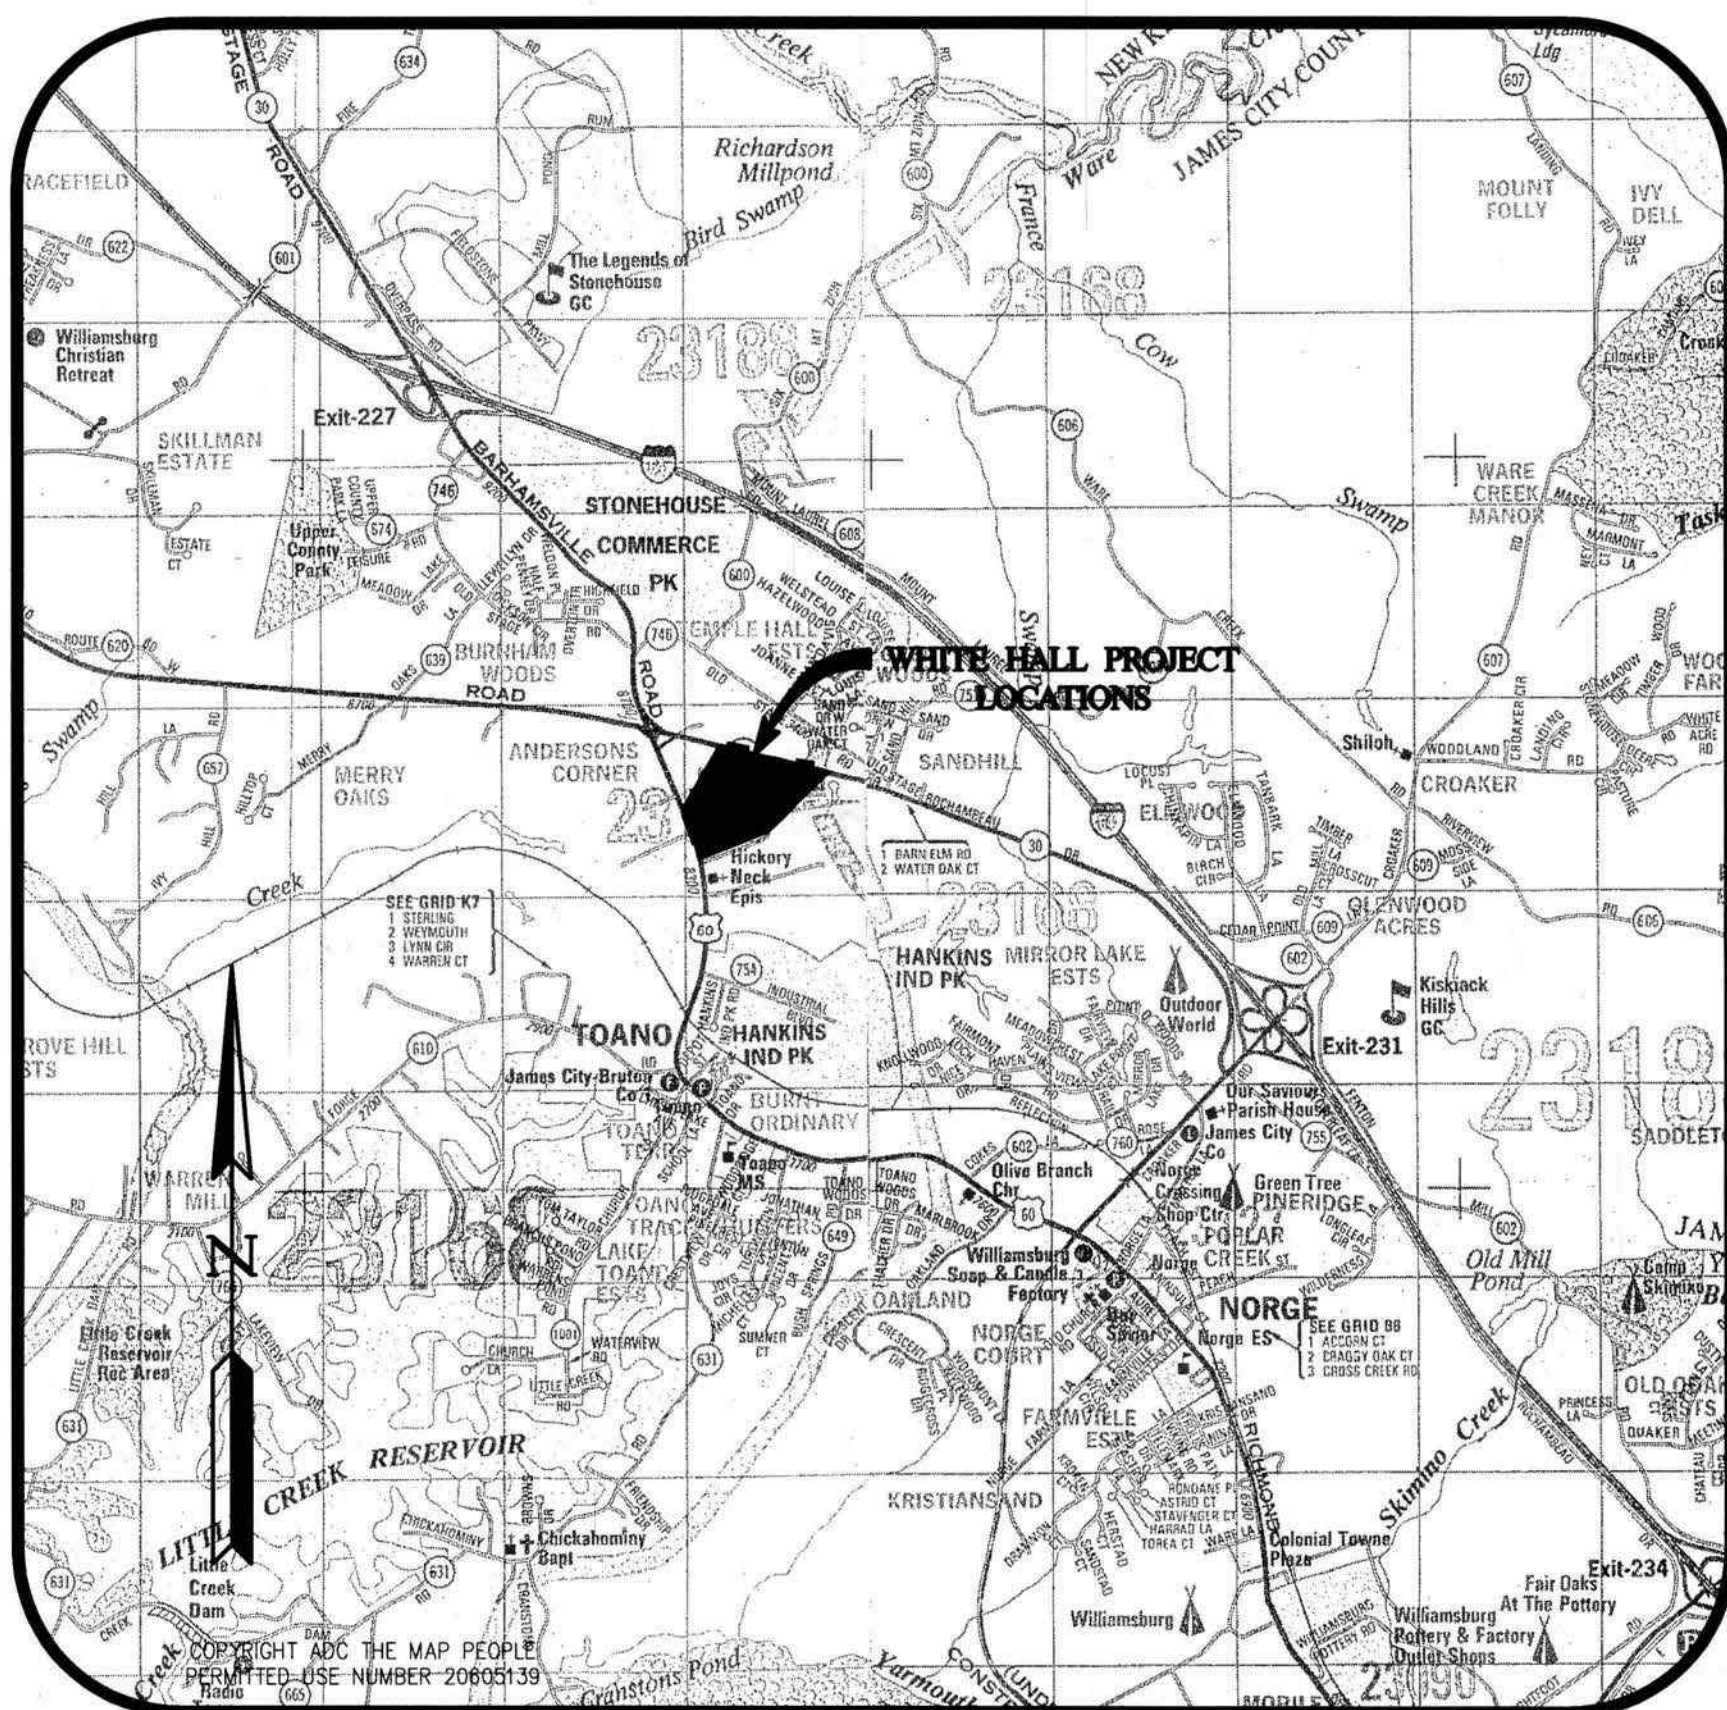


VICINITY MAP (APPROX. SCALE 1"=2000')

NOVEMBER 29, 2006

AES PROJECT NO.: 9048-11

JCC #SP-144-06/S-98-06

THIS PROJECT IS SUBJECT TO THE PROVISIONS OF
CHESAPEAKE BAY EXCEPTION CBE 06-078 AND
OTHERS AS MAY APPLY TO THE OVERALL PROJECT.

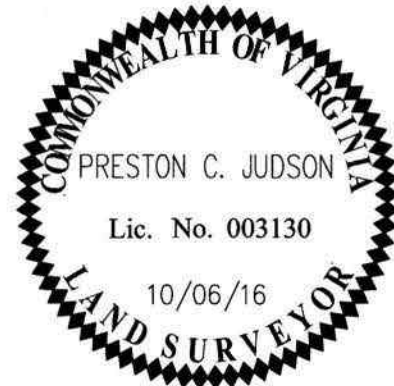

AES
CONSULTING ENGINEERS

Hampton Roads | Central Virginia | Middle Peninsula

5248 Olde Towne Road, Suite 1
Williamsburg, Virginia 23188
Phone: (757) 253-0040
Fax: (757) 220-8994

www.aesva.com

1. ZONING IS R2, GENERAL RESIDENTIAL DISTRICT, CLUSTER OVERLAY WITH PROFFERS, CASE # Z-11-05/SUP-18-05/MP-08-05, APPROVED SEPTEMBER 13, 2005.

THE MASTER PLAN WAS REVISED AUGUST 10, 2006.

2. CONTOUR INTERVAL IS 1 FOOT.

3. CONTRACTOR SHALL BE REQUIRED TO REGISTER FOR A VIRGINIA STORMWATER MANAGEMENT PROGRAM (VSMP) PERMIT.

4. HORIZONTAL DATUM - NAD83 (1192) VIRGINIA STATE PLAIN COORDINATE SYSTEM SOUTH ZONE
VERTICAL DATUM - NGVD29 VIRGINIA STATE PLAIN COORDINATE SYSTEM SOUTH ZONE
JAMES CITY COUNTY MONUMENTS USED - 302, 303, 305, 340

5. ALL UTILITY AND SURVEY DATA SHOWN ON THE DRAWINGS HAVE BEEN PROVIDED BY AES CONSULTING ENGINEERS. INFORMATION HAS BEEN OBTAINED FROM THE BEST AVAILABLE SOURCES AT THE TIME OF THE SURVEY BUT IS NOT REPRESENTED AS BEING COMPLETE AND ACCURATE. IT IS THE CONTRACTOR'S RESPONSIBILITY TO LOCATE AND PROTECT EXISTING UTILITIES AND UNDERGROUND STRUCTURES. DAMAGE TO EXISTING UTILITIES AND UNDERGROUND STRUCTURES SHALL BE REPAIRED BY THE CONTRACTOR AT NO ADDITIONAL COST TO THE DEVELOPER.

6. ALL PROPOSED UTILITIES SHALL BE PLACED UNDERGROUND AS PER JAMES CITY COUNTY SUBDIVISION ORDINANCE SECTION 19-33.

7. CONTACT MISS UTILITY (1-800-552-7001) FOR EXISTING UTILITY LOCATIONS 48 HOURS PRIOR TO COMMENCING THE WORK.

8. EXISTING UTILITY LOCATIONS INDICATED ARE APPROXIMATE. FIELD VERIFY PRIOR TO COMMENCING THE WORK.

9. VERIFY ALL DIMENSIONS AND NOTIFY JAMES CITY SERVICE AUTHORITY PRIOR TO ANY EXCAVATION OR DEMOLITION WITHIN UTILITY CORRIDORS.

10. THE CONTRACTOR IS REQUIRED TO SECURE ALL NECESSARY PERMITS FOR THE ABANDONMENT OR DEMOLITION OF ALL EXISTING WELLS/WATERLINES AND SEPTIC FIELDS IN ACCORDANCE WITH JAMES CITY COUNTY AND VIRGINIA DEPARTMENT OF HEALTH REGULATIONS. CONTACT VIRGINIA DEPARTMENT OF HEALTH AT 1-757-253-4813.

11. ALL NEW PROPERTY MONUMENTS SHALL BE SET IN ACCORDANCE WITH SECTIONS 19-34 THROUGH 19-36 OF THE JAMES CITY COUNTY SUBDIVISION ORDINANCE.

12. NO BUILDING OR STRUCTURE CAN EXCEED A MEAN HEIGHT OF 35' WITHOUT A HEIGHT WAIVER FROM JAMES CITY COUNTY.

13. IN ACCORDANCE WITH SECTION 19-29(H) OF THE JAMES CITY COUNTY SUBDIVISION ORDINANCE, THE NATURAL OPEN SPACE EASEMENTS SHALL REMAIN IN A NATURAL UNDISTURBED STATE EXCEPT FOR THOSE ACTIVITIES REFERENCED IN THE DEED OF EASEMENT.

14. IN ACCORDANCE WITH SECTION 19-29(C) OF THE JAMES CITY COUNTY SUBDIVISION ORDINANCE, WETLANDS AND LAND WITHIN RESOURCE PROTECTION AREAS SHALL REMAIN IN A NATURAL UNDISTURBED STATE EXCEPT FOR THOSE ACTIVITIES PERMITTED BY SECTION 23-7(C)(1) OF THE JAMES CITY COUNTY CODE.

15. THE CONTRACTOR SHALL SATISFY HIMSELF AS TO ALL SITE CONDITIONS PRIOR TO CONSTRUCTION.

16. A LAND DISTURBING PERMIT AND SITUATION AGREEMENT, WITH SURETY ARE REQUIRED FOR THIS PROJECT.

17. CONTRACTOR SHALL BE RESPONSIBLE FOR ESTABLISHING AND MAINTAINING ALL LINES AND GRADES REQUIRED.

18. THE CONTRACTOR IS RESPONSIBLE FOR OBTAINING ALL NECESSARY PERMITS PRIOR TO COMMENCEMENT OF WORK TO INCLUDE, BUT NOT LIMITED TO, JAMES CITY COUNTY LAND DISTURBANCE AND VDOT CE-7.

19. A PRECONSTRUCTION CONFERENCE SHALL BE HELD ON-SITE BETWEEN THE COUNTY, THE PROJECT ENGINEERS AND THE CONTRACTOR PRIOR TO ISSUANCE OF A LAND DISTURBING PERMIT.

20. CONTRACTOR SHALL BE RESPONSIBLE FOR THE COORDINATION OF CONSTRUCTION EFFORTS WITH VIRGINIA NATURAL GAS, DOMINION VIRGINIA POWER, VERIZON TELEPHONE, HAMPTON ROADS SANITATION DISTRICT, APPROPRIATE TELEVISION CABLE COMPANY, AND OTHERS THAT MAY BE REQUIRED.

21. CONTRACTOR SHALL BE RESPONSIBLE FOR OBTAINING ALL NECESSARY PERMITS FOR THE WORK INDICATED.

22. THE CONTRACTOR SHALL REESTABLISH ALL PROPERTY PINS, MONUMENTS, WATER METERS, DRAINAGE CULVERTS, FENCES, UTILITY POLES, DRIVEWAYS, CURBS, GUTTERS, ETC. DISTURBED DURING CONSTRUCTION AT NO ADDITIONAL COST TO THE DEVELOPER.

23. THE CONTRACTOR SHALL COMPLY WITH ALL PROVISIONS OF THE VIRGINIA UNDERGROUND UTILITY DAMAGE PREVENTION ACT (SECTION 56-265.14 ET. SEQ. CODE OF VIRGINIA, 1950, AS AMENDED) AND HEREBY AGREES TO HOLD THE DEVELOPER AND THE ENGINEER HARMLESS AGAINST ANY LOSS, DAMAGE, OR CLAIMS OF ANY NATURE WHATSOEVER ARISING OUT OF THE CONTRACTOR'S FAILURE TO COMPLY WITH THE REQUIREMENTS OF SAID ACT.

24. THE CONTRACTOR IS REQUIRED TO COMPLY WITH THE VIRGINIA OVERHEAD HIGH VOLTAGE LINE SAFETY ACT (SECTIONS 59.1-406 THROUGH 59.1-414, CODE OF VIRGINIA, 1950, AS AMENDED). THE CONTRACTOR IS REQUIRED TO VISIT THE SITE AND NOTE THE POSITION OF OVERHEAD CABLES PRIOR TO CONSTRUCTION.

25. THE CONTRACTOR SHALL BE RESPONSIBLE FOR INSTALLING AND MAINTAINING EROSION AND SEDIMENT CONTROL MEASURES AS SHOWN ON THE DRAWINGS AND FOR EXCAVATION STOCKPILES, STAGING AREAS, MOBILIZATION SITES, BEDDING/BACKFILL STOCKPILES AND OTHER LAND DISTURBANCES NOT SPECIFICALLY ADDRESSED IN THE DRAWINGS OR CONTRACT DOCUMENTS. EROSION AND SEDIMENT CONTROL MEASURES SHALL MEET OR EXCEED THE MINIMUM STANDARDS OF THE "VIRGINIA EROSION AND SEDIMENT CONTROL HANDBOOK" (LATEST PUBLICATION) AND THE REQUIREMENTS OF THE LOCAL GOVERNING AUTHORITY.

26. THE ABSENCE OF THE DEVELOPER OR THE ENGINEER AT THE JOB SITE DOES NOT, IN ANY WAY, RELIEVE THE CONTRACTOR OF THE RESPONSIBILITY TO PERFORM THE WORK IN ACCORDANCE WITH THE DRAWINGS, CONTRACT DOCUMENTS, ADDENDA, AND WRITTEN AUTHORIZED PLAN REVISIONS.

27. THE CONTRACTOR SHALL COMPLY WITH ALL APPLICABLE LAWS, ORDINANCES, RULES, REGULATIONS, AND ORDERS OF ANY BODY HAVING JURISDICTION. THE CONTRACTOR SHALL ERECT AND MAINTAIN, AS REQUIRED BY THE CONDITIONS AND PROGRESS OF THE WORK, ALL NECESSARY SAFEGUARDS FOR SAFETY AND PROTECTION.

28. THE CONTRACTOR IS REQUIRED TO SECURE ANY DEMOLITION PERMITS FOR EXISTING STRUCTURES INDICATED ON THE PLAN. CONTACT CODE COMPLIANCE AT 1-757-253-6626.

29. BUILDING SETBACKS REQUIREMENTS SHOWN ON THE PRELIMINARY PLAT AREA ESTABLISHED BY HHUNT COMMUNITIES WITHIN R-2 CLUSTER, OVERLAY WITH PROFFERS.

30. JCSA SHALL BE GRANTED ACCESS EASEMENTS TO WATER AND SEWER LOCATED OUTSIDE OF PUBLIC RIGHT-OF-WAYS.

31. ALL COMPONENTS OF THE WATER DISTRIBUTION AND SANITARY SEWER SYSTEM SHALL BE INSTALLED AND TESTED IN ACCORDANCE WITH THE LATEST EDITION OF THE JAMES CITY SERVICE AUTHORITY DESIGN AND ACCEPTANCE CRITERIA FOR WATER DISTRIBUTION AND SANITARY SEWER SYSTEMS, THE HRPDC REGIONAL STANDARDS, AND THE COMMONWEALTH OF VIRGINIA WATERWORKS AND SEWERAGE REGULATIONS.

32. THE CONTRACTOR SHALL USE ONLY NEW MATERIALS, PARTS AND PRODUCTS ON ALL PROJECTS. ALL MATERIALS SHALL BE STORED SO AS TO ASSURE THE PRESERVATION OF THEIR QUALITY AND FITNESS FOR THE WORK. A COPY OF THE JCSA STANDARDS AND REGIONAL STANDARDS MUST BE KEPT ON-SITE BY THE CONTRACTOR DURING THE FULL TIME OF INSTALLING, TESTING, AND CONVEYING THE FACILITIES TO JCSA.

33. IN ACCORDANCE WITH THE MASTER PLAN, EACH PROPERTY WILL BE SERVED BY GRAVITY SEWER. ANY PROPERTY WITH A BASEMENT WILL BE ALLOWED TO HAVE A PRIVATE SUMP PUMP TO BE PURCHASED AND MAINTAINED AT THE HOMEOWNER'S EXPENSE. JCSA SHALL NOT BE HELD LIABLE FOR ANY MAINTENANCE ON THESE PUMPS NOR REQUIRED TO PROVIDE A MAINTENANCE AGREEMENT FOR MAINTENANCE OF THESE PRIVATE SUMP PUMPS.

34. JCSA WILL ALLOW ANY WATER AND SEWER SERVICE CONNECTIONS CONSTRUCTED WITHIN THE P.U.E. TO BE CONSTRUCTED WITH THE STIPULATION THAT PRESSURE TESTING OF THE SYSTEM WILL NOT BE PERFORMED UNTIL ALL UTILITIES HAVE BEEN INSTALLED. ANY WATER OR SEWER LINES CUT DURING INSTALLATION OF OTHER UTILITIES SHALL BE REPAIRED AT THE CONTRACTOR'S EXPENSE PRIOR TO JCSA ACCEPTANCE.

35. STORM STRUCTURES, SEWER AND BEDDING SHALL CONFORM TO THE VDOT ROAD AND BRIDGE STANDARDS AND VDOT SPECIFICATIONS. ALL PIPE BEDDING SHALL BE IN ACCORDANCE WITH PB-1 AND MANUFACTURER SPECS. AND GUIDELINES. AND STORM SEWER MANHOLES DEEPER THAN 4 FEET SHALL HAVE STEPS (ST-1). ALL STORM PIPE WITHIN VDOT R.O.W. SHALL BE REINFORCED CONCRETE PIPE (RCP) AND SHALL BE CLASS III UNLESS OTHERWISE NOTED. STORM PIPE OUTSIDE OF VDOT R.O.W. CAN BE HIGH DENSITY POLYETHYLENE (HDPE). UNLESS OTHERWISE NOTED ALL DI-2 STRUCTURES TO USE TYPE A NOSE. VDOT STANDARD IS-1 SHAPING TO BE USED IN ALL STORM STRUCTURES.

36. STORM SEWER PIPE SHALL BE CLASS III REINFORCED CONCRETE PIPE UNLESS OTHERWISE DESIGNATED.

37. CONSTRUCTION OF STORMWATER CONVEYANCE SYSTEMS WITHIN THIS DEVELOPMENT OUTSIDE OF THE VDOT RIGHT-OF-WAY SHALL COMPLY WITH THE CURRENT JAMES CITY COUNTY ENVIRONMENTAL DIVISION STORMWATER DRAINAGE CONVEYANCE SYSTEMS, GENERAL DESIGN AND CONSTRUCTION GUIDELINES HANDBOOK.

38. UNLESS OTHERWISE NOTED, ALL DRAINAGE EASEMENTS SHALL REMAIN PRIVATE.

39. VDOT DOES NOT ASSUME RESPONSIBILITY FOR MAINTENANCE OF THE BMPs OR THEIR STRUCTURES AND SHALL BE SAVED HARMLESS FROM ANY DAMAGES, RIGHT-OF-WAYS IDENTIFIED ON THIS PLAN AS "PRIVATE" SHALL NOT BE MAINTAINED BY VDOT OR JAMES CITY COUNTY AND MAY NOT MEET VDOT GEOMETRIC DESIGN STANDARDS.

40. THE PROFESSIONAL WHOSE SEAL IS AFFIXED HEREON SHALL ACT AS THE "RESPONSIBLE LAND DISTURBER" FOR PURPOSES OF PLAN APPROVAL ONLY. PRIOR TO ISSUANCE OF THE LAND DISTURBING PERMIT, THE DEVELOPER OR CONTRACTOR SHALL PROVIDE THE NAME OF A "RESPONSIBLE LAND DISTURBER" WHO SHALL ASSUME RESPONSIBILITY AS THE "RESPONSIBLE LAND DISTURBER" FOR THE CONSTRUCTION PHASE OF THE PROJECT. THE DEVELOPER OR CONTRACTOR SHALL PROVIDE WRITTEN NOTIFICATION SHOULD THE "RESPONSIBLE LAND DISTURBER" CHANGE DURING CONSTRUCTION.

41. THE CONTRACTOR WILL IMMEDIATELY REPAIR OR REPLACE CHANNEL STABILIZATION BLANKETS AND EROSION CONTROL MATTINGS IF SITEWORK OR ASSOCIATED UTILITY OPERATIONS SUCH AS CABLE, ELECTRIC, GAS, PHONE, SEWER, WATER, ETC. DAMAGE THEIR FUNCTIONAL INTENT.

42. CONSTRUCTION OF BMP #1.3 AS A SEDIMENT BASIN AND CLEARING WITHIN THE BMP #1.3 DRAINAGE AREA MAY NOT COMMENCE UNTIL IMPROVEMENTS TO THE THE OUTFALL AND WHITEHALL POND 1-2 MODIFICATIONS (SP-046-07) ARE COMPLETED.

OWNER INFORMATION

HHUNT COMMUNITIES
DANIEL B. MASON
11237 NUCKOLS ROAD
GLEN ALLEN, VIRGINIA 23059
PHONE: 804.762.4800
FAX: 804.762.9769

SITE DATA:


TAX MAP PARCEL ID. (12-2)(1-14A)
ZONING: R-2 CLUSTER OVERLAY (WITH PROFFERS)
PROJECT AREA: 45.10 ACRES / 1964714 S.F.
DISTURBED AREA: 46.33 ACRES / 2018317 S.F.
IMPERVIOUS COVER: 22.52 ACRES / 980971 S.F.
NET DEVELOPABLE AREA: 45.10 ACRES / 1964556 S.F.
FLOOD HAZARD MAP: FEMA PANEL NUMBER 510201 0010 B - ZONE X
AREA DETERMINED TO BE OUTSIDE THE 500-YEAR FLOOD-PLAIN.
THIS SITE IS SITUATED WITHIN THE WARE CREEK WATERSHED

SURVEY DATUM: JCC GEODETIC MONUMENTS
NAD83-VIRGINIA STATE PLANE COORDINATES SOUTH ZONE

AREA TYPE	SECTION 2 JCC# SP-144-06/S-98-06	PERCENT OF SITE
SUBDIVIDED AREA:	45.10 ACRES / 1964714 S.F.	100%
IMPERVIOUS AREA:	22.52 ACRES / 980971 S.F.	49.9%
DISTURBED AREA:	46.33 ACRES / 2018317 S.F.	
NET DEVELOPABLE AREA:	45.10 ACRES / 1964556 S.F.	100%
SINGLE FAM. DETACHED:	127 UNITS	
SINGLE FAM. ATTACHED:	15 UNITS	
TOTAL UNITS:	142 UNITS	

7	10/06/16	ALLEY RECORD DRAWINGS	TM	PCJ
6	03/24/16	REVISED BMP 1.3 SEDIMENT FOREBAY ELEV. CALLOUTS	ABS	ABS
5	10/28/08	AMENDMENT #1	ABS	ABS
4	02/29/08	REVISED PER JAMES CITY COUNTY COMMENTS	ABS	ABS
3	12/19/07	REVISED PER JAMES CITY COUNTY COMMENTS	RDS	ABS
2	9/21/07	REVISED PER JAMES CITY COUNTY COMMENTS	RDS	ABS
1	4/3/07	REVISED PER JAMES CITY COUNTY COMMENTS	RDS	HWP
APPROVAL DATE	No.	DATE	REVISION / COMMENT / NOTE	REVIEWED BY

RECORD DRAWING-10/06/16

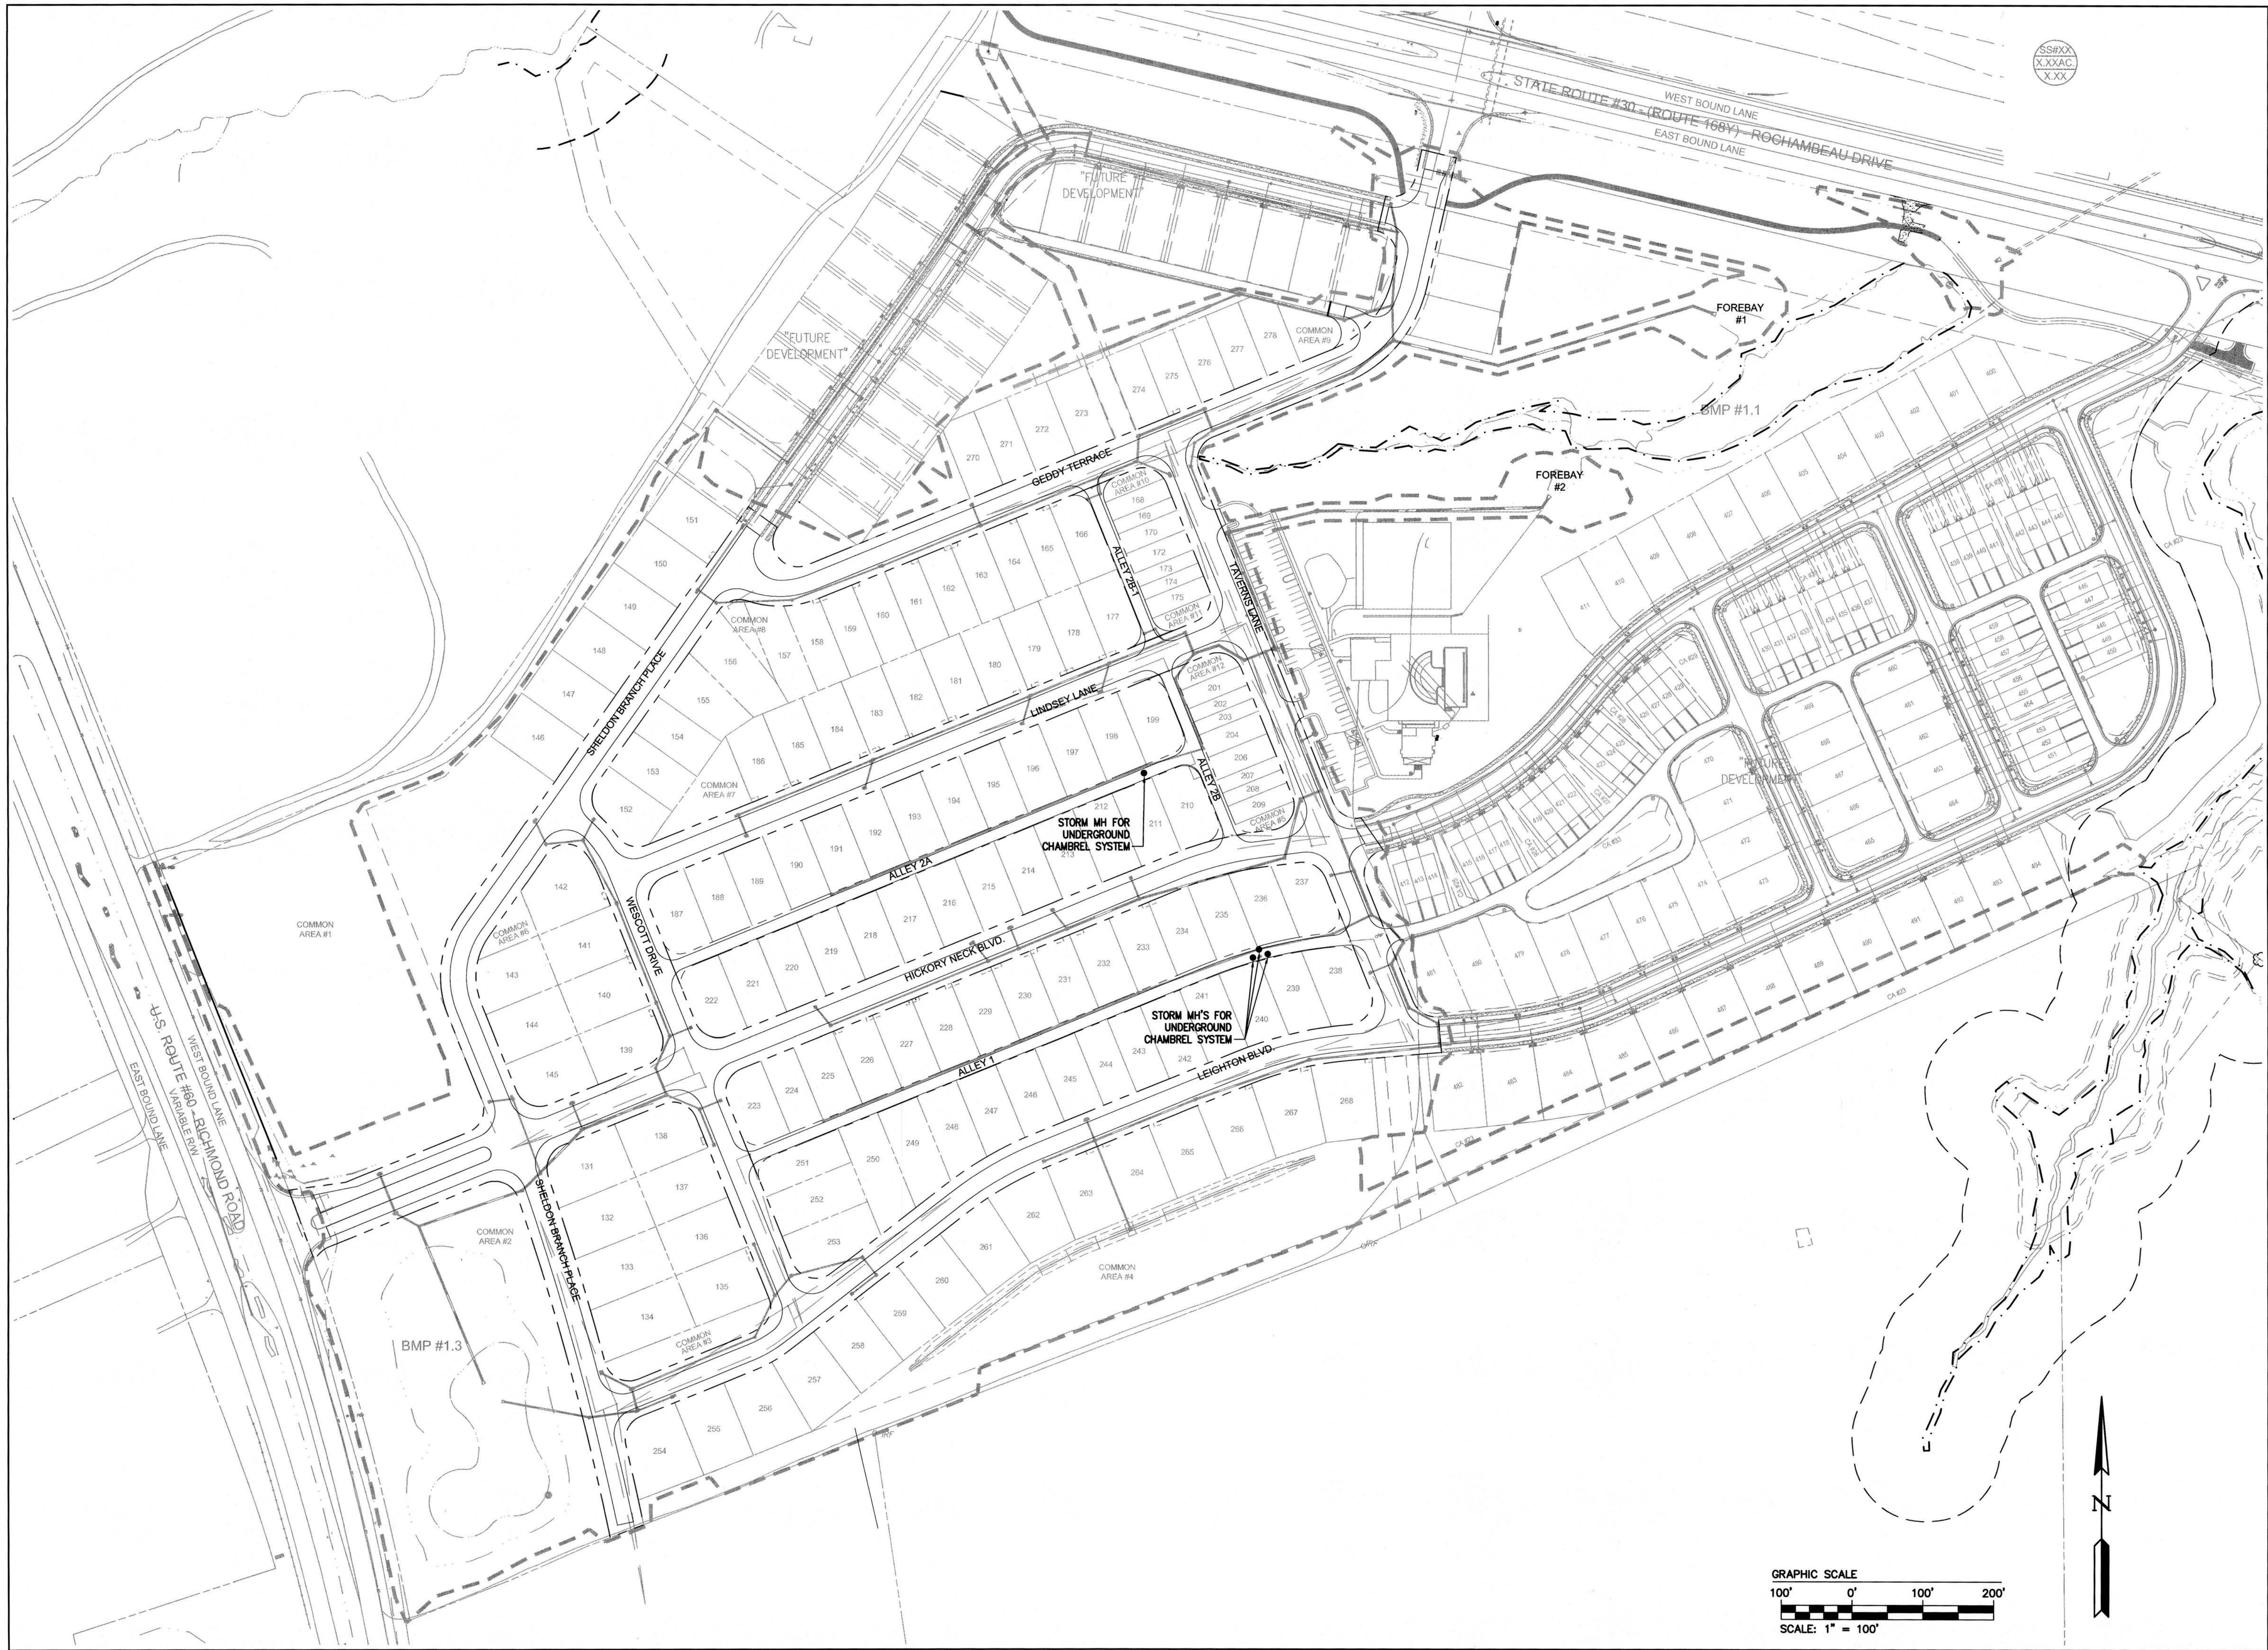

SS#XX
X.XXAC
X.XX

PCJ	ALLEY RECORD DRAWINGS	Rev.	Date
7	REVISED BMP 1.3 SEGMENT FOREBAY ELEV. CALLOUTS	10/24/16	
6	AMENDMENT #1	10/28/08	
5	REVISED PER JAMES CITY COUNTY COMMENTS	10/29/08	
4	REVISED PER JAMES CITY COUNTY COMMENTS	12/19/07	
3	REVISED PER JAMES CITY COUNTY COMMENTS	9/21/07	
2	REVISED PER JAMES CITY COUNTY COMMENTS	4/23/07	
1	REVISED PER JAMES CITY COUNTY COMMENTS		



"THE AS-BUILT LOCATIONS AND GRADES SHOWN ON THESE RECORD DRAWINGS ARE THE BEST OF MY KNOWLEDGE AND BELIEF AND I, THE AGENT, HAVE MADE SUFFICIENT INSPECTION TO ENSURE THE ACCURACY OF THIS STATEMENT."



Preston C. Judson
PRESTON C. JUDSON
DATE 10/06/16

5248 Old Towne Road, Suite 1
Williamsburg, Virginia 23188
Phone: (757) 220-8694
Fax: (757) 220-8694
www.aesva.com


AES
CONSULTING ENGINEERS
Hampton Roads | Central Virginia | Middle Peninsula

ALLEY RECORD DRAWINGS FOR
WHITE HALL
STONEHOUSE DISTRICT | JAMES CITY COUNTY | VIRGINIA

Project Contacts:	TRS
Project Number:	W9048-11
Scale:	1"=100'
Date:	10/28/2008
Sheet Title:	RECORD OVERALL DRAINAGE PLAN
Sheet Number:	R18

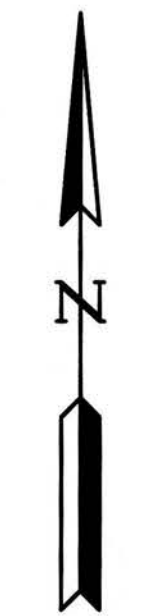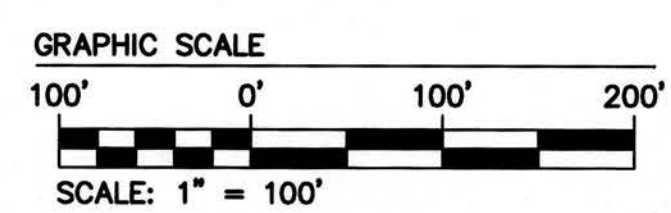

S:\0805\080511-PH1-Singlefamily-Hickory Neck\dwg\Surf\Record\DRW\1202-GRADING-DRAINAGE.dwg, 11/9/2016 8:55:52 AM, System X-Series - Batch 02

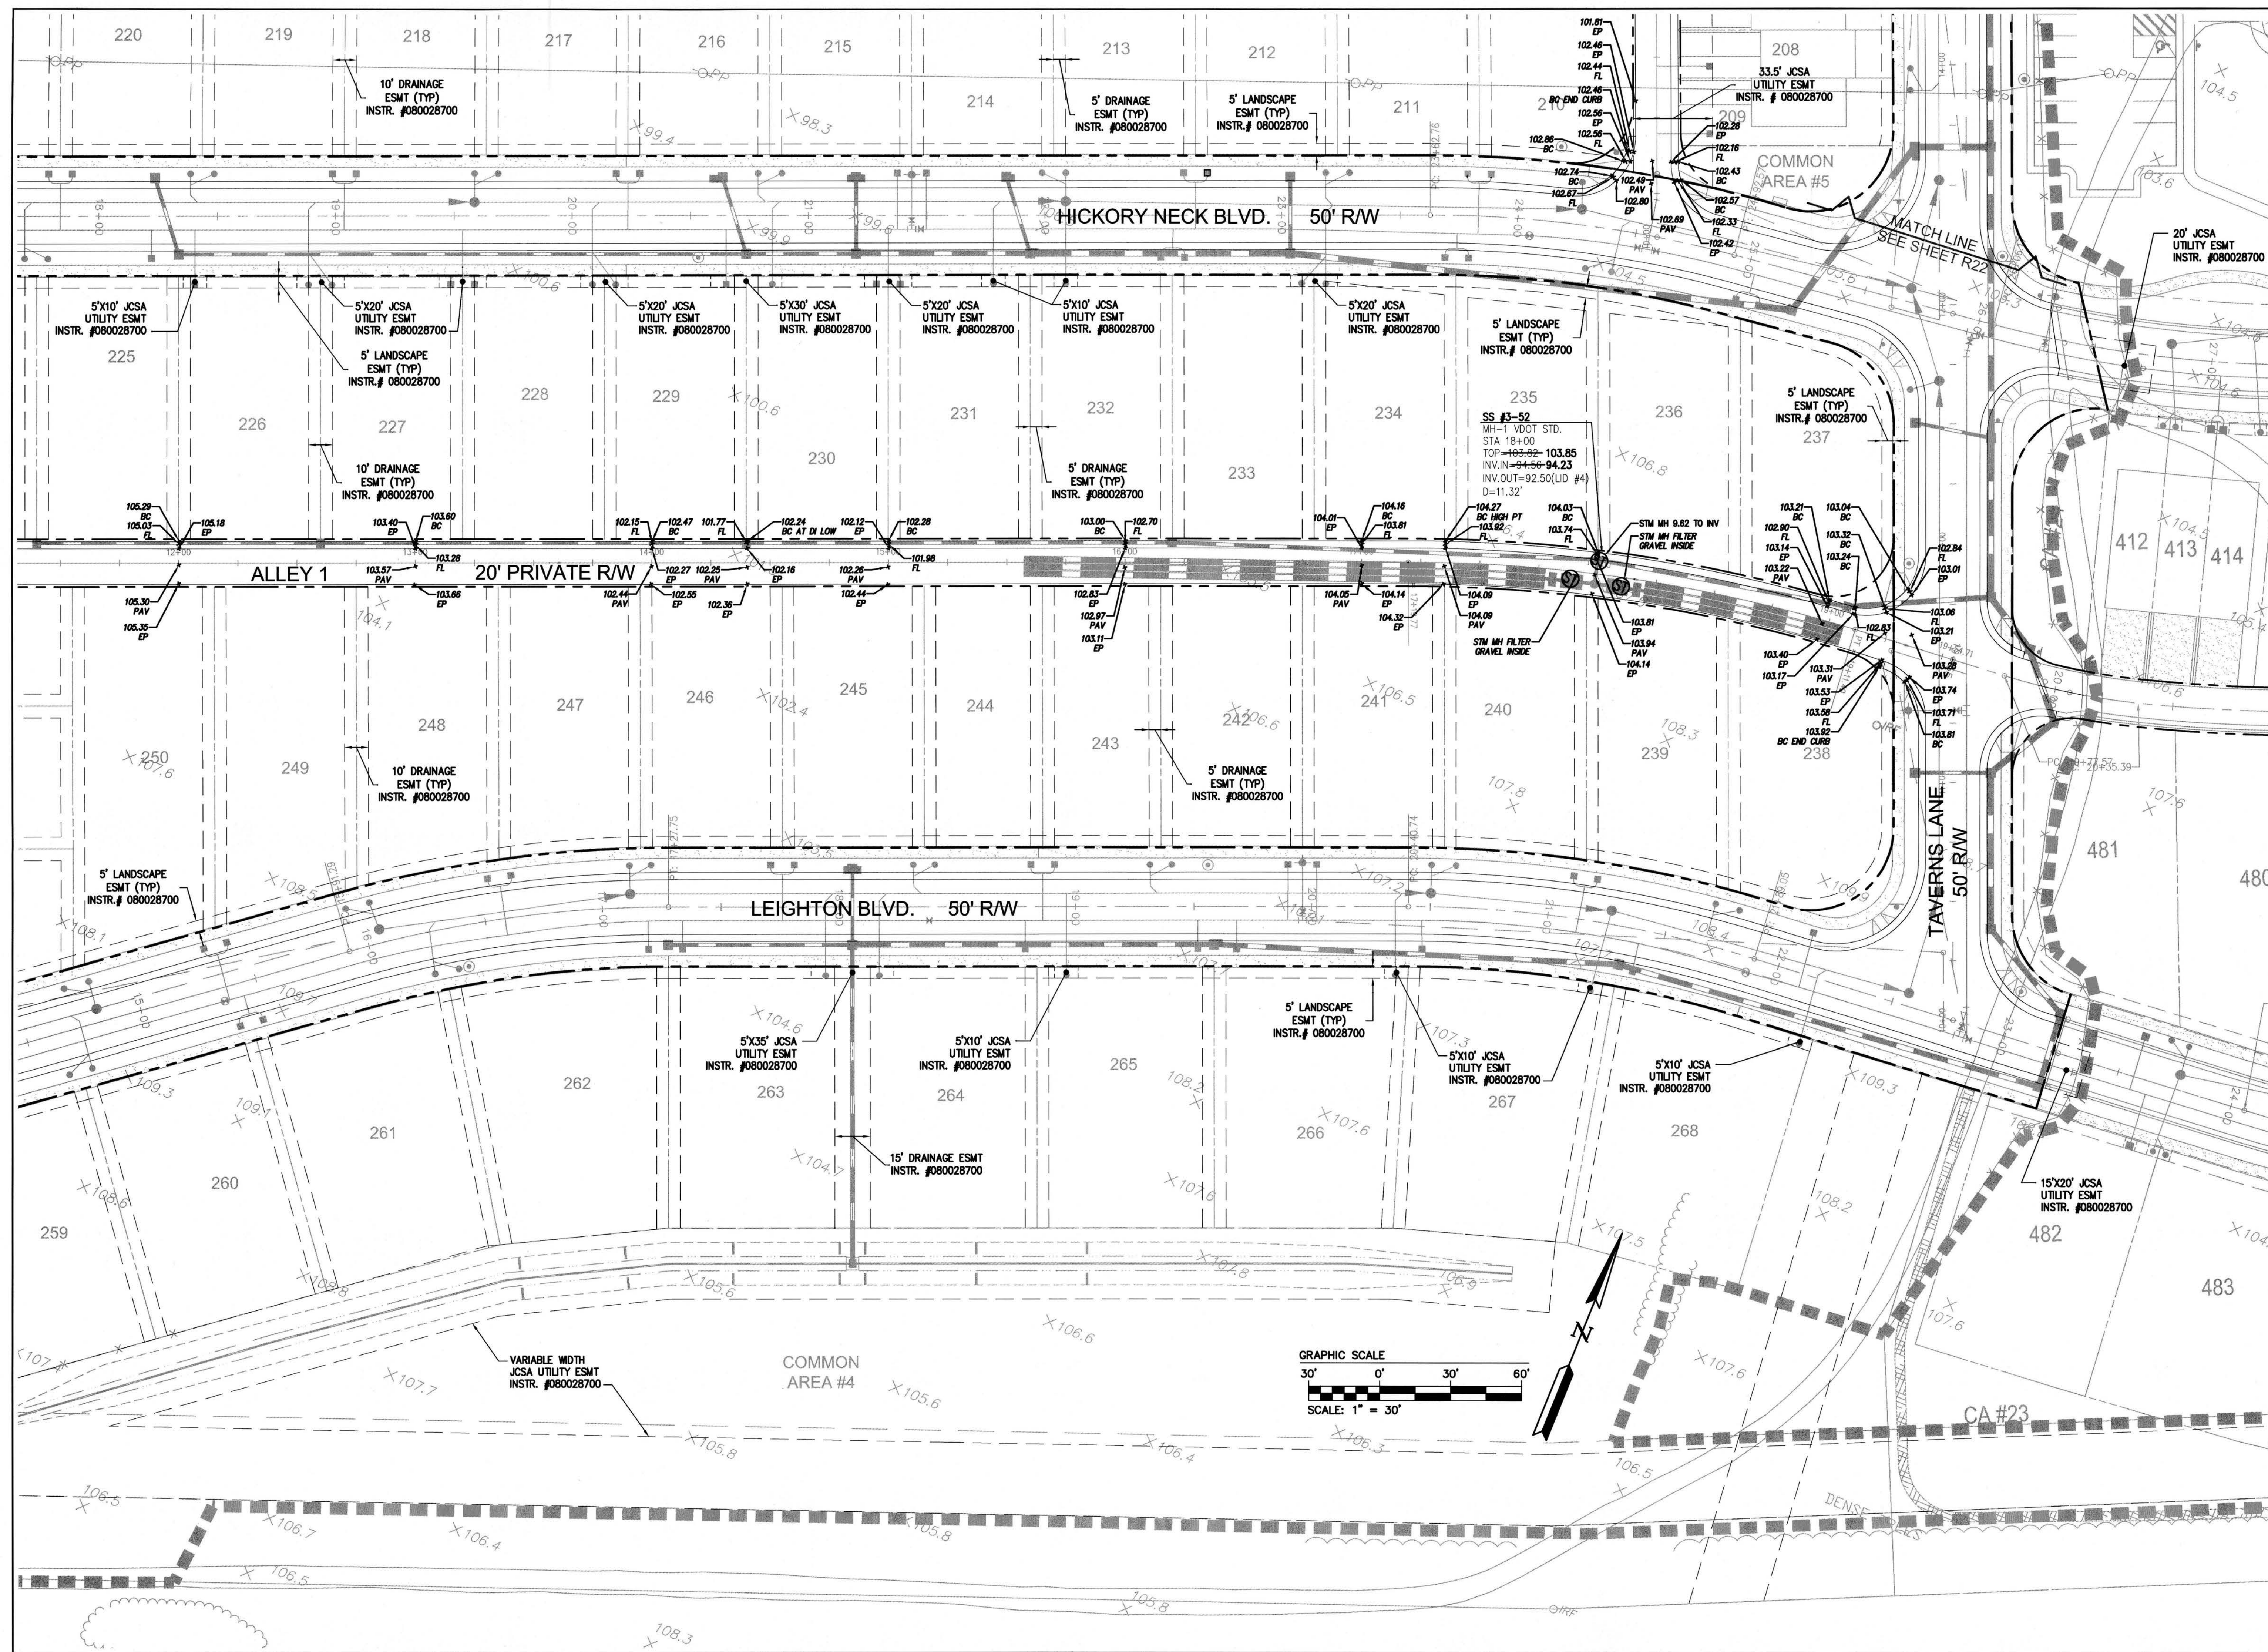

REV	DATE	DESCRIPTION
7	10/06/16	ALLEY RECORD DRAWINGS
6	03/24/16	REVISED DWP 1.5 SEDIMENT FORECAST ELEV. CALCULATIONS
5	10/28/08	ADJUSTMENT #1
4	02/29/08	REVISED PER JAMES CITY COUNTY COMMENTS
3	12/19/07	REVISED PER JAMES CITY COUNTY COMMENTS
2	9/21/07	REVISED PER JAMES CITY COUNTY COMMENTS
1	4/2/07	REVISED PER JAMES CITY COUNTY COMMENTS

DATE: 10/06/16

PRESTON C. JUDSON




THE AS-BUILT LOCATIONS AND GRADES SHOWN ON THESE DRAWINGS, ARE ACCURATE AND COMPLETE TO THE BEST OF MY KNOWLEDGE AND BELIEF AND I CERTIFY THAT I, OR MY AGENT, HAVE MADE SUFFICIENT INSPECTION TO ENSURE THE ACCURACY OF THIS STATEMENT.

5508 Old Town Road, Suite 111
Williamsburg, Virginia 23188
Phone: (757) 253-0040
Fax: (757) 226-8894
www.ahs.com


AHS
CONSULTING ENGINEERS
Hampton Roads | Central Virginia | Middle Peninsula

ALLEY RECORD DRAWINGS FOR
WHITE HALL
STONEHOUSE DISTRICT | JAMES CITY COUNTY | VIRGINIA

Project Contacts: TRS
Project Number: W9048-11
Scale: 1"=30' Date: 10/28/2008
Sheet Title: RECORD GRADING, DRAINAGE, E & SC PLAN
Sheet Number: R20

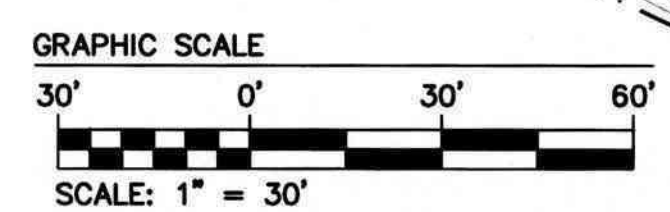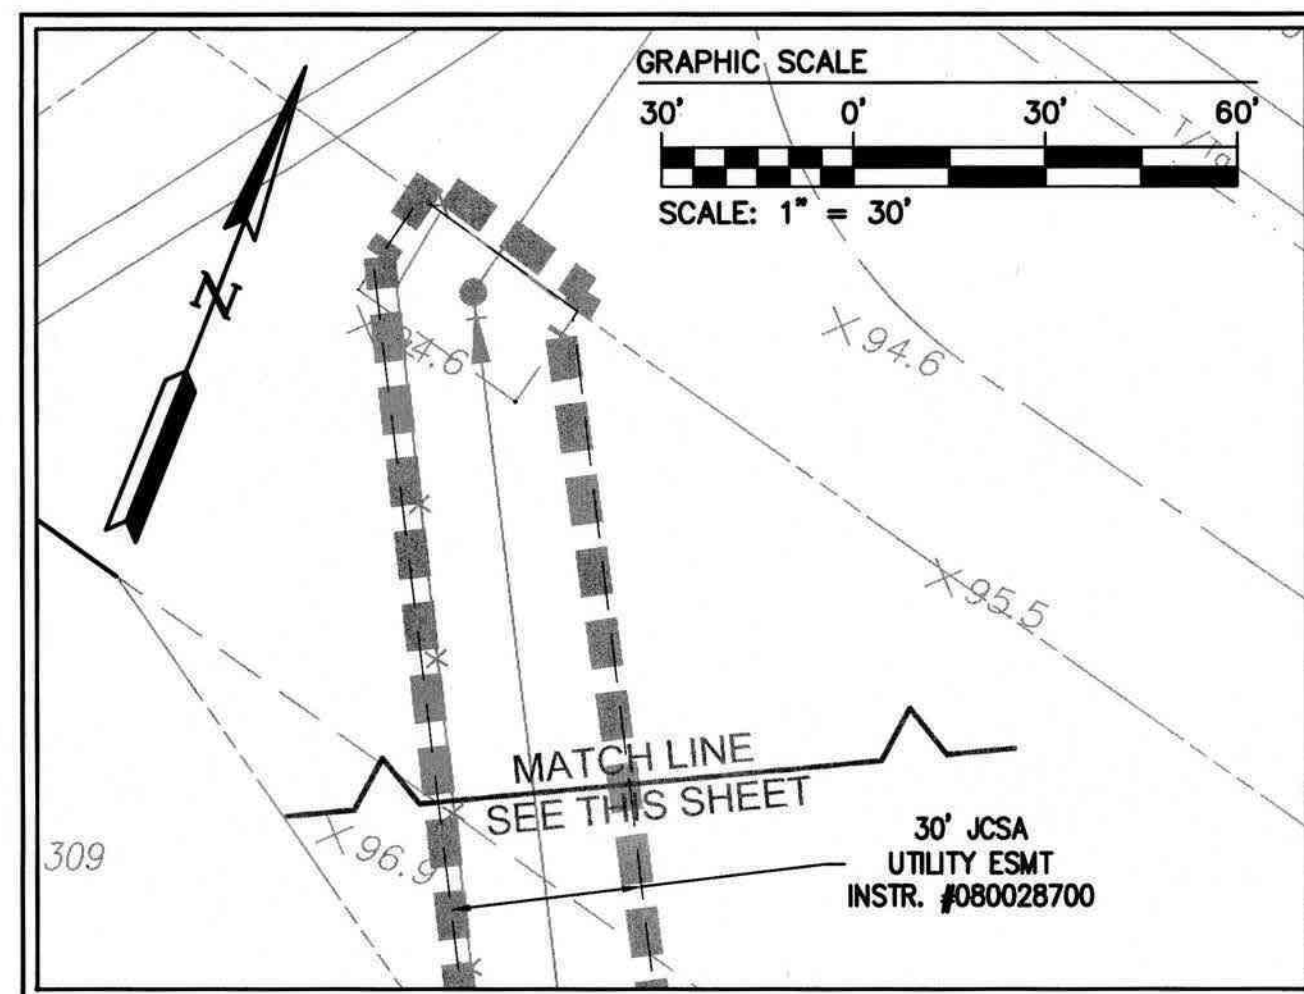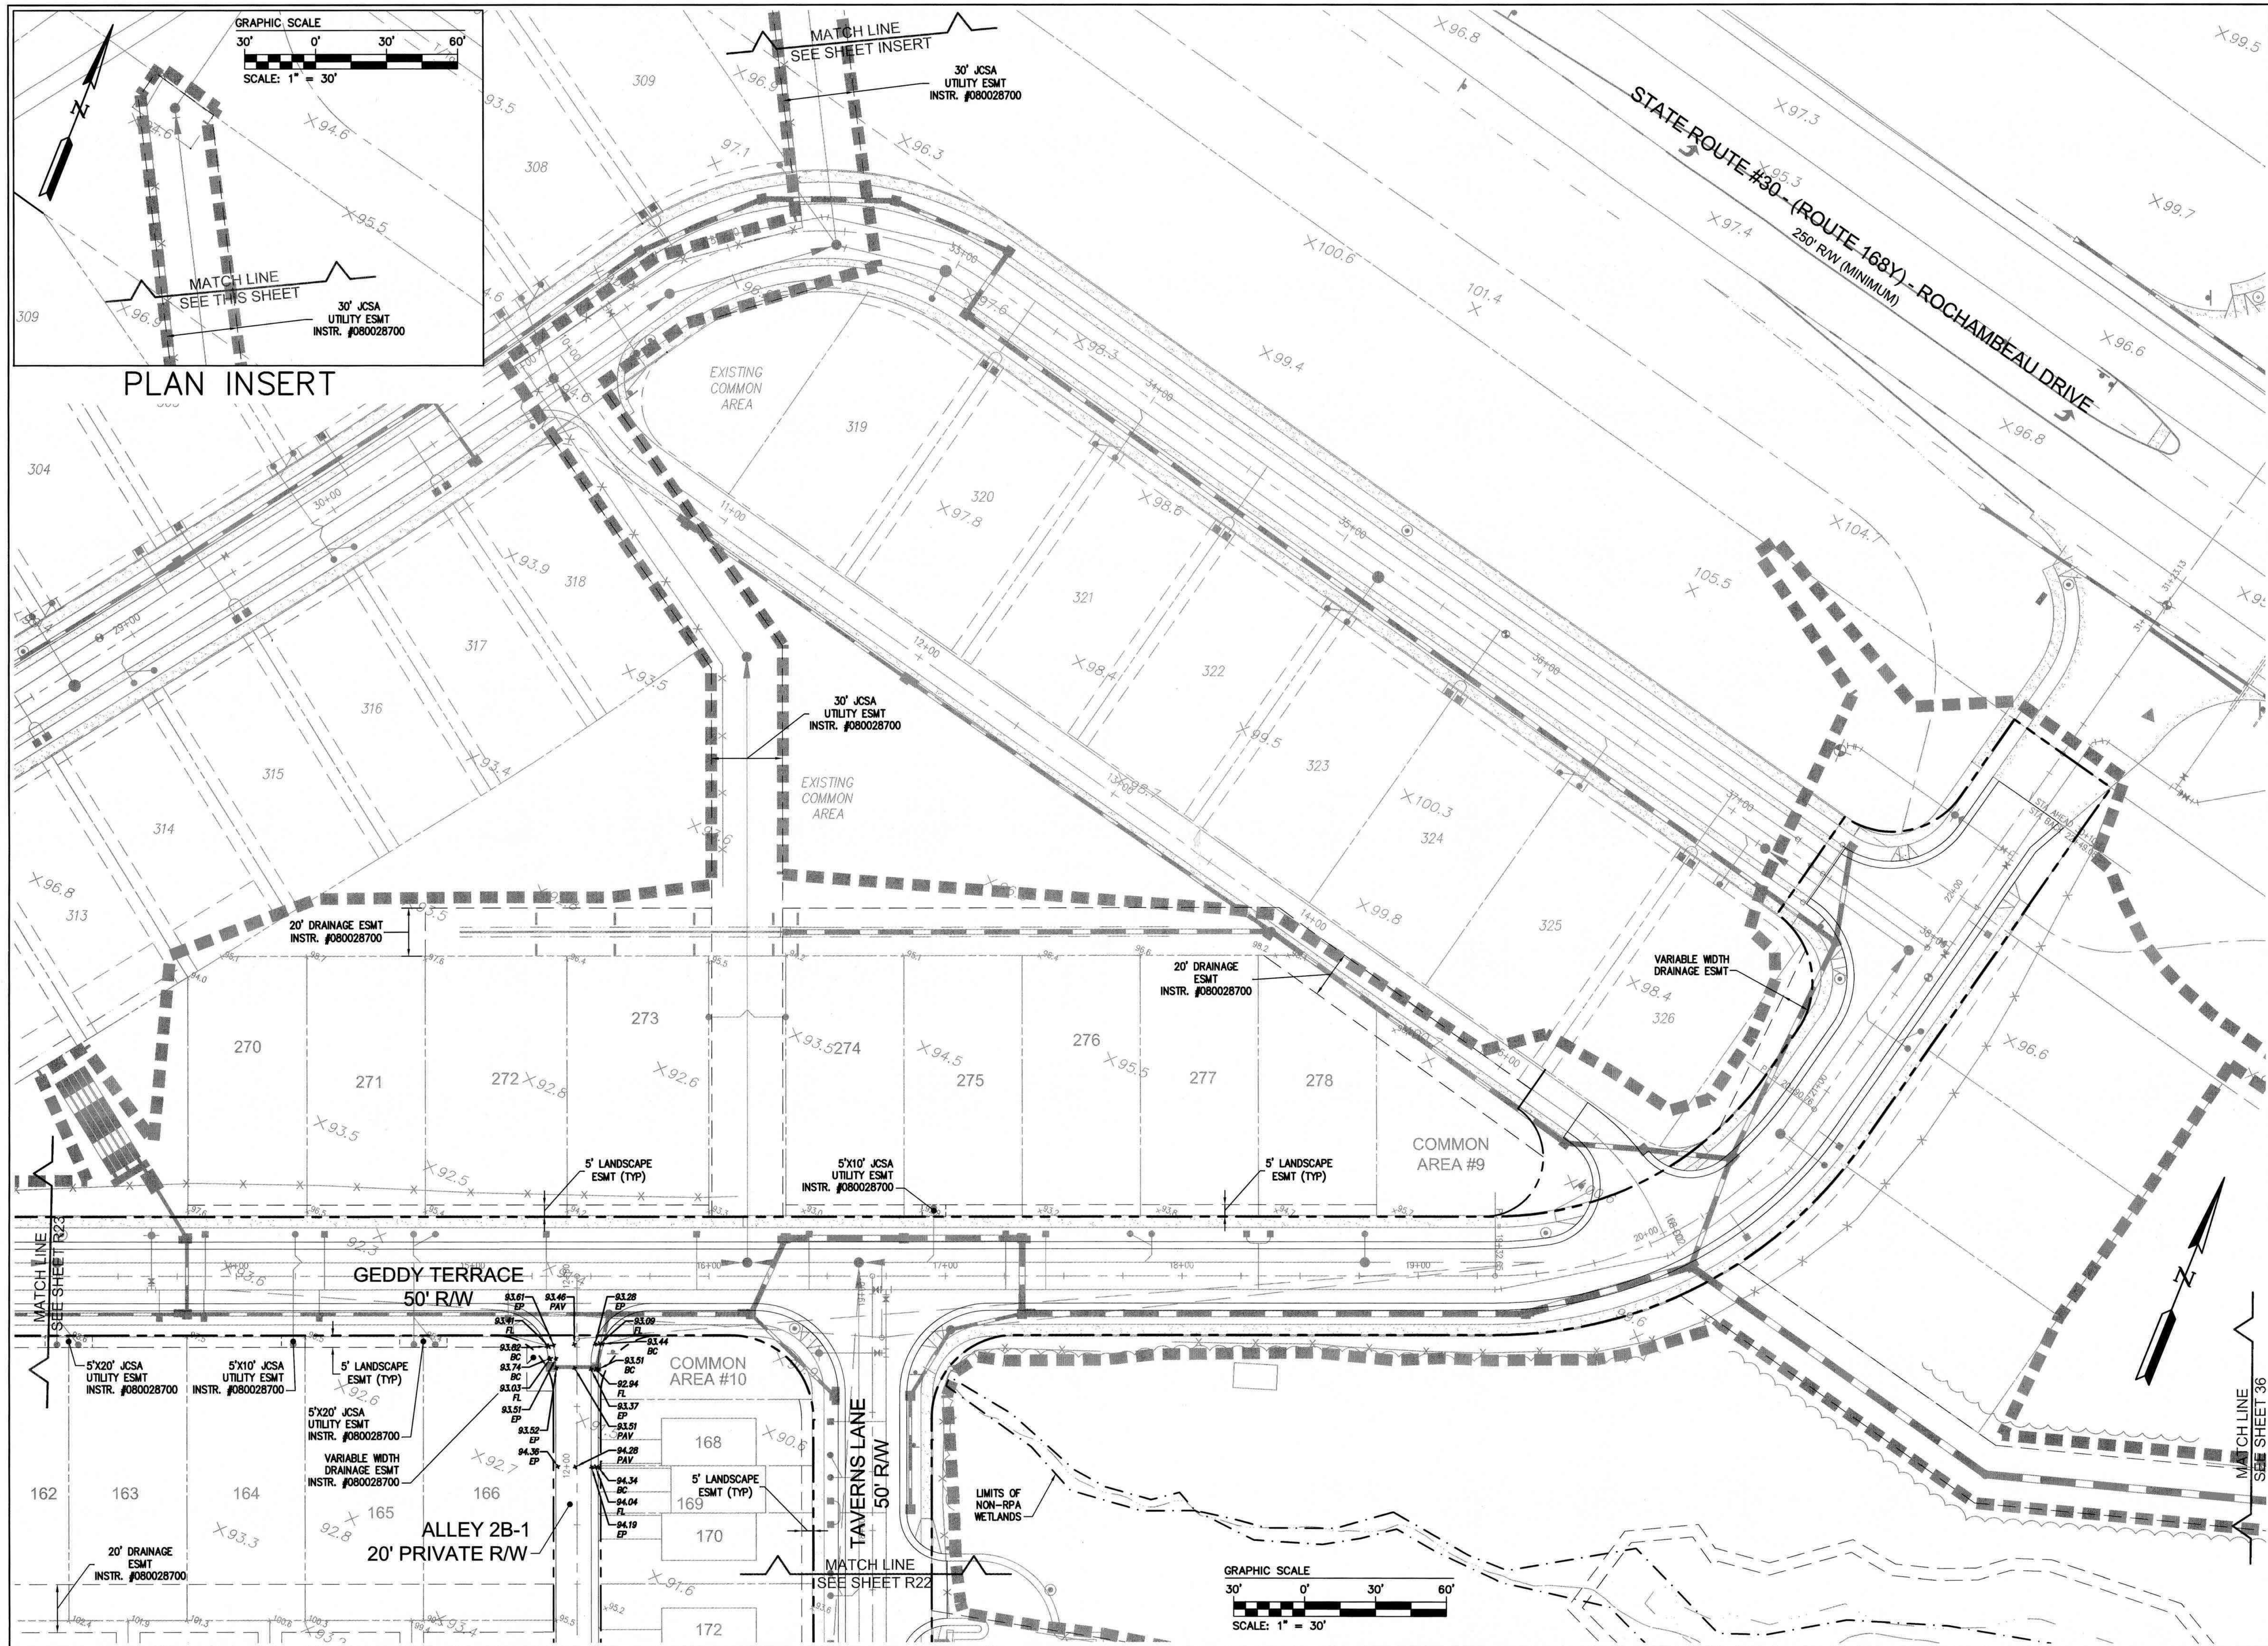

REV	DATE	DESCRIPTION
1	10/06/16	REVISION PER JAMES CITY COUNTY COMMENTS
2	10/06/16	REVISION PER JAMES CITY COUNTY COMMENTS
3	10/06/16	REVISION PER JAMES CITY COUNTY COMMENTS
4	10/06/16	REVISION PER JAMES CITY COUNTY COMMENTS
5	10/06/16	REVISION PER JAMES CITY COUNTY COMMENTS
6	10/06/16	REVISION PER JAMES CITY COUNTY COMMENTS
7	10/06/16	REVISION PER JAMES CITY COUNTY COMMENTS

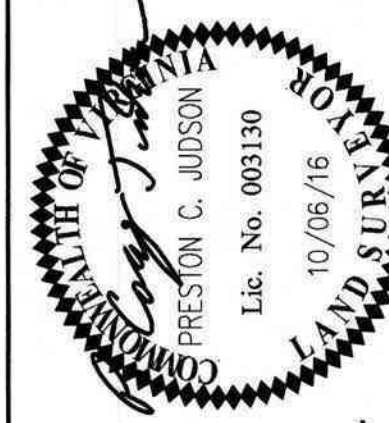

THE AS-BUILT LOCATIONS AND GRADES SHOWN ON THESE DRAWINGS ARE ACCURATE AND COMPLETE TO THE BEST OF MY KNOWLEDGE AND BELIEF. I HAVE MADE AN INSPECTION TO ENSURE THE ACCURACY OF THIS STATEMENT.

Preston C. Juddon
PRESTON C. JUDDON
DATE: 10/06/16

AES
CONSULTING ENGINEERS
Hampton Roads | Central Virginia | Middle Peninsula

5248 Old Towne Road, Suite 1
Williamsburg, Virginia 23188
Phone: (757) 225-8800
Fax: (757) 225-8804
www.aesva.com

ALLEY RECORD DRAWINGS FOR

WHITE HALL

STONEHOUSE DISTRICT | JAMES CITY COUNTY | VIRGINIA

Project Contacts:	TRS
Project Number:	W9048-11
Scale:	1"=30'
Date:	10/28/2008
Sheet Title:	RECORD GRADING, DRAINAGE, E & SC PLAN
Sheet Number:	R24

6. Design Calculations

7. Reports

8. Correspondence



DEVELOPMENT MANAGEMENT

101-A Mounts Bay Road, P.O. Box 8784, Williamsburg, VA 23187-8784

(757) 253-6671

Fax: (757) 253-6850

E-Mail: devman@james-city.va.us

Environmental Division
(757) 253-6670
environ@james-city.va.us

Planning
(757) 253-6685
planning@james-city.va.us

County Engineer
(757) 253-6671

Integrated Pest Management
(757) 259-4116

To: Luke Vinciguerra, Planner
From: Darryl Cook, County Engineer
Re: SP-0144-2006/S-0055-2008, White Hall Section 2 Amendmenet
Date: November 12, 2008

Approved – no comments

Stormwater Facilities Inspection Fee Program

Effective October 1, 2008, the Stormwater Division is beginning a stormwater facilities inspection program. This program requires that for any project issued a land disturbing permit after October 1, 2008, an inspection fee be paid, a preconstruction meeting be held, and a Certificate to Construct be issued to an owner/developer prior to any construction on a stormwater facility, whether it is a conveyance system or a stormwater Best Management Practice (BMP). Prior to release of a project's subdivision surety or issuance of a Certificate of Occupancy, a Construction Certification and Record Drawings (as-builts) of all stormwater facilities must be approved by the Stormwater Division. Contact the Stormwater Division for more information regarding this program.

9. Inspection Records

10. Miscellaneous

(ex. photos)